

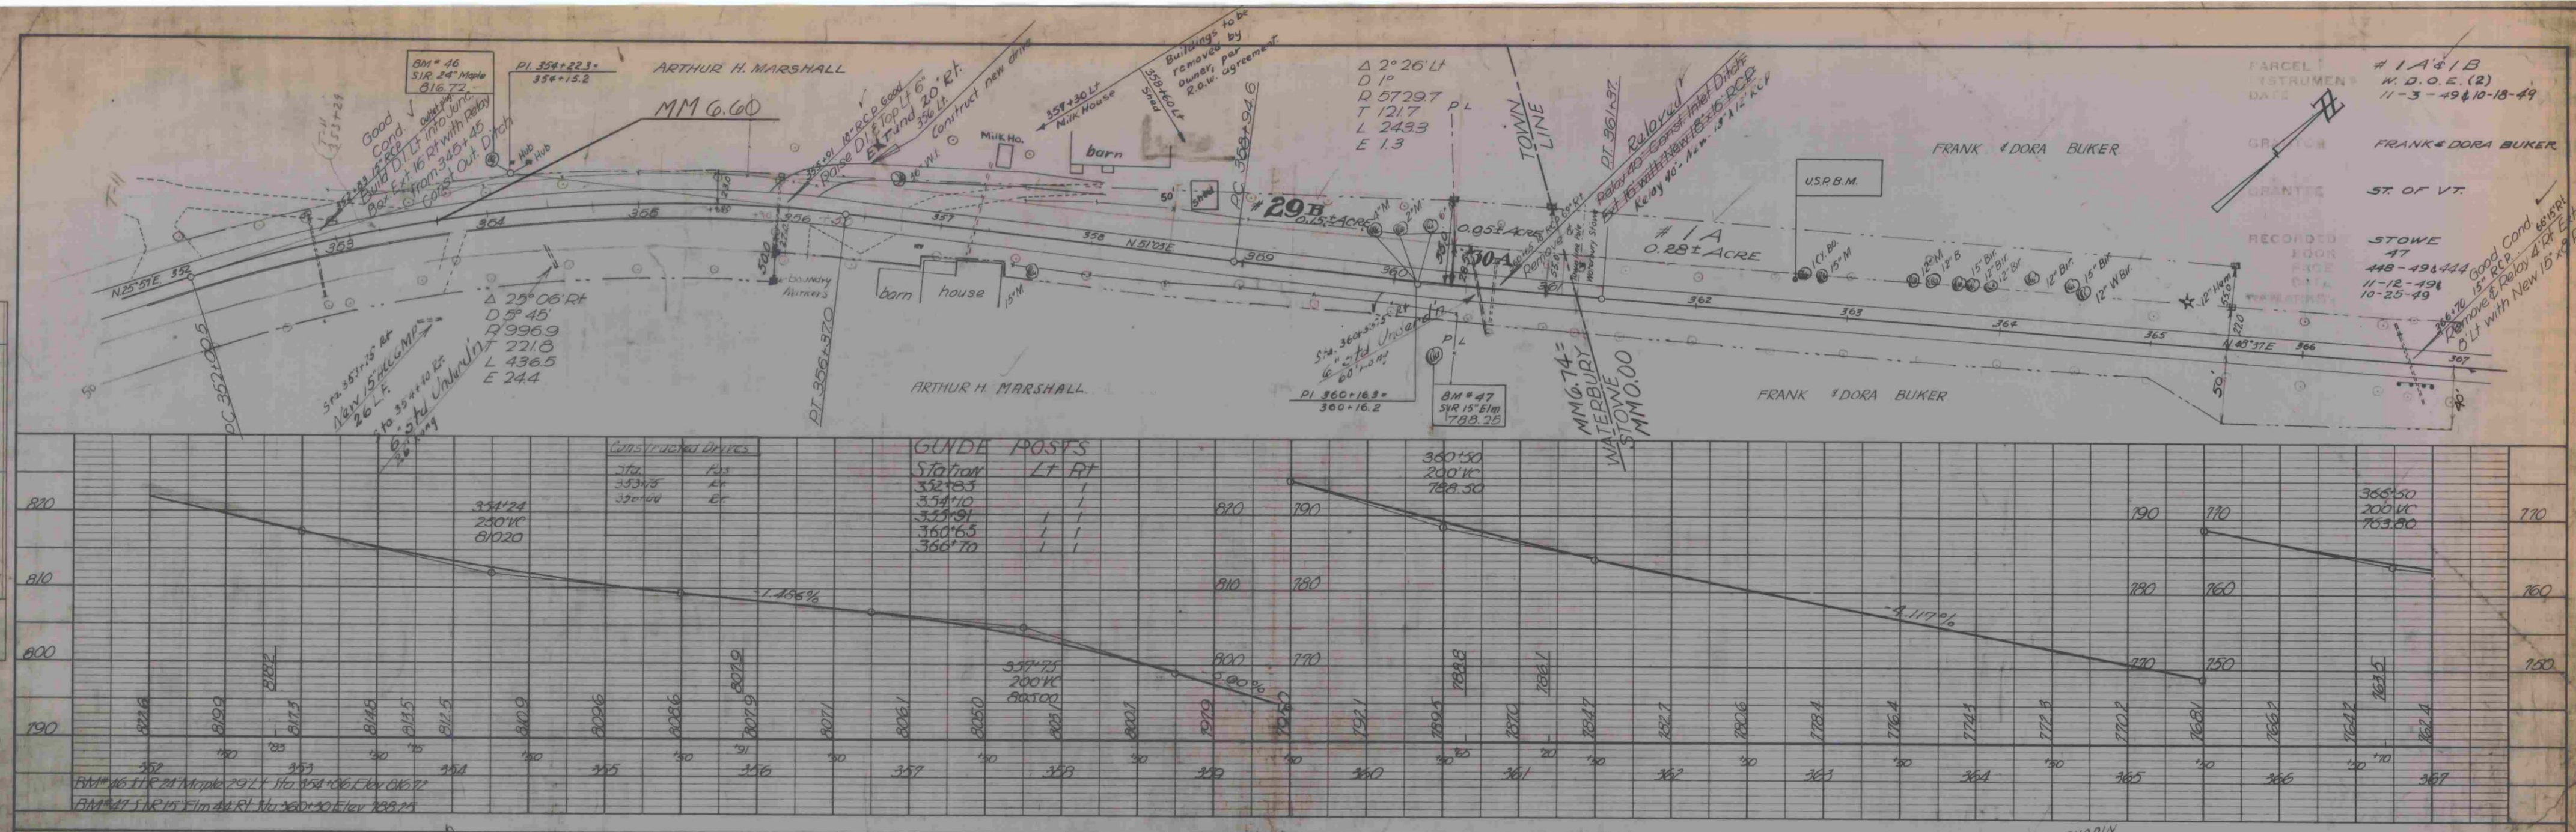


PLAN  
 DATE: \_\_\_\_\_  
 BY: \_\_\_\_\_  
 CHECKED: \_\_\_\_\_  
 NOTE BOOK, ALIGNMENT CHECKED, RT. OF WAY CHECKED.


PROFILE  
 DATE: \_\_\_\_\_  
 BY: \_\_\_\_\_  
 CHECKED: \_\_\_\_\_  
 NOTE BOOK, GRADES CHECKED, STRUCTURE NOTATION CHECKED.

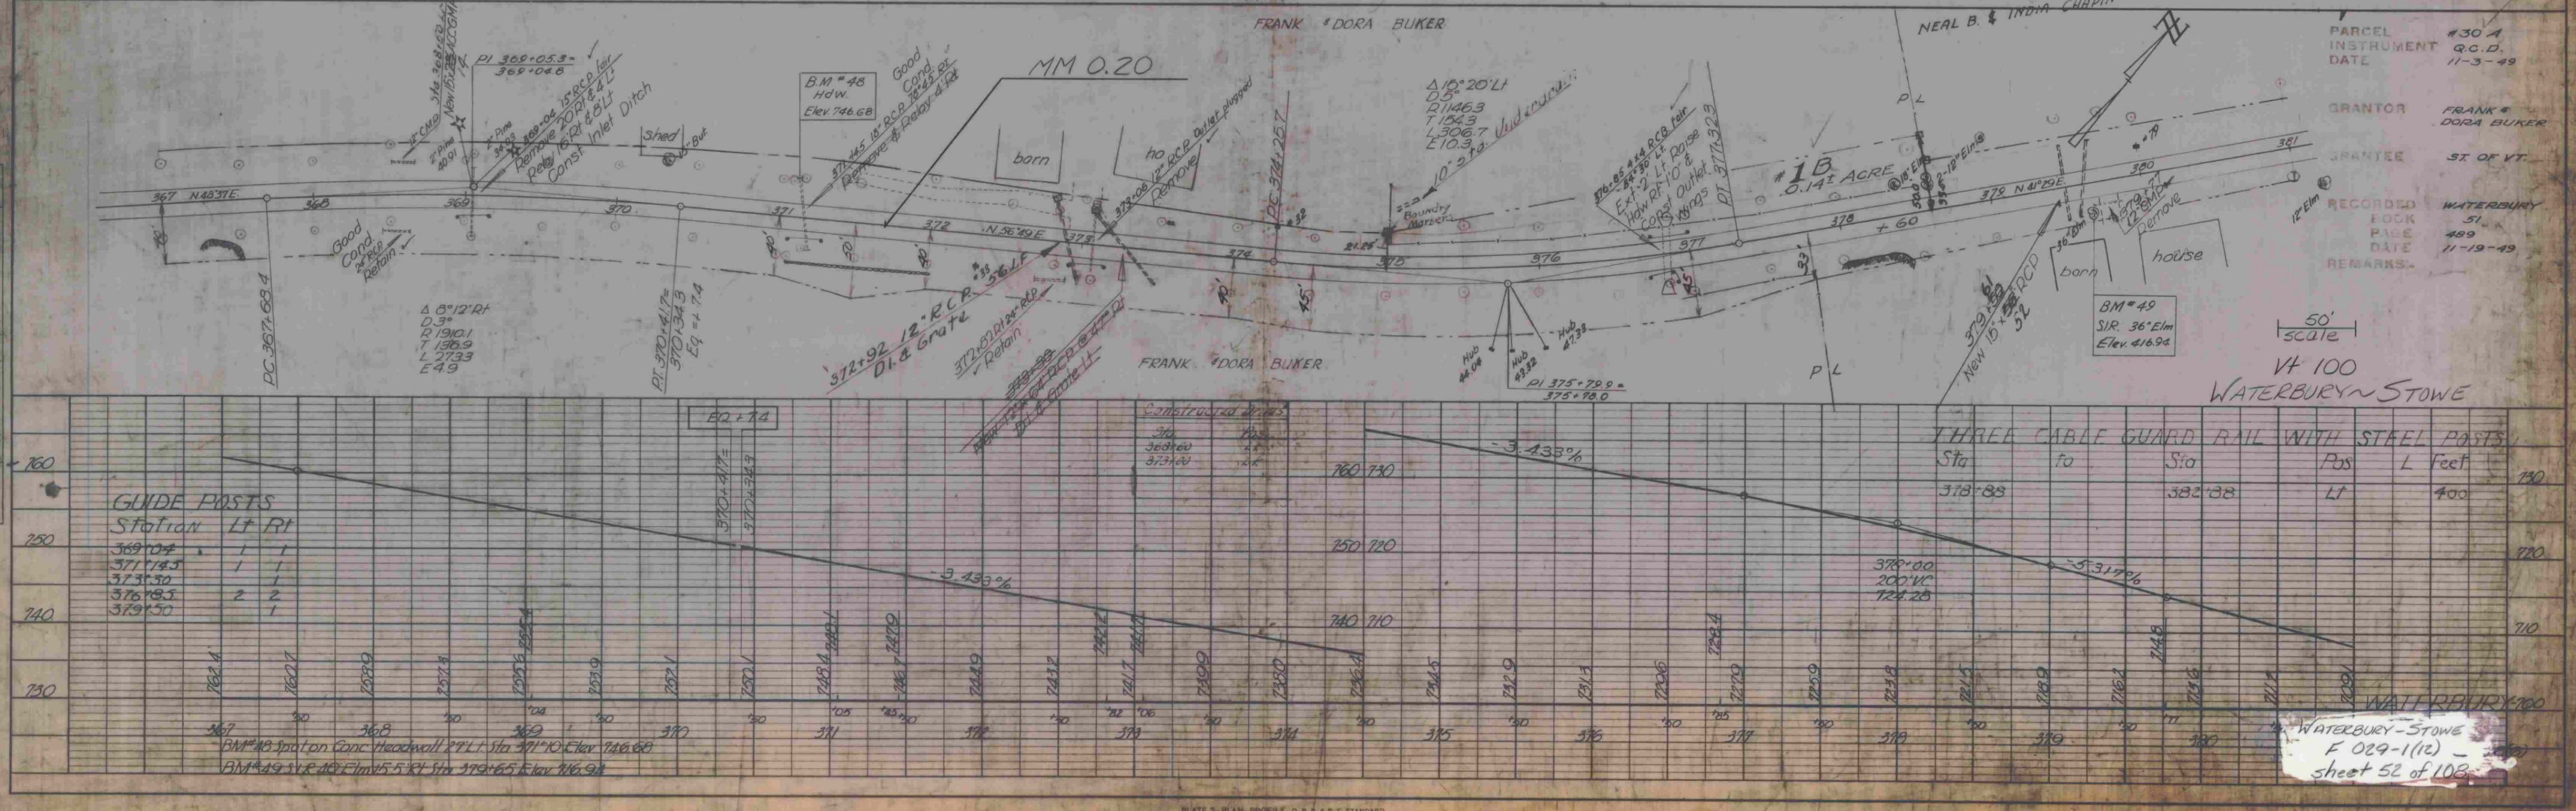

PARCEL # 1A & 1B  
 INSTRUMENT # 11-3-49 & 10-18-49  
 DATE  
 GRANTEE FRANK & DORA BUKER  
 GRANTEE ST. OF VT.  
 RECORDED STOWE  
 BOOK 448-491444  
 PAGE 11-12-49  
 DATE 10-25-49

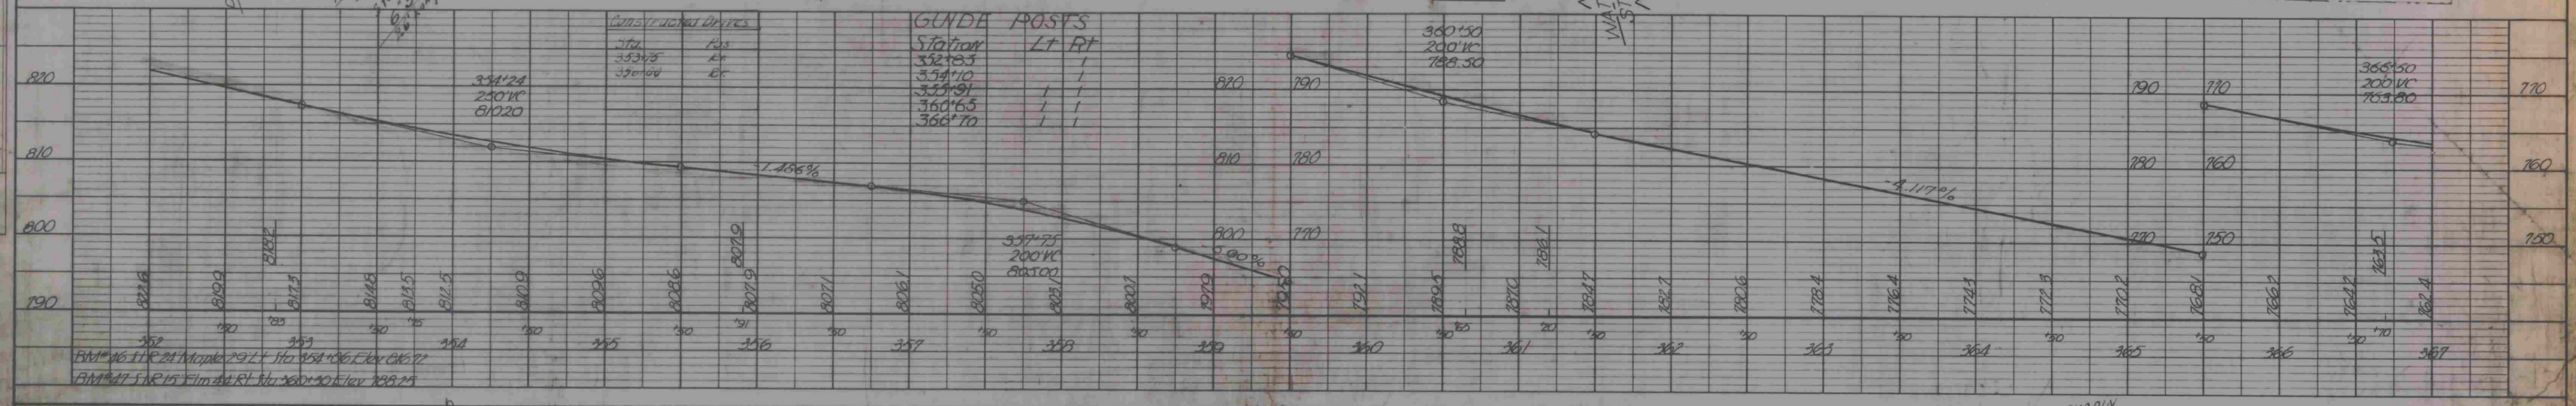

PARCEL # 30 A  
 INSTRUMENT # 11-3-49  
 DATE  
 GRANTEE FRANK & DORA BUKER  
 GRANTEE ST. OF VT.  
 RECORDED WATERBURY  
 BOOK 51  
 PAGE 489  
 DATE 11-19-49

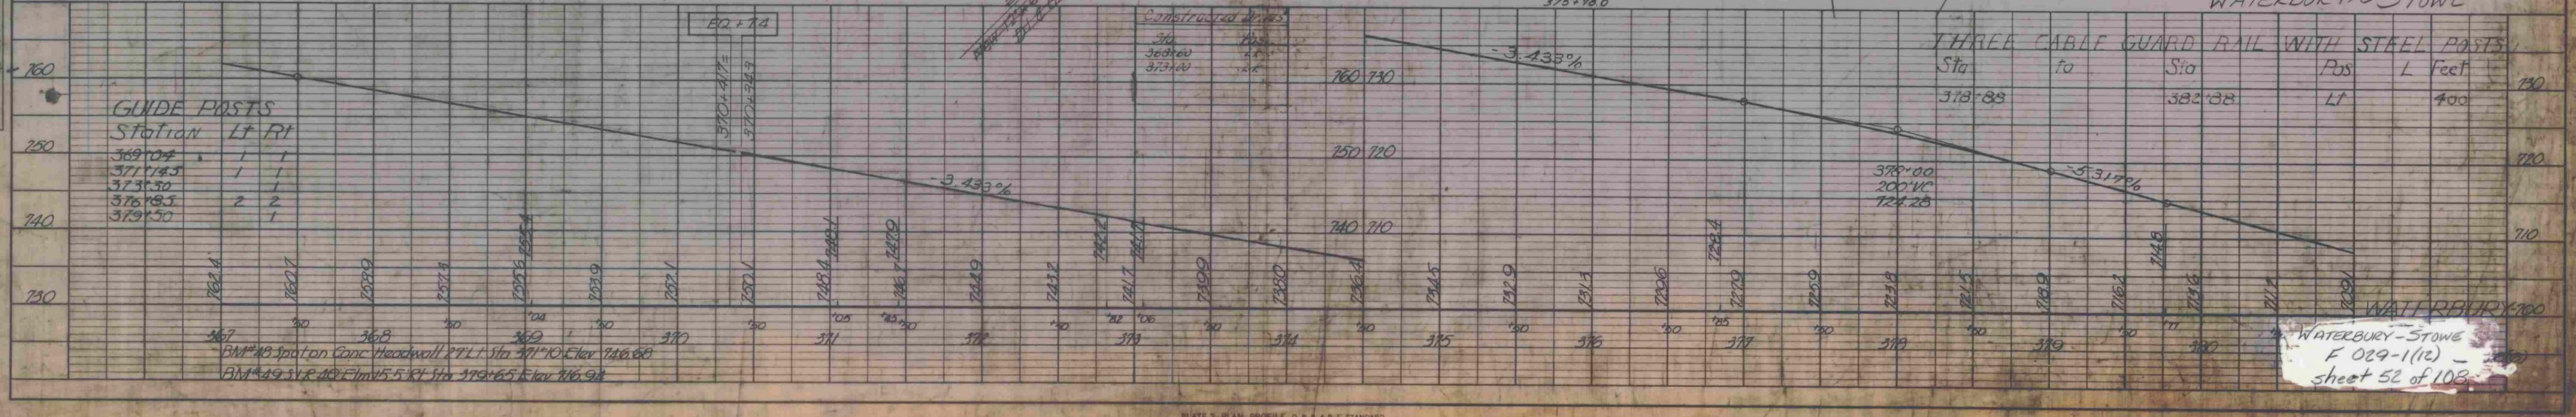

50' SCALE  
 VT 100  
 WATERBURY STONE  
 WATERBURY STONE  
 F 029-1(12)  
 sheet 52 of 108