
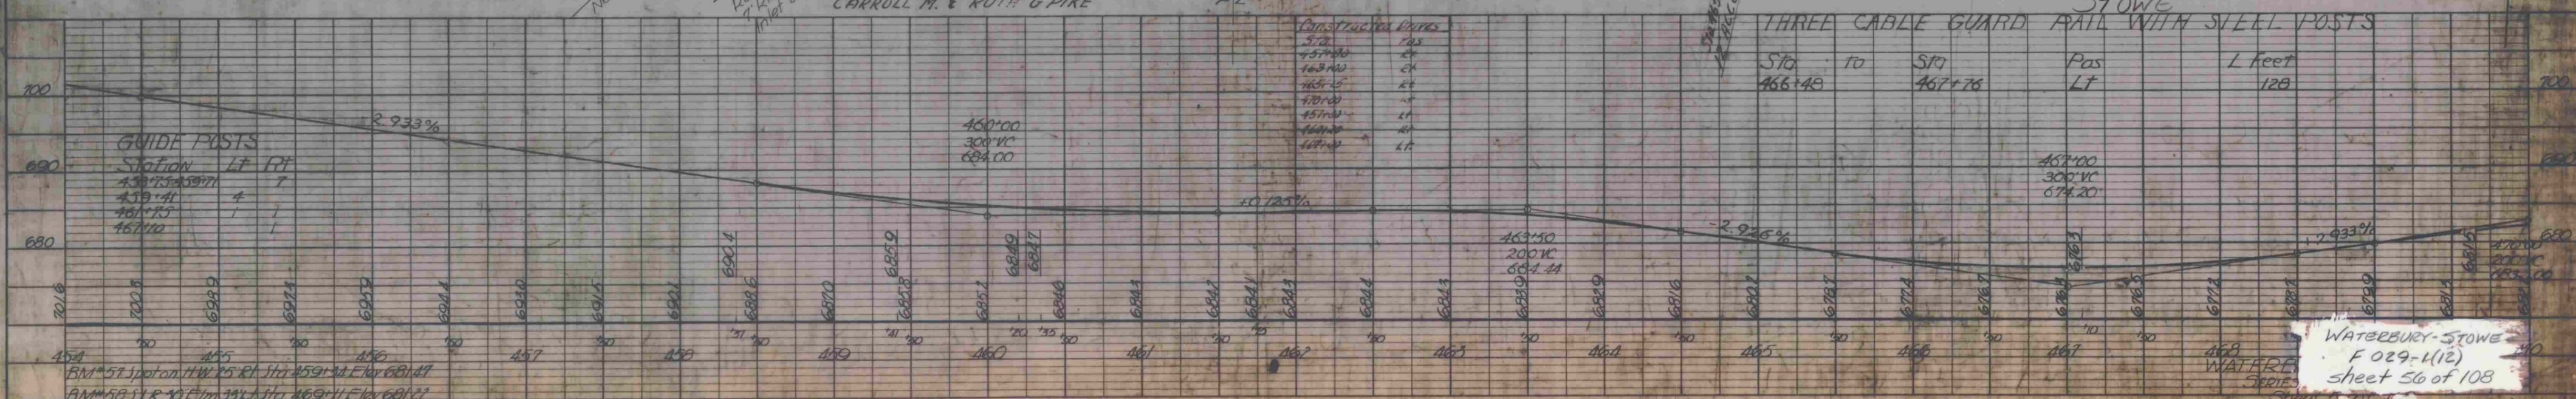
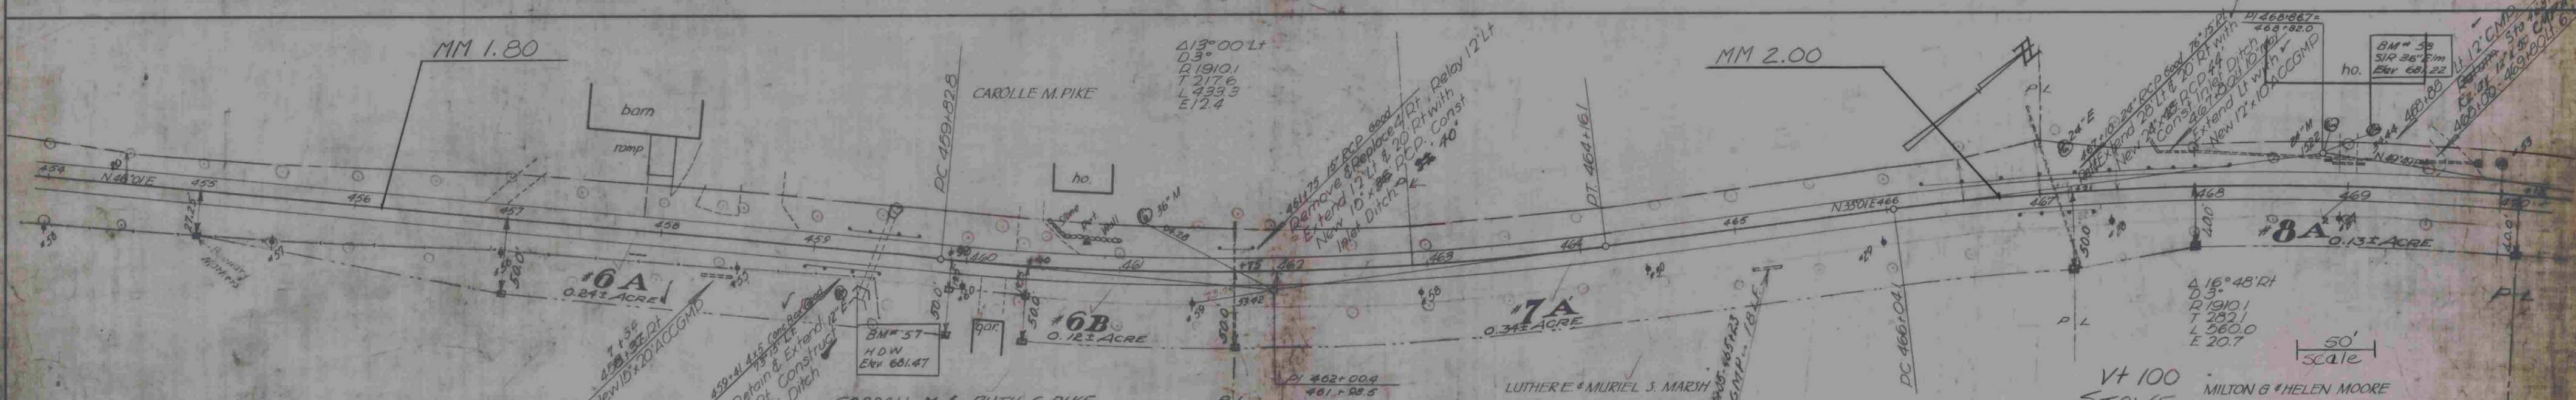
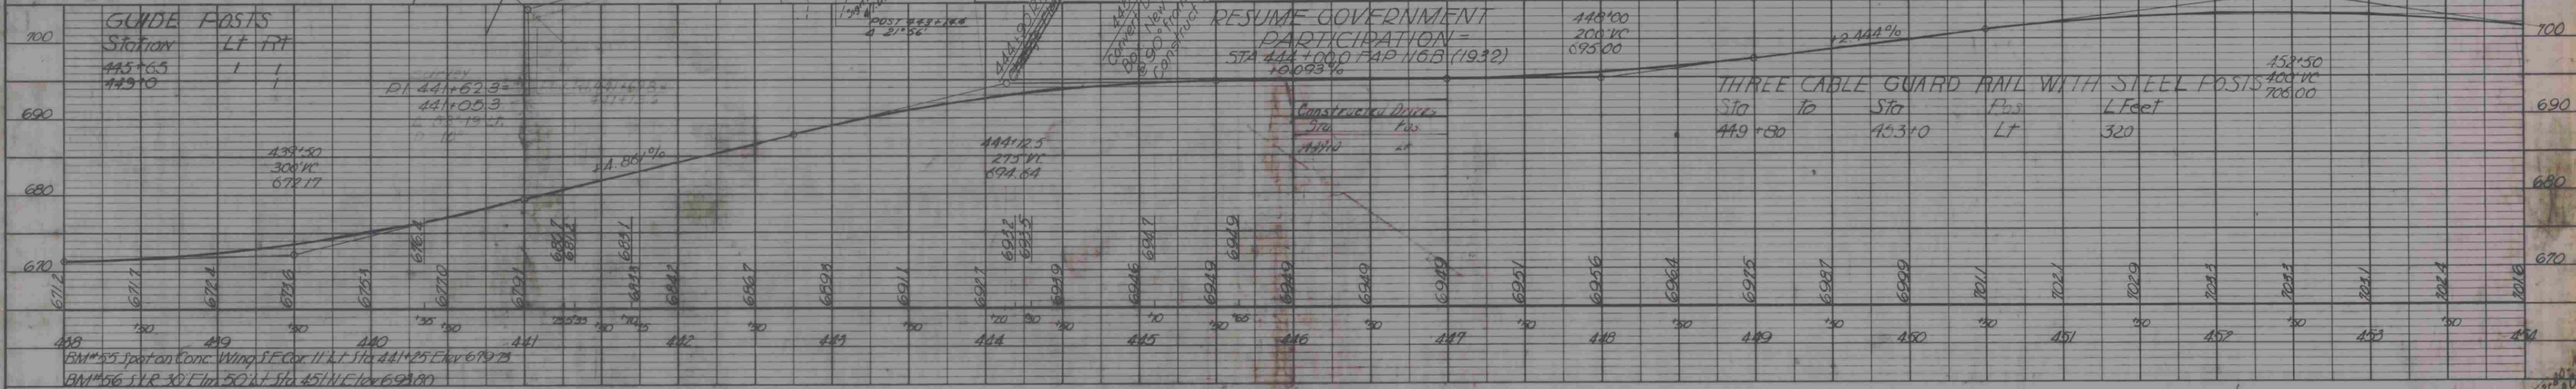


PLAN
 SURVEYED
 NOTE BOOK ALIGNMENT CHECKED
 NO. OF WAY CHECKED

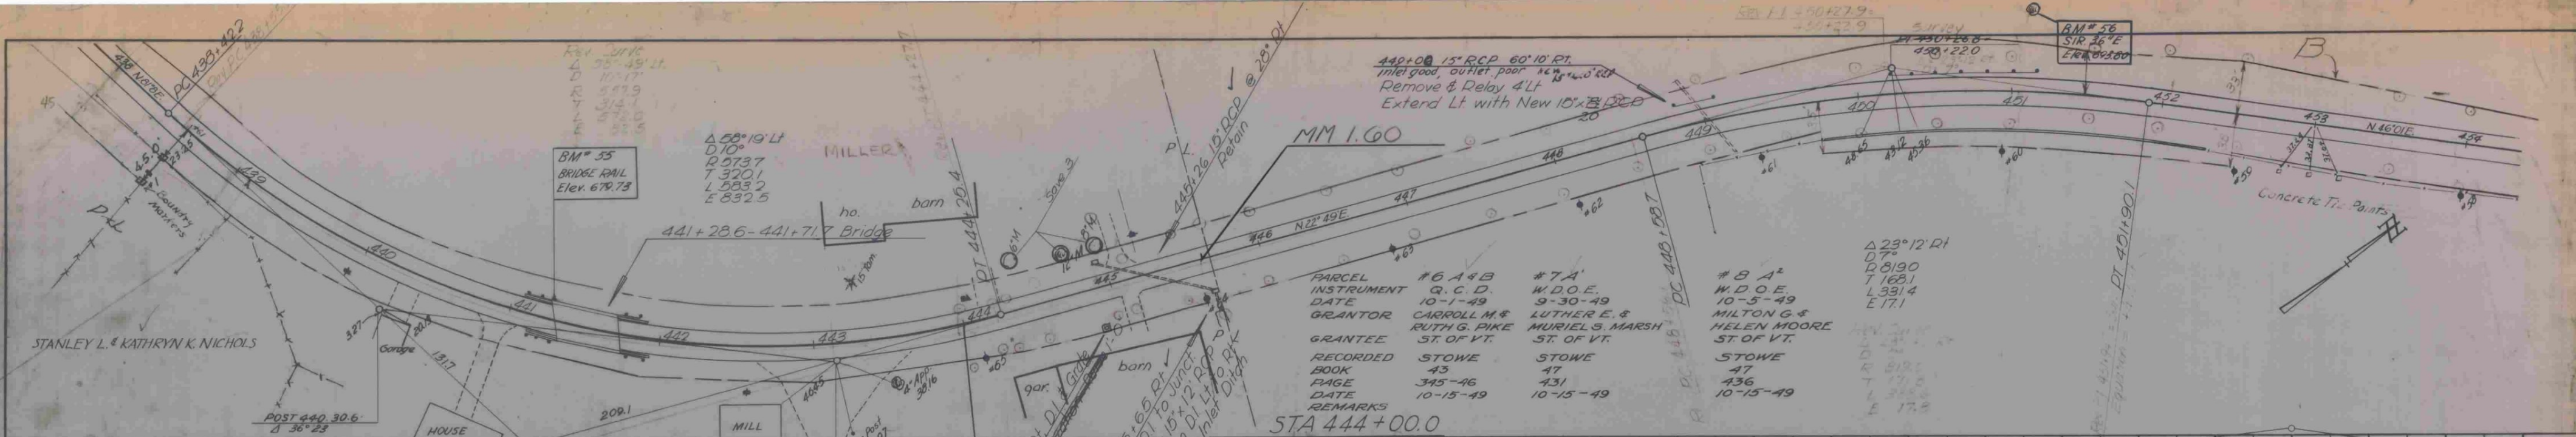

WATERBURY-STOWE
 F 029-1(12)
 sheet 56 of 108