


PARCEL INSTRUMENT DATE GRANTOR GRANTEE RECORDED MORRISTOWN REMARKS
 A, B W.D.O.E. 1-27-41 C.J. & BERTHA GUYETTE ST OF VT BOOK 48 PAGE 286-78 DATE 1-30-41

Sta 607+00 to 608+50 Lt
 Cut slope—sand + silt
 TO BE TOPSOILED + SEEDED

MORRISTOWN
 MM 3.095
 Begin Project
 F 030-2(10)

C.J. Guyette
 pasture

MM 3.20

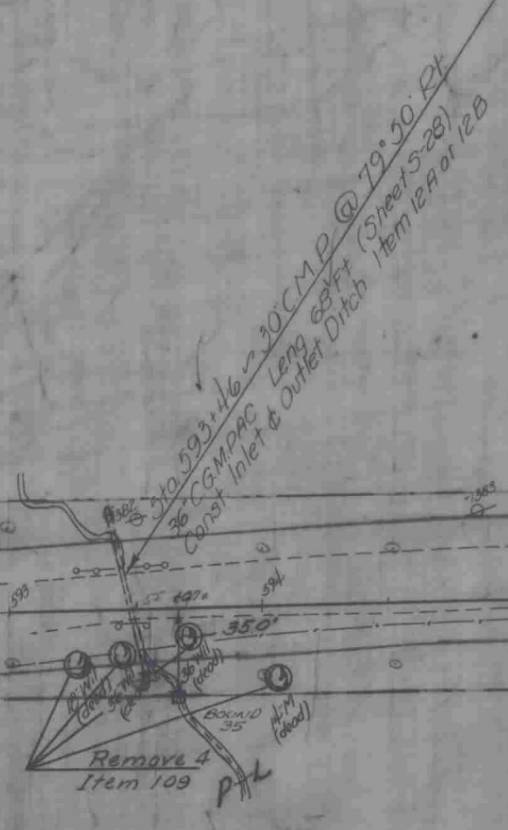

C.J. Guyette
 pasture

595+50-598+50 Rt
 Remove Poor Foundation Material.
 Poor Foundation Material to be used in Flattening
 of slopes as directed by the Engineer.

AM #34
 Spot on Ledge
 665.62


PC 602+93
 Δ 5° 53' RT
 D 1° 30'
 R 3819.0'
 T 199.6'
 L 338.9'
 E 52'

AM #25
 20 Stump
 @ Sta 30

50'
 scale
 VT 15
 MORRISTOWN

Sta 605+00 to 605+50 Rt
 Cut slope—sand + silt
 TO BE SOOLED

Sta 605+50 to 608+50
 Cut slope—sand + silt
 TO BE TOPSOILED + SEEDED

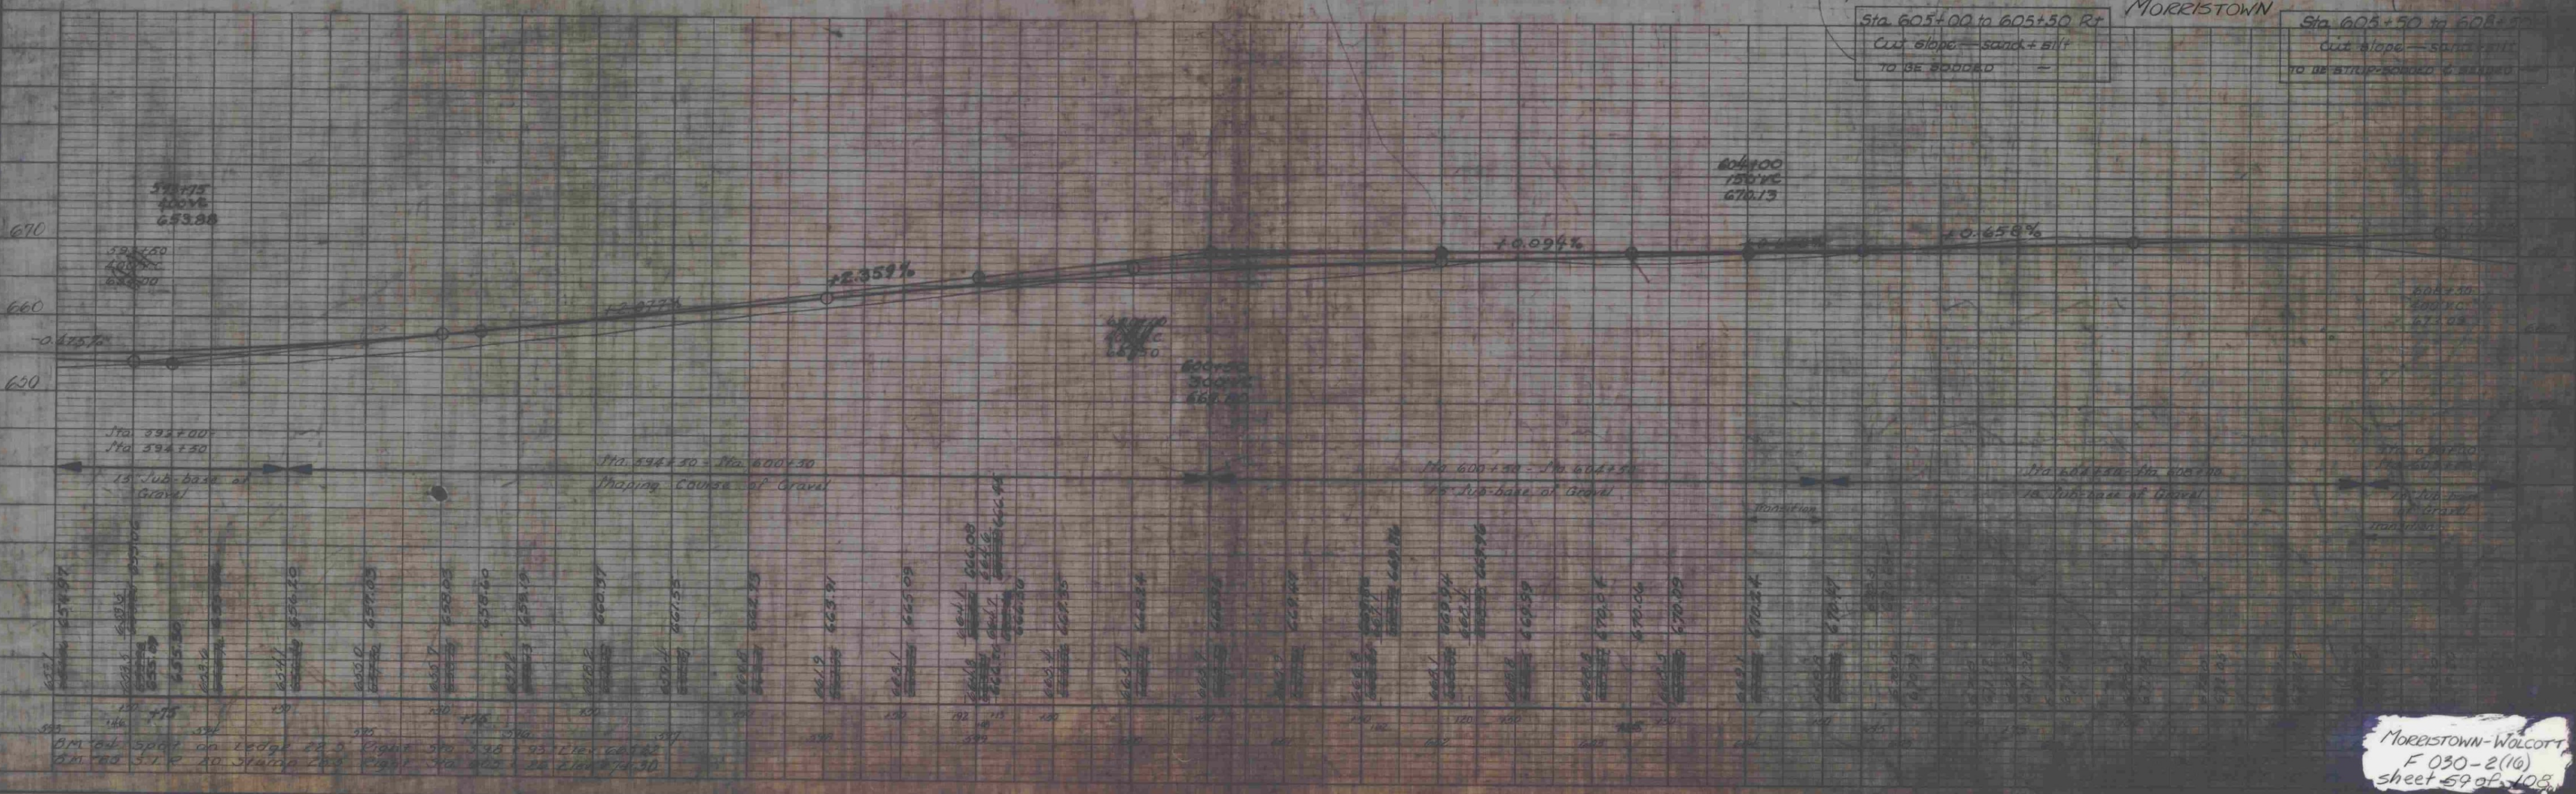

MORRISTOWN-Walcott
 F 030-2(10)
 sheet 59 of 103