

$\Delta$  26.302 RT  
 D 6'  
 R 955.4  
 T 220.9  
 L 433.7  
 E 25.2  
 Widen 2'-0" inside


50'  
 SCALE  
 VT 15  
 WOLCOTT

STA 512+30.4  
 F.A. Proj. 84-D (2) Stops  
 F.A. Proj. 84-D (2) Begins

STA 68+00  
 W.P.H. 84-D Ends

STA 55+00  
 W.P.H. 84-D Begins

Sta 512+75 - 512+75  
 C&E 310' - 310' - 310'  
 as per contract plan

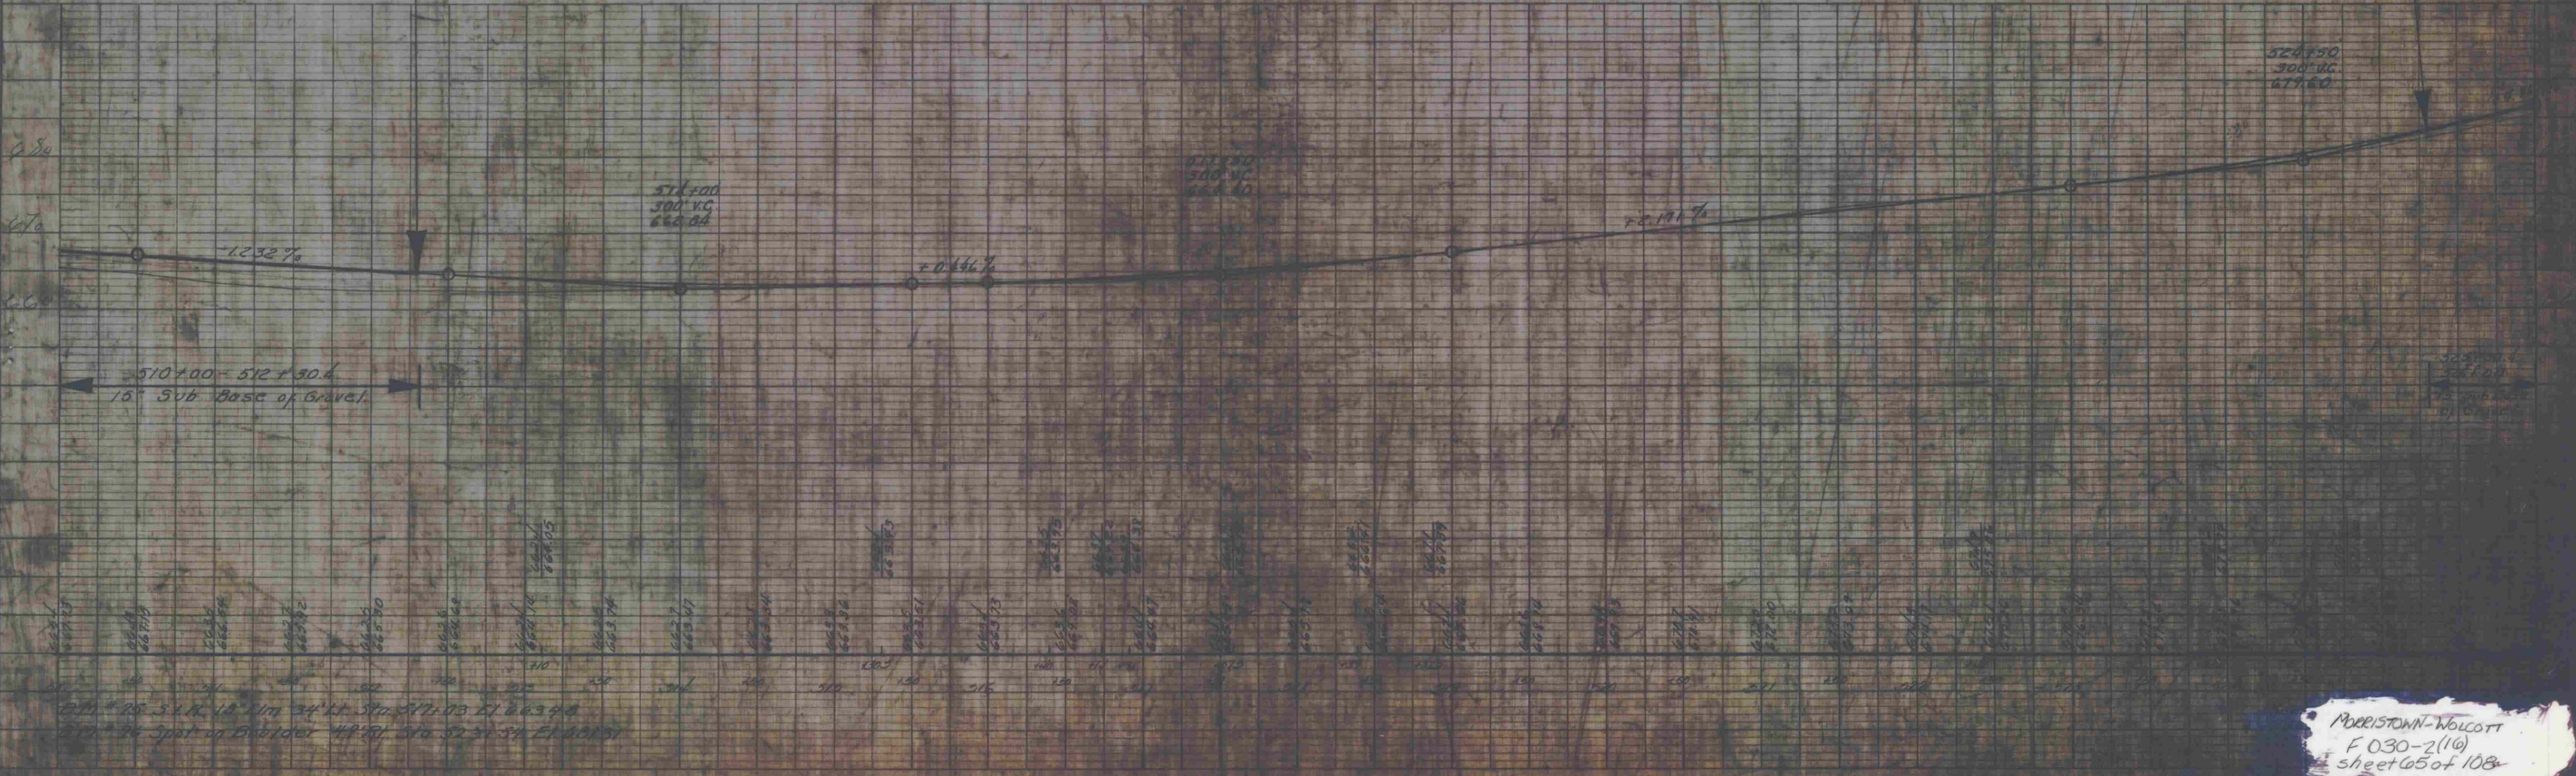

510+00 - 512+30.4  
 18" Sub Base of Gravel

25' 3" x 18" 18" 34" 11' Sta 517+03 El 663.48  
 25' 3" Spot on Boulder W.P.H. Sta 523+54 El 661.31