



NOTE: 478+00-480+00 LT  
Cable Guard Rail to be set back  
on shoulder as far as possible.

$\Delta 69^{\circ}-29' LT$   
D 6'  
R 755.4  
T 662.6  
L 1158.1  
E 207.2  
Widen 2'-0" inside.

PARCEL INSTRUMENT	DATE	GRANTOR	GRANTEE	RECORDED	REMARKS
A.B	W.D.O.E	4-3-41	H.M. McFARLAND	ST. OF VT. BOOK PAGE DATE 27 318-9 4-28-41	WOLCOTT

FILE NO. 1030  
SHEET NO. 107  
DATE 1941 APR 22 1941

DATE 3-17-41  
BY J.P. WOLCOTT  
CHECKED BY J.P. WOLCOTT  
NO. 107

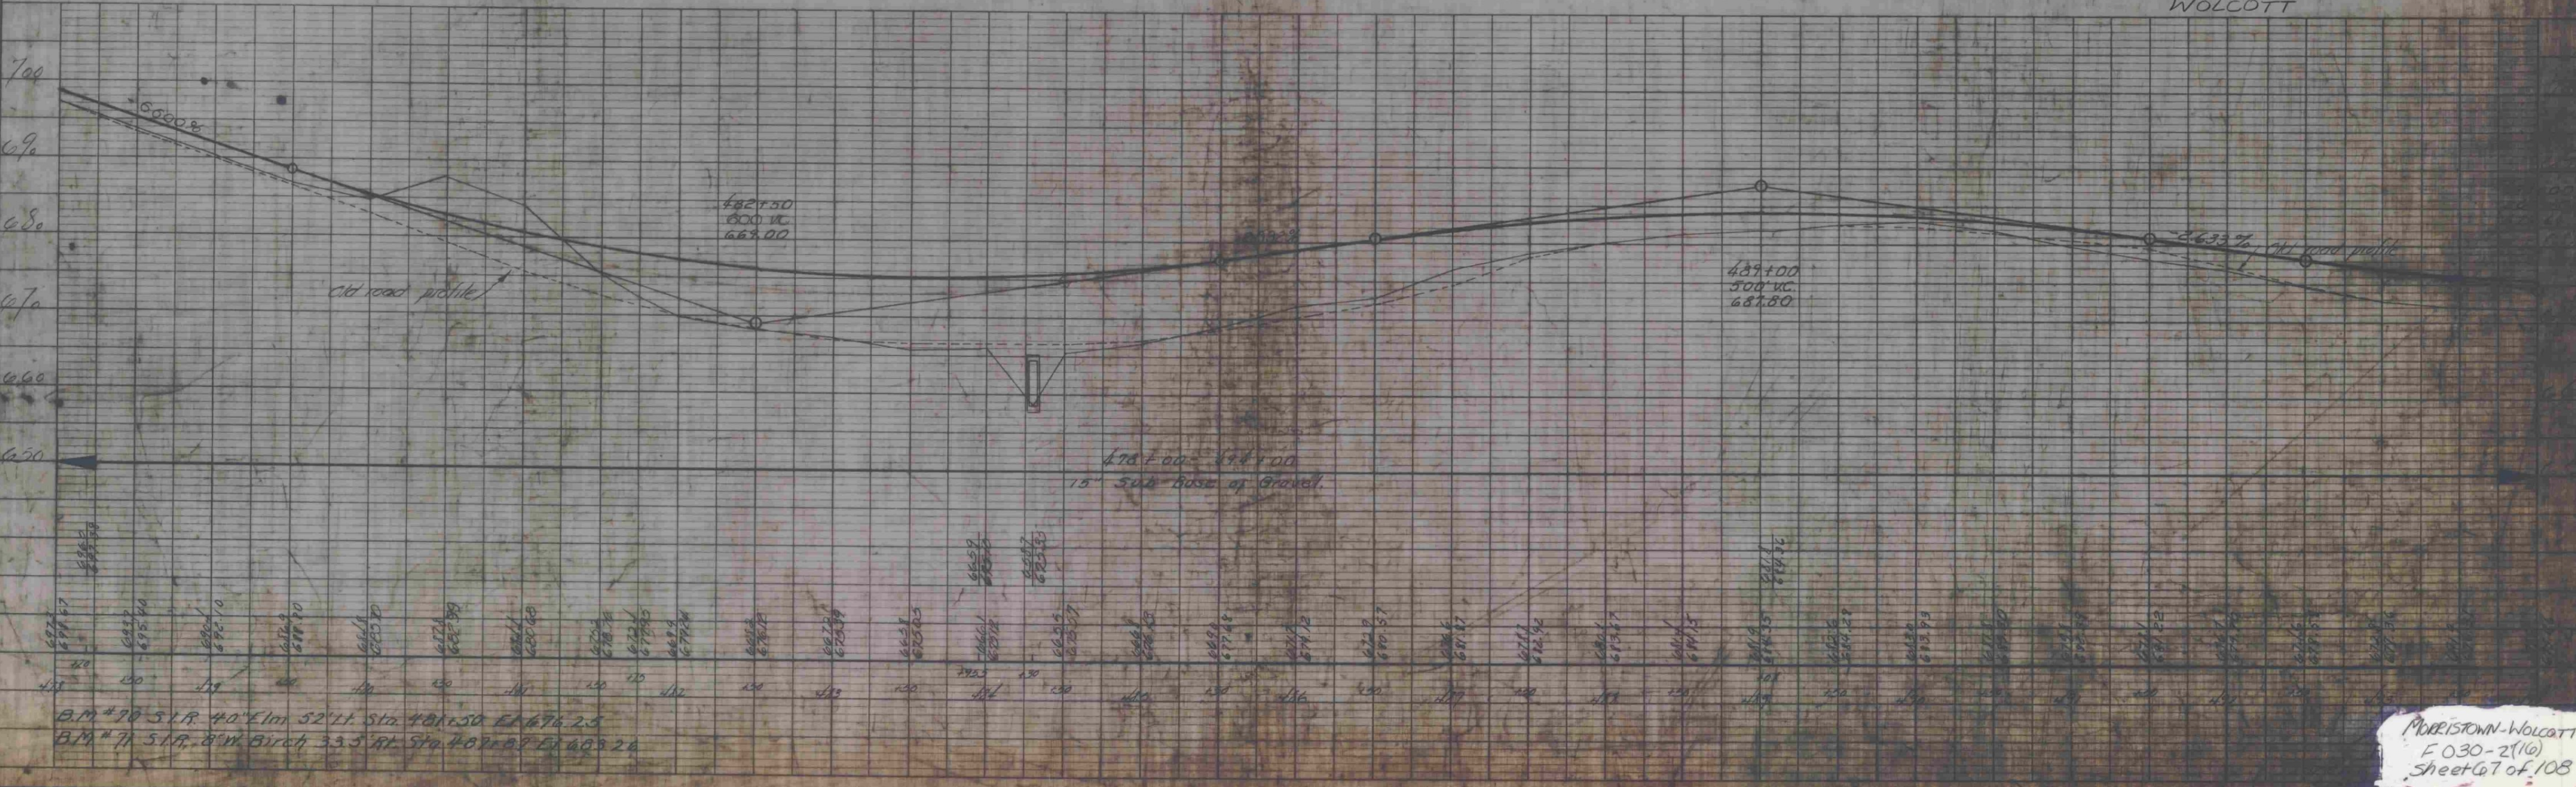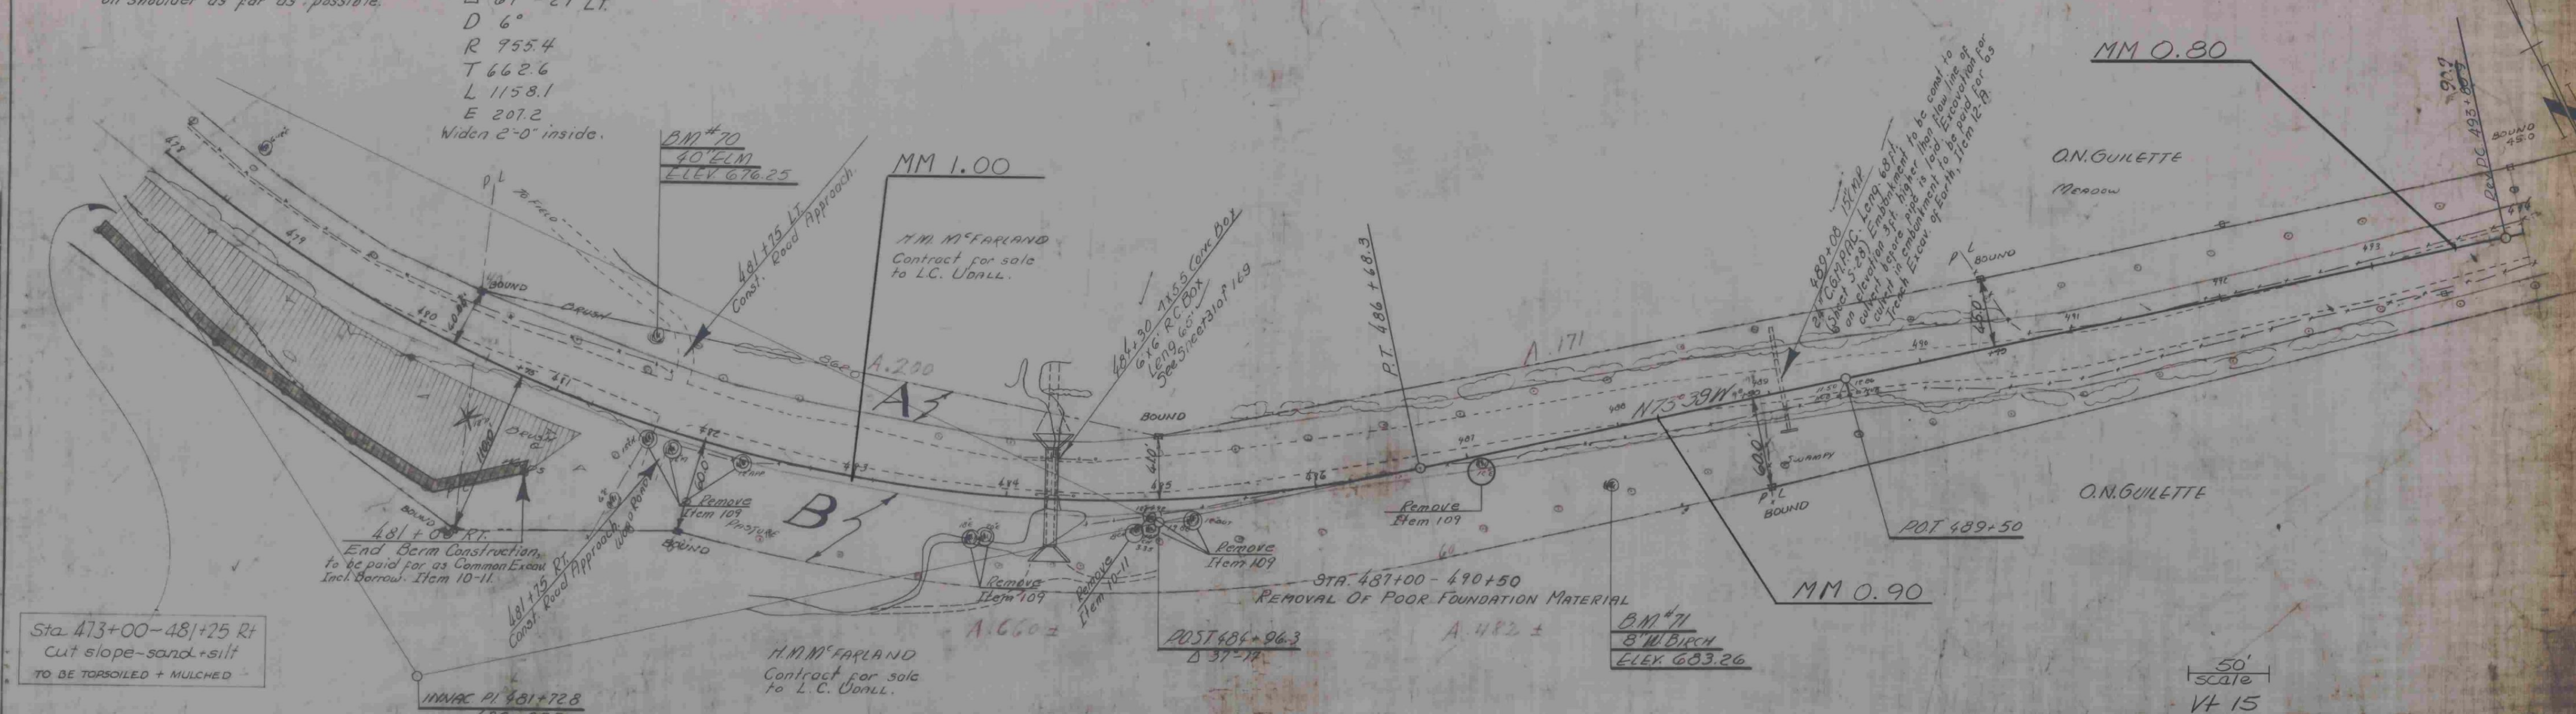

50' scale  
Vt 15  
WOLCOTT

Morestown-Wolcott  
E 030-2(10)  
Sheet 67 of 108