


PARCEL INSTRUMENT DATE GRANTOR GRANTEE RECORDED REMARKS  
 D.C.B. W.D.O.E. 2-27-41 C.M. & LINA ELDRIDGE ST OF VT. WOLCOTT  
 289X 285E DATE 3-27-41


REG. NO. STATE REG. NO. YEAR NO. SHEET  
 9 VT. 88780 1941 20 163

NOTE: Guide posts to be set 12 ft. apart, center to center, from Sta. 440+50 to 441+50 Lt.

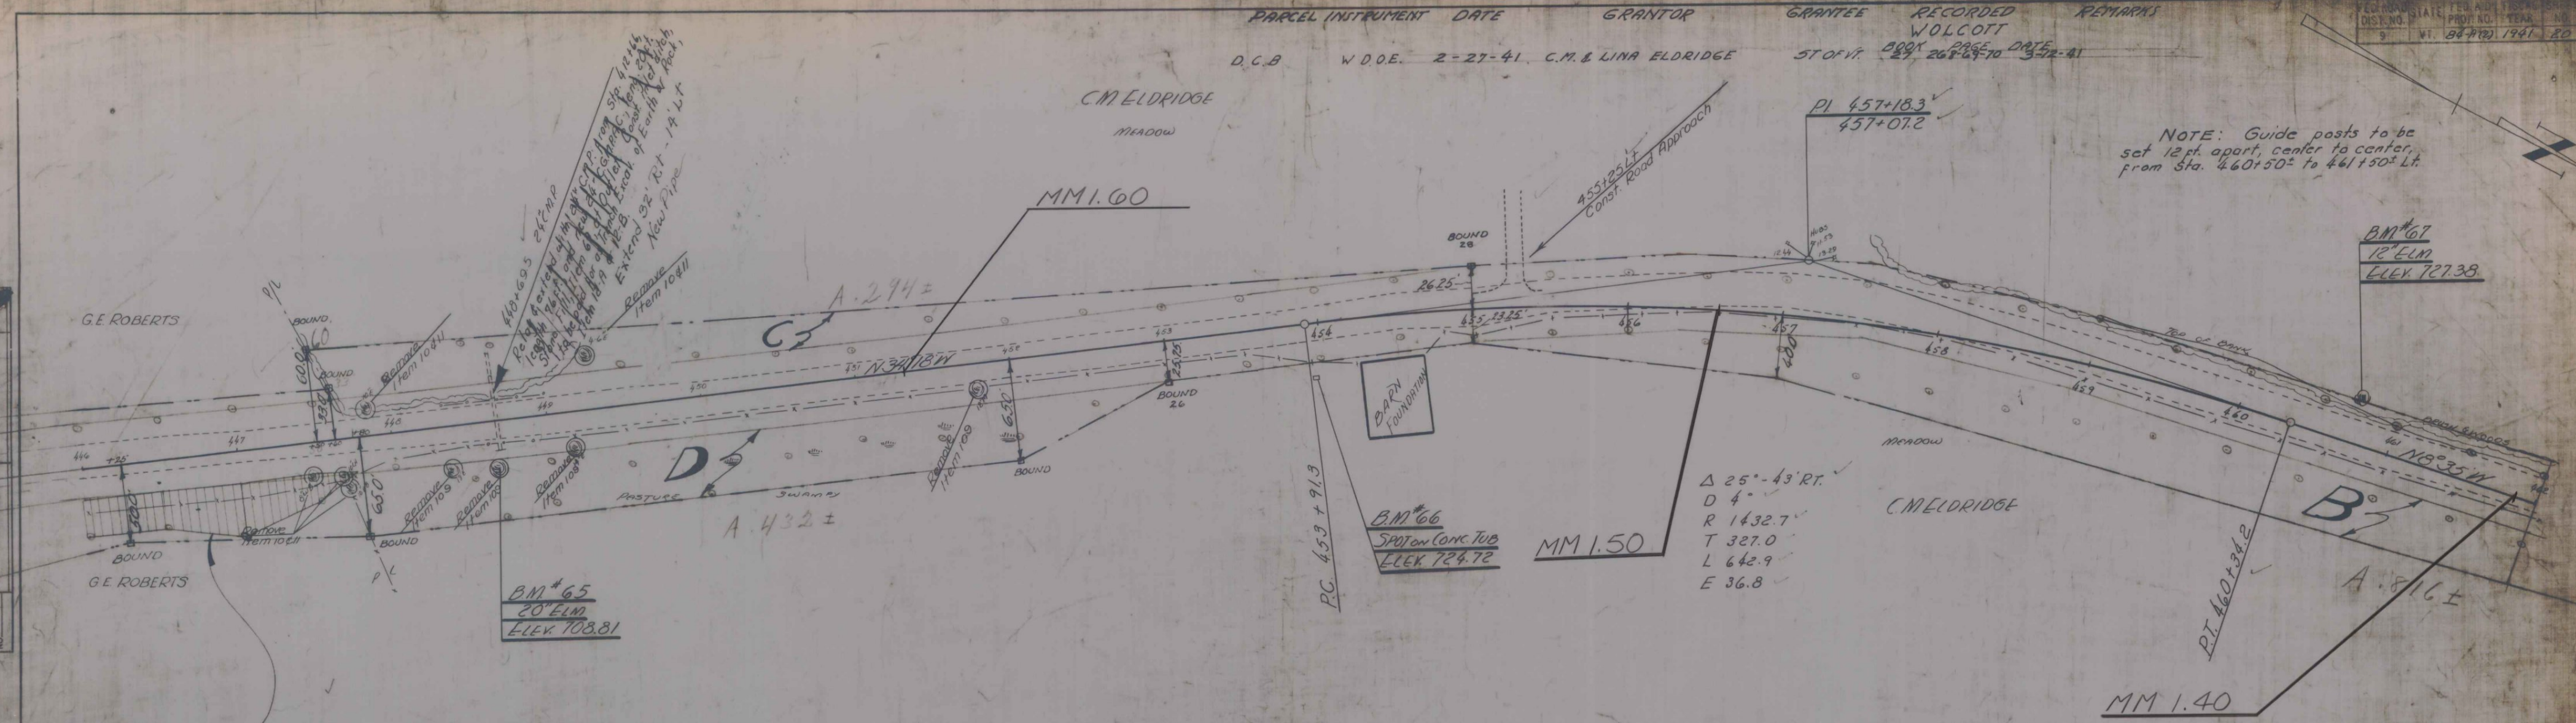

Sta. 442+50 - Sta. 447+75 Rt  
 Cut slope - sand + silt  
 TO BE TOPSOILED & MULCHED

50' scale V+15 WOLCOTT

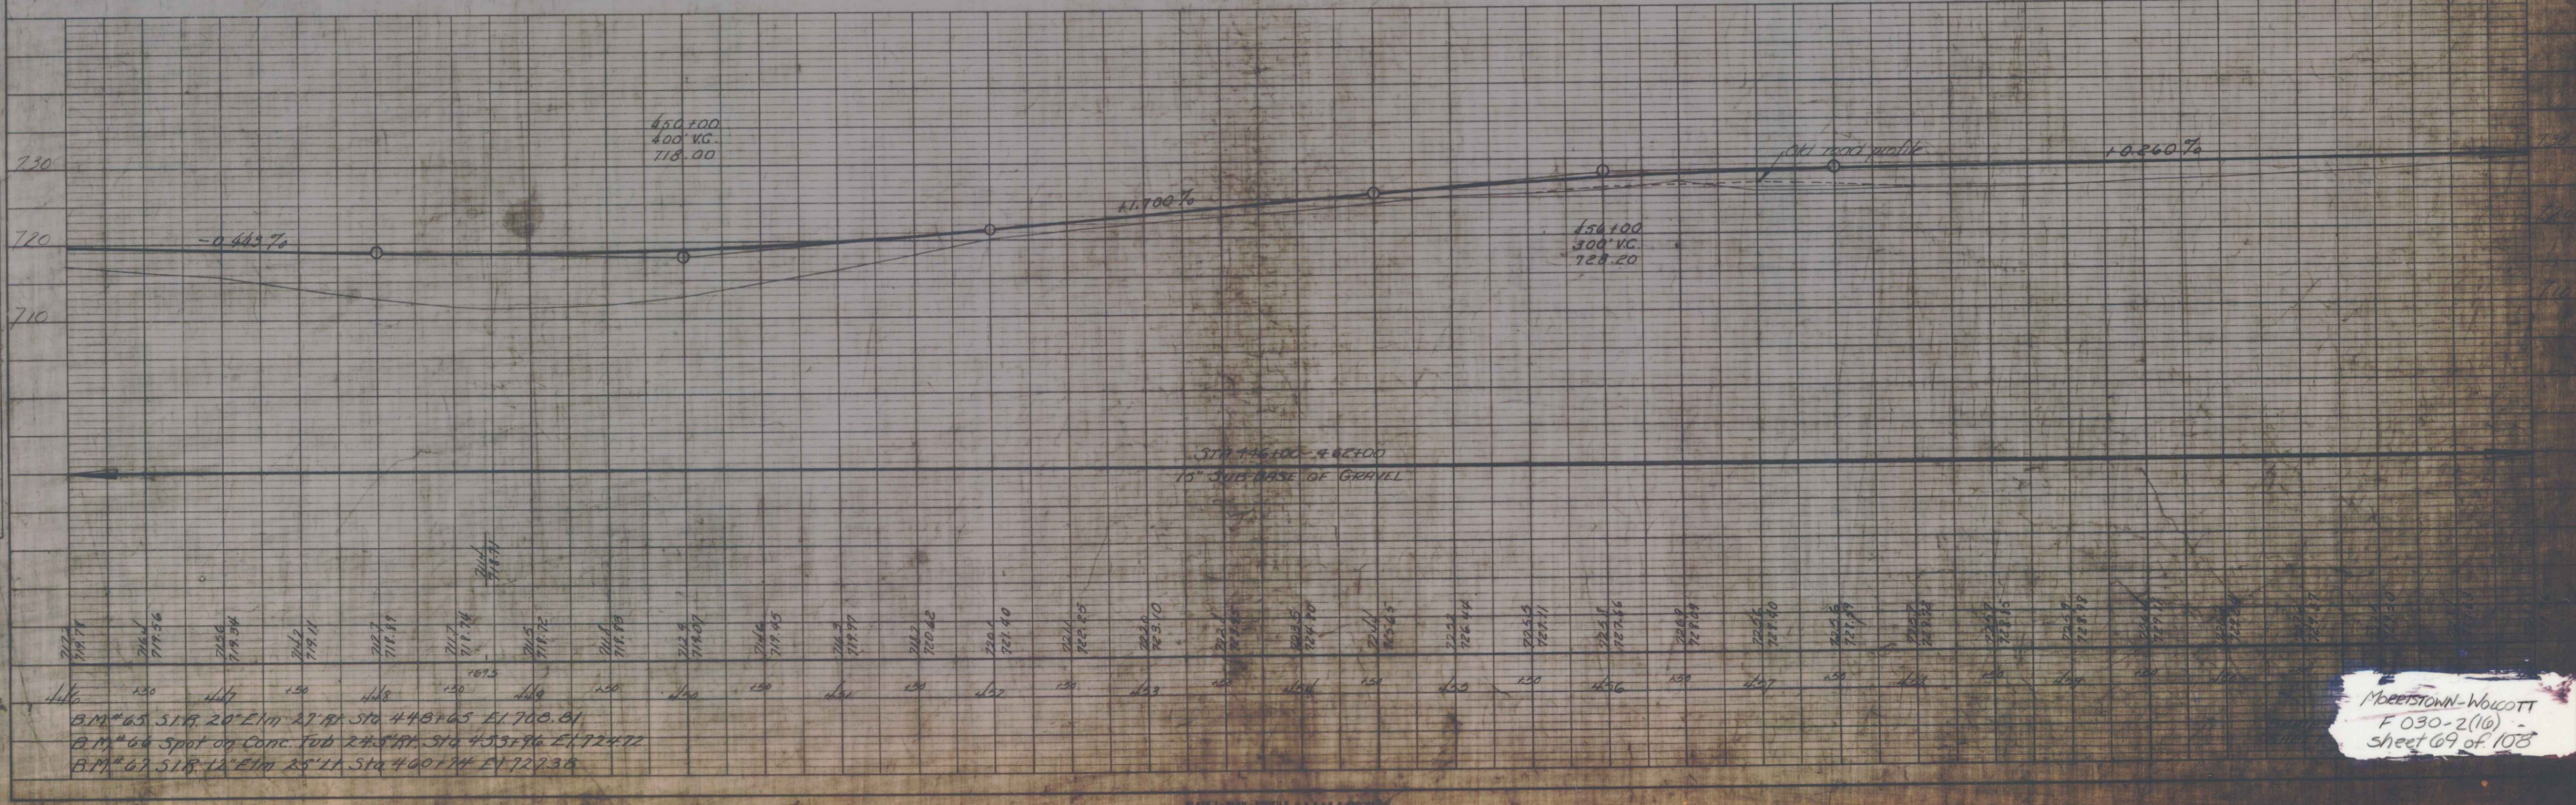

MORRISTOWN-WOLCOTT  
 F 030-2(16)  
 sheet 69 of 103