

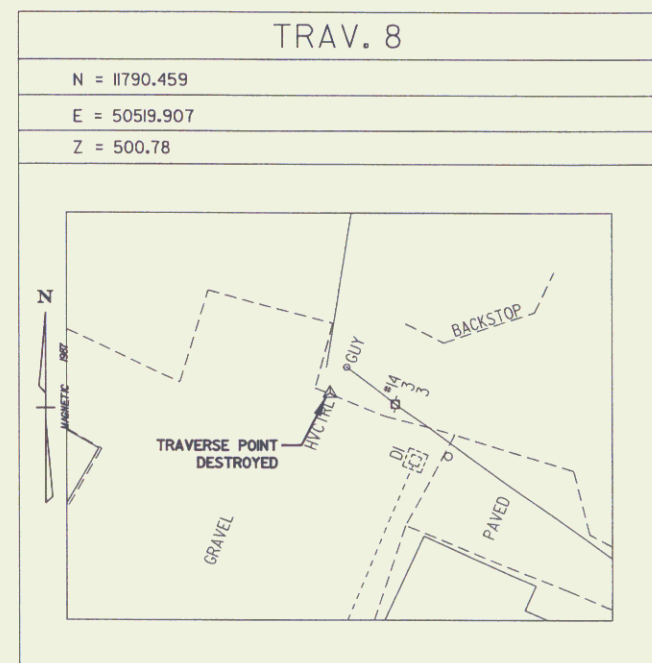
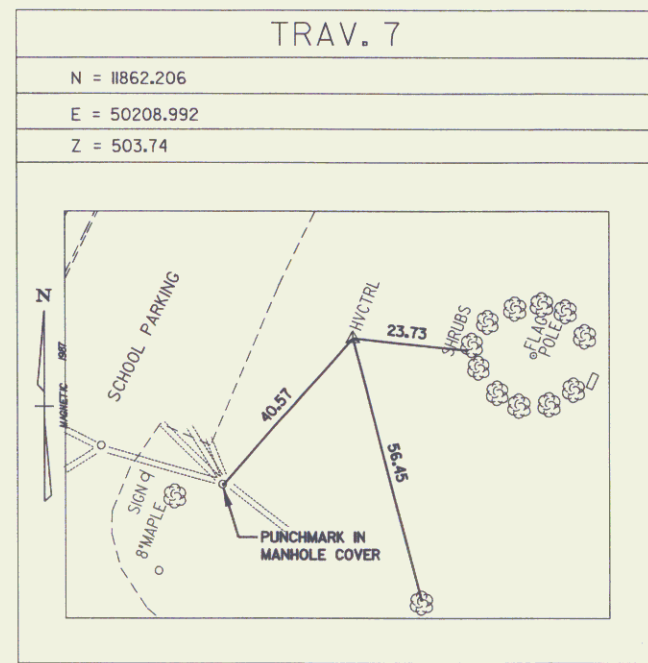
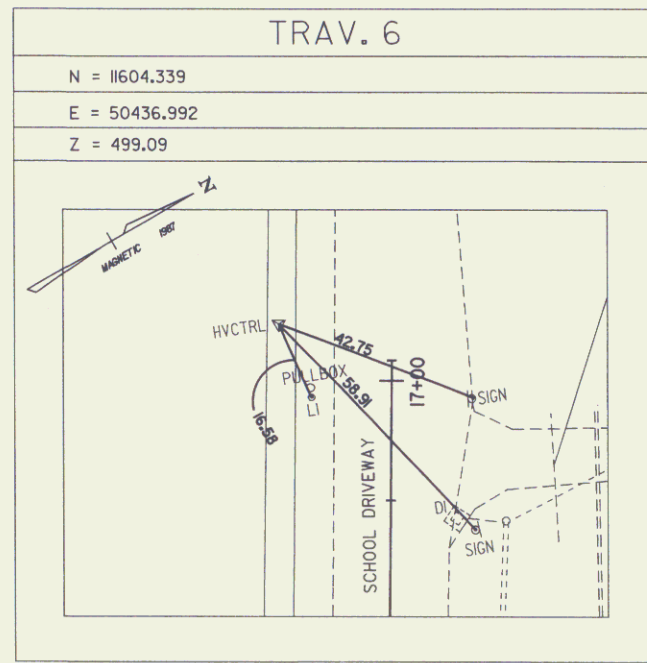
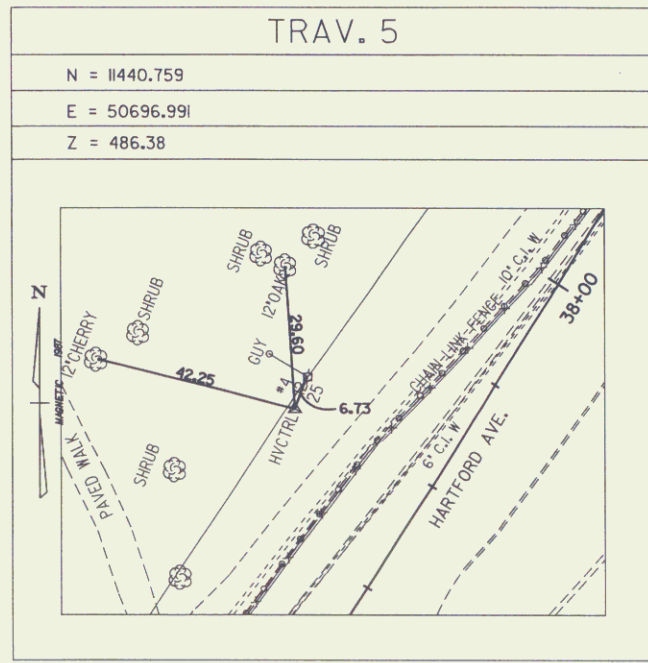
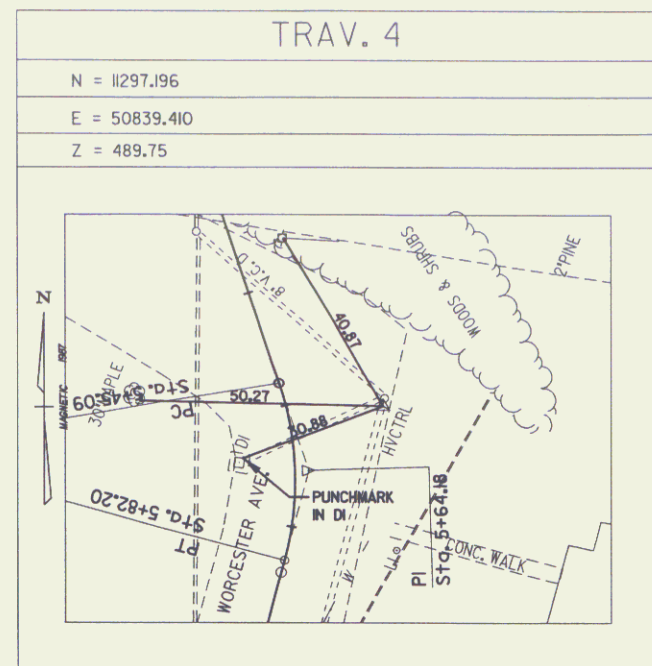
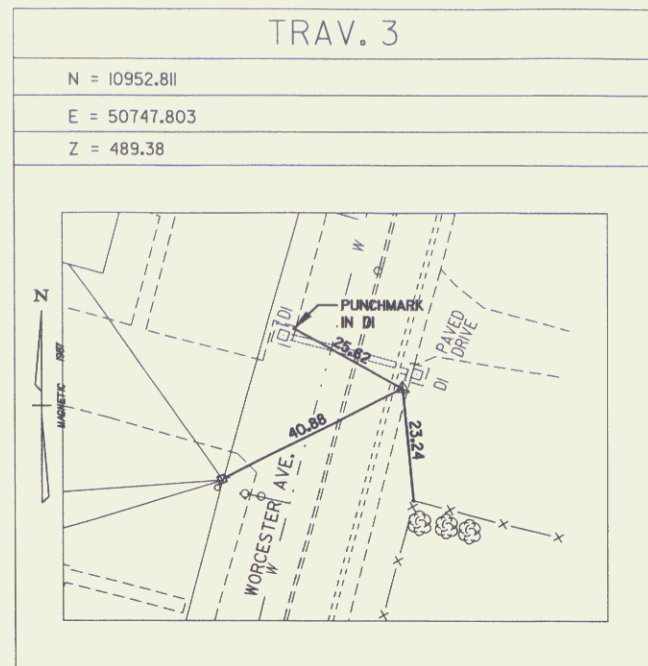


TRAVERSE TIES

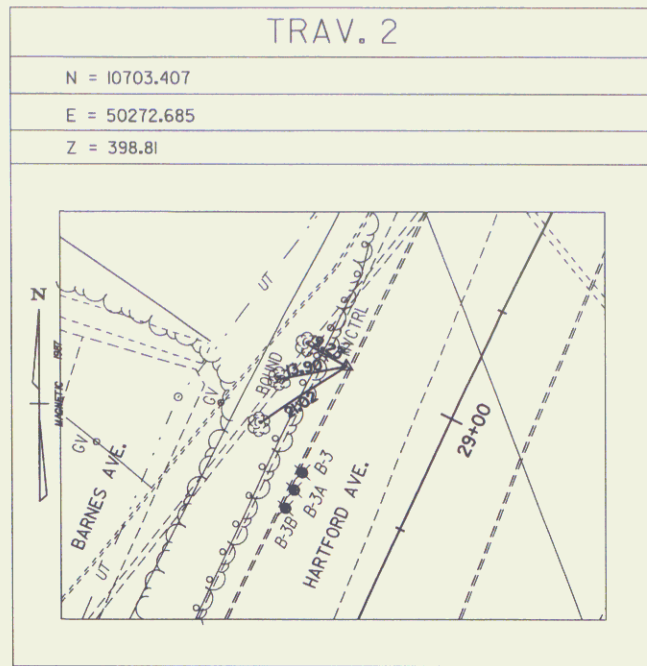

| | |
|--------------|-----------|
| DATUM | |
| VERTICAL | NGVD 1929 |
| HORIZONTAL | N/A |

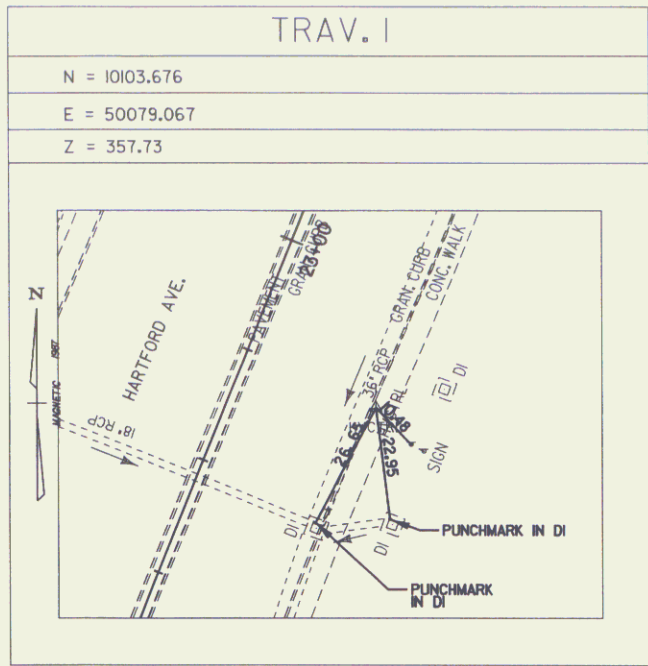

| | |
|---|------------------------------------|
| PROJECT: HARTFORD | PROJECT NO.: RS 0113(40) |
| DESIGN FILE NAME: *****FILENAME*** | PLOT DATE: 23-FEB-2006 |
| IPARM FILE NAME: | SURVEY DATE: 1/07 |
| SURVEYED BY: FANTONI | DRAWN BY: E. ATKINS |
| SQUAD LEADER: KEN UPMAL | ROW SHEET: 4 of 62 |

TIE SHEET 1