

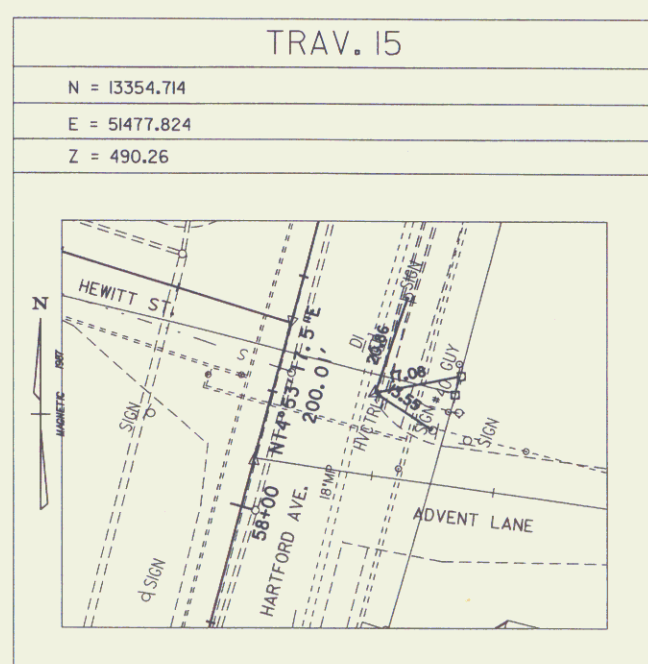
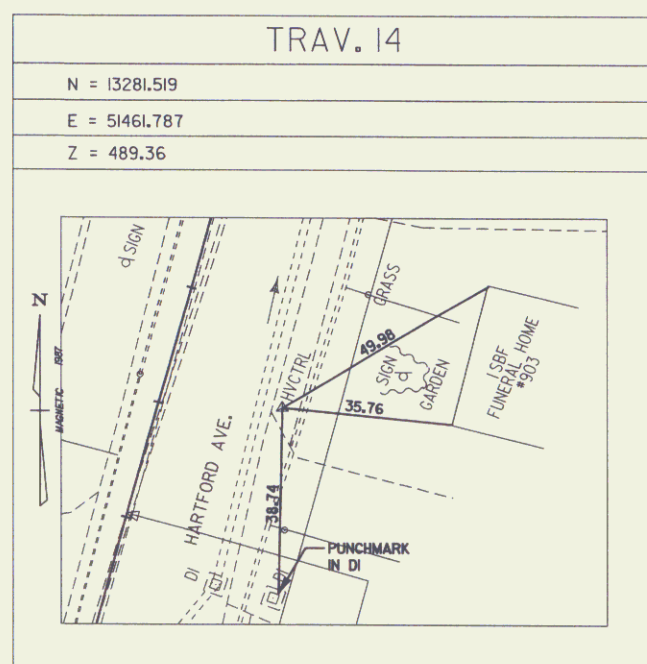
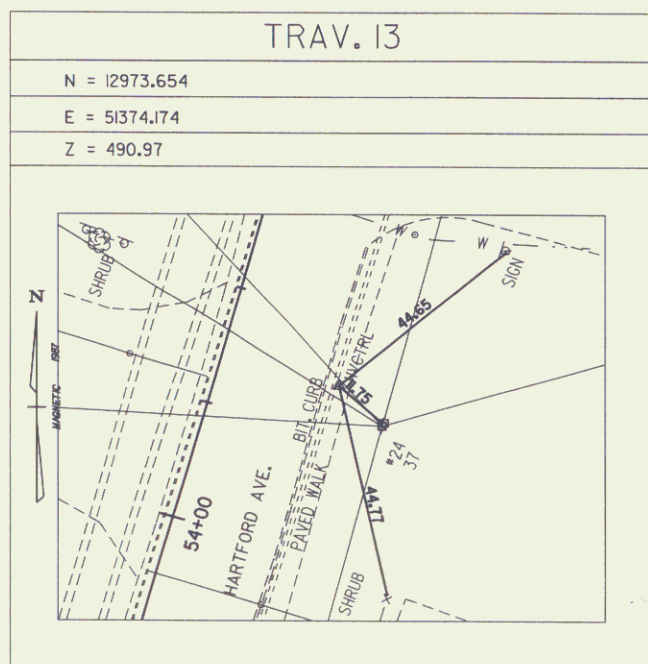
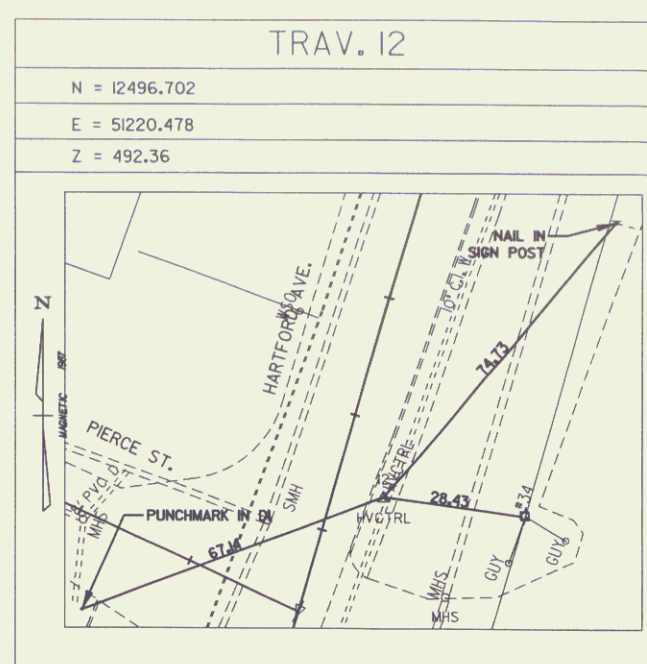
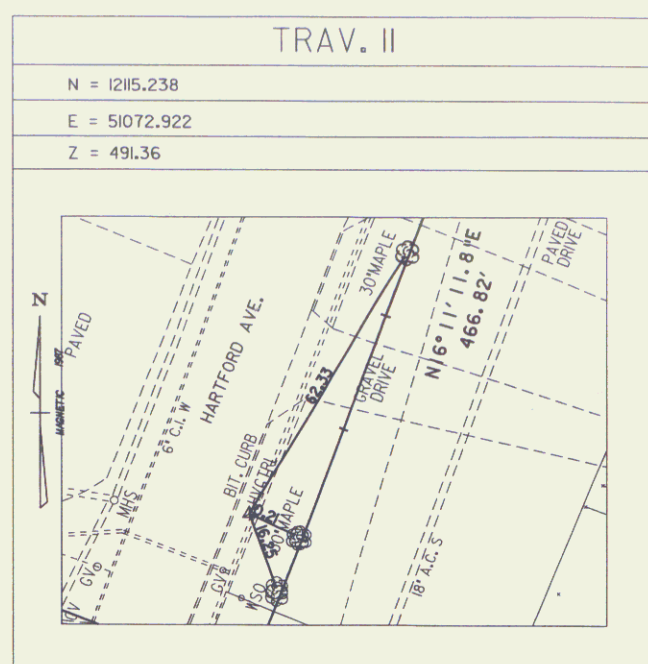
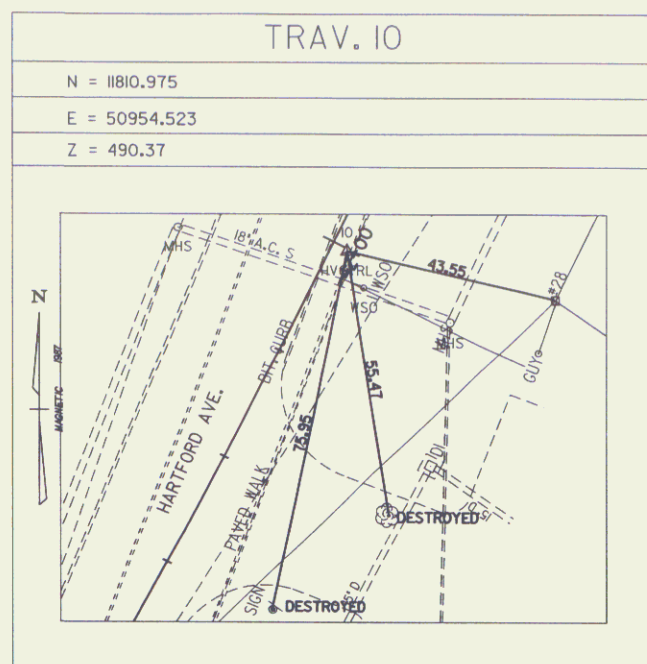


TRAVERSE TIES

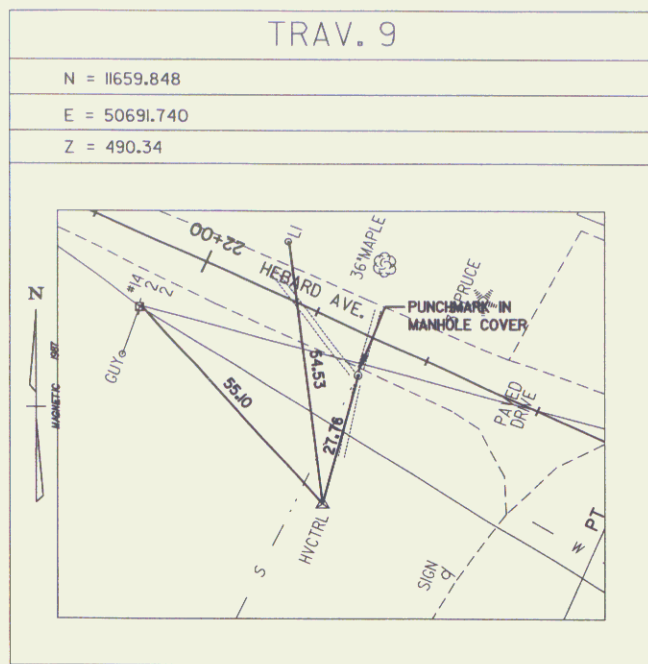

DATUM	
VERTICAL	NGVD 1929
HORIZONTAL	N/A

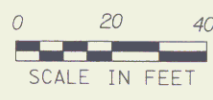

PROJECT: HARTFORD	PROJECT NO.: RS 0113(40)
DESIGN FILE NAME: ****FILENAME***	PLOT DATE: 23-FEB-2006
IPARM FILE NAME:	SURVEY DATE: 1/87
SURVEYED BY: FANTONI	DRAWN BY: E. ATKINS
SQUAD LEADER: KEN UPMAL	ROW SHEET 5 OF 62

TIE SHEET 2