

RIGHT - OF - WAY DETAIL SHEET


TABLE OF PROPERTY ACQUISITION

PARCEL NO.	PROPERTY OWNER	SHEET NO.	BEGINNING STATION	ENDING STATION	TAKE AREA±	REMAINDER AREA±	RIGHT			RECORDING DATA				REMARKS			
							TYPE	(T)(P)	AREA ±	TITLE	DATE	TOWN / CITY	BOOK		PAGE		
1	MASCOMA SAVINGS BANK,FSB	53	22+30.86 LT.	20+68.30 LT.			SLOPE	(T)	13.1 SF								
			22+46.87 LT.				CULVERT	(P)									
			22+41.99 LT.	22+51.20 LT.			INSTALL	(T)								INCLUDES DROP INLET EROSION CONTROL	
2	HARTFORD LAND COMPANY	53	22+02.84 RT.	23+82.18 RT.			SLOPE	(T)	302.5 SF								
			22+49.95 RT.	23+75.21 RT.			INSTALL & MAINT.	(P)								INCLUDES PDF DROP INLET	
			23+75.19 RT.	24+47.88 RT.			INSTALL	(T)								EROSION CONTROL & PDF	
3	SMITH, BJORN E.	54	27+01.13 LT.	27+10.44 LT.			INSTALL	(T)							EROSION CONTROL		
4	SMITH, EVERETT J. & SANDRA F.	54,55	28+91.16 LT.	33+05.42 LT.	0.24A					WD	11/14/06	HARTFORD	411	534-			
			28+91.22 LT.	29+13.64 LT.			SLOPE	(T)	213.1 SF								
			28+91.24 LT.	29+13.64 LT.			INSTALL	(T)	163.1 SF							EROSION CONTROL & PDF TREES/SHRUBS	
5	BLAKE, CAROLE L.	54,55	30+26.00 RT.	30+67.81 RT.			INSTALL & MAINTAIN	(P)	353.3 SF	WD	08/17/09	HARTFORD	443	670-	SOIL ANCHORS		
			30+04.90 RT.	30+71.94 RT.			INSTALL	(T)								MODIFIED PDF FENCE	
			30+13.58 RT.	30+70.74 RT.			LANDSCAPE	(T)								TREES/SHRUBS	
6	CARTER, DERROL N. & THERESA A.	55	30+65.68 RT.	31+75.07 RT.			INSTALL & MAINTAIN	(P)	0.07 A	WDOE	11/14/06	HARTFORD	411	544-	SOIL ANCHORS		
			30+71.94 RT.	31+73.17 RT.			INSTALL	(T)								MODIFIED PDF FENCE	
			30+65.76 RT.	31+72.25 RT.			LANDSCAPE	(T)								TREES/SHRUBS	
7	GILBERT, KENDALL S. & LINDA R.	55	31+65.58 RT.	32+80.88 RT.			INSTALL & MAINTAIN	(P)	0.24 A	WDOE	12/07/06	HARTFORD	412	437-	SOIL ANCHORS		
			31+73.07 RT.	32+70.92 RT.			INSTALL	(T)								MODIFIED PDF FENCE	
			31+65.68 RT.	32+70.52 RT.			LANDSCAPE	(T)								TREES/SHRUBS	
			32+36.23 RT.	32+66.16 RT.			DIT. & DR.	(P)	5.3 SF								
			31+65.58 RT.	32+70.37 RT.			SLOPE	(P)	2279.3 SF								

TABLE OF REVISIONS

REVISION NO.	SHEET NO.	DESCRIPTION	DATE
1	46,55	PARCEL NO. 5 BLAKE. ADD SLOPE (P) AT STA. 30+13.75 RT. ~ 30+70.94 RT.; 884.2 SF± REMOVE 1967 SLOPE LIMITS THAT ARE ON THE LAYOUTS. PER C.O. 9457. MADE BY: JAB APPROVED BY: RPD	06/23/06
2	46,55	PARCEL NO. 6 CARTER. ADD SLOPE (P) AT STA. 30+65.68 RT. ~ 31+74.49 RT.; 1501.1 SF± REMOVE 1967 SLOPE LIMITS THAT ARE ON THE LAYOUTS. PER C.O. 9458. MADE BY: JAB APPROVED BY: RPD	06/23/06
3	46,55	PARCEL NO. 7 GILBERT. ADD SLOPE (P) AT STA. 31+65.58 RT. ~ 32+70.37 RT.; 2279.3 SF± REMOVE 1967 SLOPE LIMITS THAT ARE ON THE LAYOUTS. PER C.O. 9459. MADE BY: JAB APPROVED BY: RPD	06/23/06
4	47,55	PARCEL NO. 8 HODGDON. ADD SLOPE (P) AT STA. 32+66.25 RT. ~ 33+65.97 RT.; 1359.8 SF± REMOVE 1967 SLOPE LIMITS THAT ARE ON THE LAYOUTS. PER C.O. 9460. MADE BY: JAB APPROVED BY: RPD	06/23/06
5	47,55	PARCEL NO. 9 LERNER. ADD SLOPE (P) AT STA. 33+63.43 RT. ~ 34+58.58 RT.; 690.4 SF± REMOVE 1967 SLOPE LIMITS THAT ARE ON THE LAYOUTS. PER C.O. 9461. MADE BY: JAB APPROVED BY: RPD	06/23/06
6	47, 55, 56	PARCEL NO. 10 DALPHINAIS. ADD SLOPE (P) AT STA. 34+62.59 35+50.75 RT.; 660.3 SF± REMOVE 1967 SLOPE LIMITS THAT ARE ON THE LAYOUTS. PER C.O. 9462. MADE BY: JAB APPROVED BY: RPD	06/23/06
7	47,58	PARCEL NO. 13 ALVIN. REMOVE WALK (T) FROM LAYOUT AND DETAIL SHEET. CHANGE DRIVE STATION FROM 41+17 TO 41+14.50. PER C.O. 9465. MADE BY: JAB APPROVED BY: RPD	06/14/06
8	48,58	PARCEL NO. 15 BLODGETT. CHANGE DRIVE STATION OF FROM 41+17.00 TO 41+14.50 LT. DELETE WALK (T). CHANGE CHANGE THE STATIONS FOR TWO RIGHTS TO INSTALL CURB TO THE FOLLOWING: 41+40.65 LT. ~ 41+77.60 LT. THE BEGINNING STA. 43+46.57 LT. TO 43+54.48 LT. PER C.O. 9466. MADE BY: JAB APPROVED BY: RPD	06/14/06
9	50,60	PARCEL NO. 26 VINCENT. CHANGE DRIVE STA. FROM 50+25.00 TO 50+37.00. PER C.O. 9467. MADE BY: JAB APPROVED BY: RPD	06/14/06
10	51,61	PARCEL NO. 36 M.T. ASSOCIATION. CHANGE DRIVE STA. FROM 57+01 TO 57+03 LT. 40'. PER C.O. 9468. MADE BY: JAB APPROVED BY: RPD	06/14/06
		ELECTRONIC PDF FILES TO CONSULTANT 12-06-06	

PLOT DATE 08/21/09

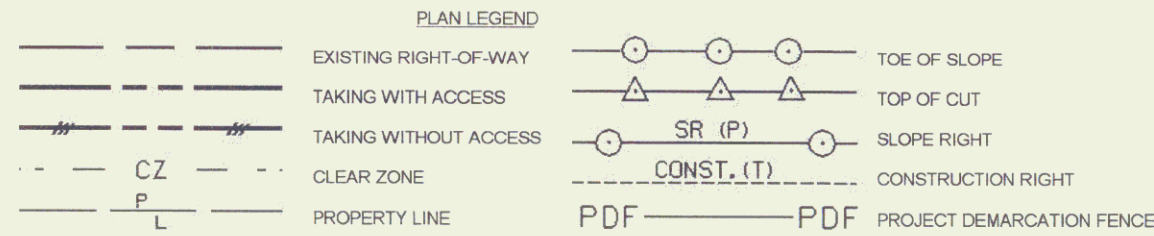

- EC - EROSION CONTROL
- (P) - PERMANENT
- (T) - TEMPORARY
- DR. - DRAINAGE RIGHT
- DIT. - DITCHING RIGHT
- CH. - CHANNEL RIGHT
- DRIVE - DRIVE RIGHT
- CUL. - CULVERT RIGHT
- C&T - CLEARING & TRIMMING RIGHT
- SR - SLOPE RIGHT
- UE - UTILITY EASEMENT

APPROVED: HARRY PETROYS, DATE: 03-28-06
CHIEF, PLANS & TITLES

PROJECT NAME:	HARTFORD
PROJECT NUMBER:	RS 0113(40)
FILE NAME:	96C027.XLS
PROJECT LEADER:	0
DESIGNED BY:	0
R.O.W. SHEET	46 OF 62
PLOT DATE:	08/21/09
DRAWN BY:	MR
CHECKED BY:	FM
SHEET	27 OF 238

46