


GEODETIC CONTROL INFORMATION



TRAVERSE TIE INFORMATION

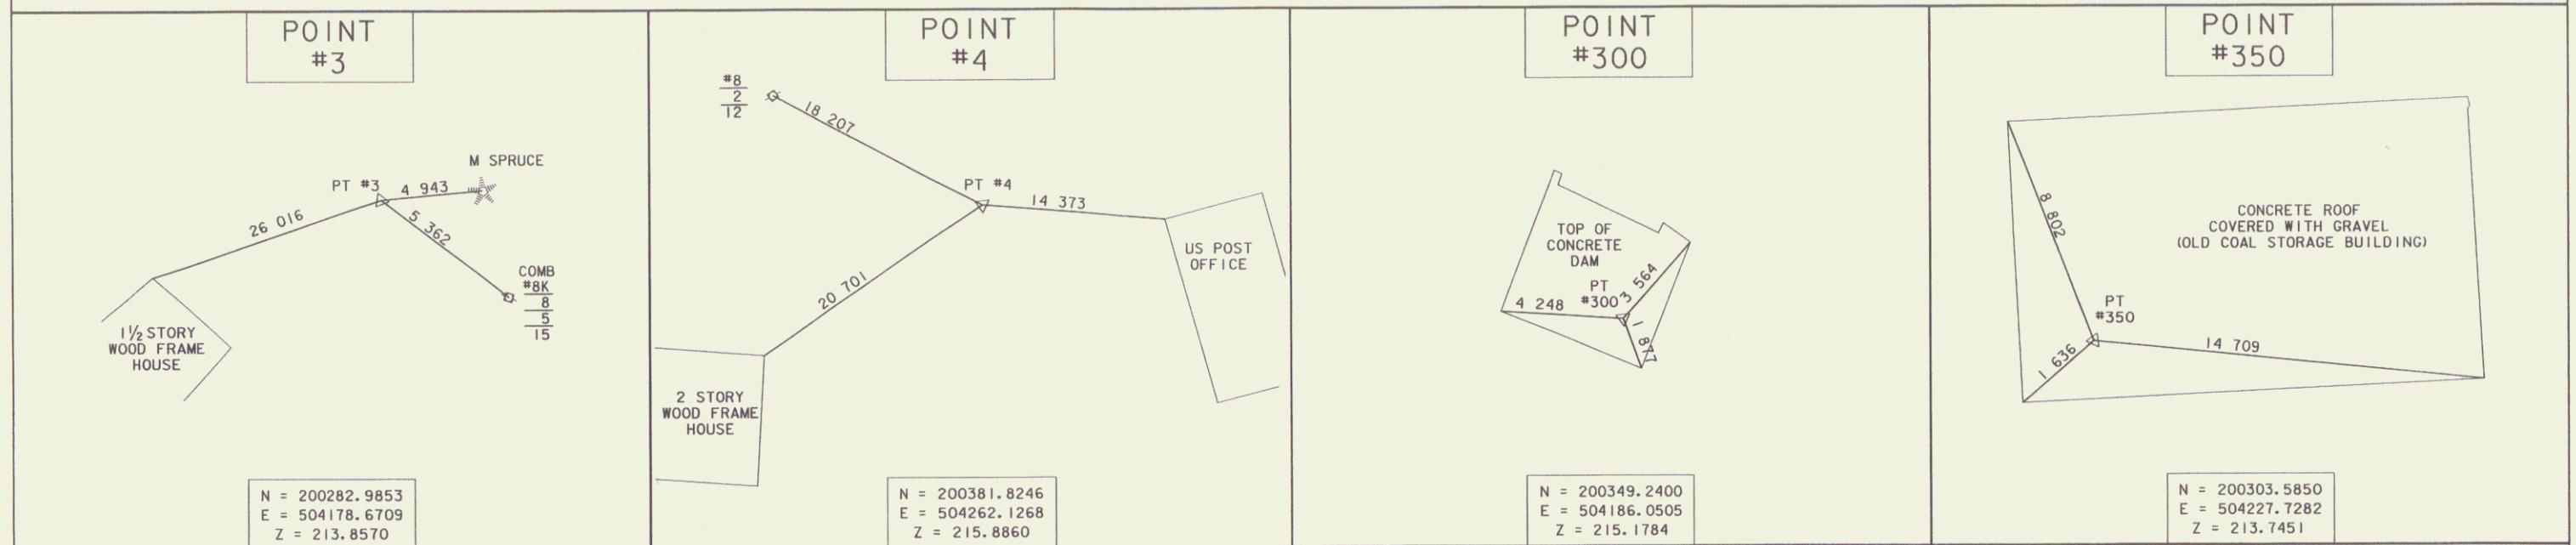

NEW ALIGNMENT TIE INFORMATION

DATUM	
VERTICAL	USGS
HORIZONTAL	ASSUMED

ALL TIES ARE SHOWN NOT TO SCALE	
PROJECT: EAST MONTEPELIER	PROJECT NO.: BRF 037-2 (8)
DESIGN FILE NAME: /str4/86e054/se054tie.dgn	PLOT DATE: 14-AUG-2006
IPARM FILE NAME: ee054tie.i	SURVEY DATE: 3/93
SURVEYED BY: R. MOREAU	DRAWN BY: P.G. JARVIS
SQUAD LEADER: C.P. WILLIAMS	ROW SHEET: 4 OF 14
TIE SHEET	