

RIGHT - OF - WAY DETAIL SHEET


TABLE OF PROPERTY ACQUISITION

PARCEL NO.	PROPERTY OWNER	SHEET NO.	BEGINNING STATION	ENDING STATION	TAKE	REMAINDER	RIGHT			RECORDING DATA				REMARKS
					AREA±	AREA±	TYPE	(T)(P)	AREA±	TITLE	DATE	TOWN / CITY	BOOK	
1A	RAISNER, WILLIAM A. & LISA S.	11	110+70.50 RT.	114+22.19 RT.			DETOUR	(T)	0.24A					ONE WAY, 10 YEAR TERM, INCLUDES EROSION CONTROL & PDF MONITOR WELL
			115+07.72 RT.											
1B		11	111+73.11 RT.	113+98.84 RT.			CONST.	(T)	0.35A					FOR STAGING, INCLUDES REMOVAL OF FENCE, PDF & EROSION CONTROL 26' PAVED DRIVE
			614+72.76 RT.											3,230 S.F.±
1C		11	110+70.50 RT.	112+41.68 RT.	0.07A									
1D		11	110+80.50 RT.	114+90.00 RT.	0.28A		ALL R.T. & I.							VT. 100A HWY. EASE.
2	BRIDGEWATER GRANGE #284	11	110+16.49 RT.	110+80.50 RT.			DETOUR	(T)	1078 SF					ONE WAY, 10 YEAR TERM, INCLUDES PDF & EROSION CONTROL MONITOR WELL
			110+61.28 RT.											
3	DELETED													FORMERLY EIGENBROD
4	TOWN OF BRIDGEWATER	11	610+39.20 LT.				APPROACH	(T)						TH 58, INCLUDES TRAFFIC DETECTOR LOOPS
5	JOHNSON, BRIAN MICHAEL & STEPHANIE TAYLOR	11	614+55.46 LT.											20' GRAVEL DRIVE
6	CENTRAL VERMONT PUBLIC SERVICE CORPORATION													UTILITY
7	VERMONT TELEPHONE COMPANY, INC.													UTILITY
8	ADELPHIA CABLE COMMUNICATIONS													UTILITY

TABLE OF REVISIONS

REVISION NO.	SHEET NO.	DESCRIPTION	DATE
1	10,11	PARCEL NO. 3 EIGENBROD. DELETE PARCEL. PER C.O. 9415. APPROVED BY: R.P.D.	03/17/05
2	10	PARCEL NO. 1B RAISNER. CHANGE STATIONING OF DRIVE FROM 116+72.56 RT. TO 614+72.76 RT. PER C.O. 9417. MADE BY: M.R. APPROVED BY: R.P.D.	03/30/05
3	1,10,11	PARCEL NO. 1 RAISNER. ADD PARCEL 1C WHICH WILL BE 0.07A± IN FEE. ADD PARCEL 1D WHICH WILL BE 0.28A± OF HIGHWAY EASEMENT. PER C.O. 9432. MADE BY: M.R. APPROVED BY: R.P.D.	07/22/05

PLOT DATE 07/22/05

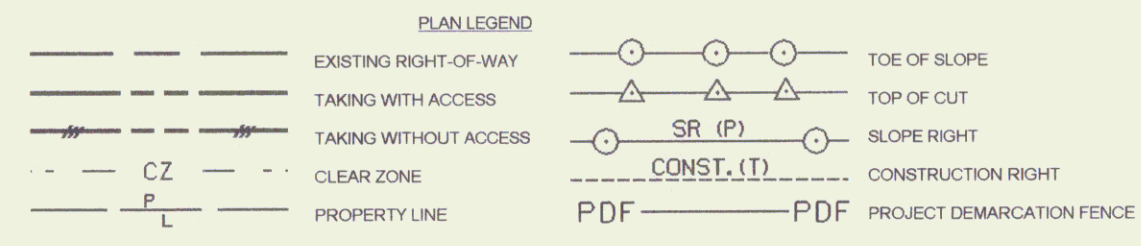

- (P) -PERMANENT
- (T) -TEMPORARY
- DR -DRAINAGE RIGHT
- DIT -DITCHING RIGHT
- CH -CHANNEL RIGHT
- DRIVE -DRIVE RIGHT
- CUL -CULVERT RIGHT
- C&T -CLEARING & TRIMMING RIGHT
- SR -SLOPE RIGHT
- UE -UTILITY EASEMENT

APPROVED: ROGER P. DUMAS DATE: 03-17-05
CHIEF, PLANS & TITLES

PROJECT NAME: **BRIDGEWATER**
 PROJECT NUMBER: **BRS 0149(4)**
 FILE NAME: **96E062** PLOT DATE: **Date**
 PROJECT LEADER: **KELLER** DRAWN BY: **M.R.**
 DESIGNED BY: **0** CHECKED BY: **R.F.**
 R.O.W. DETAIL SHEET #1 ROW SHEET **10** OF 11