

INDEX OF SHEETS

# STATE OF VERMONT AGENCY OF TRANSPORTATION




## PROPOSED IMPROVEMENT TOWN OF BURKE VT. RTE. 114



### R.O.W. PLANS

RIGHT-OF-WAY DIVISION  
TOWN FILE  
PERPETUAL  
Town of \_\_\_\_\_  
(To Be Returned To R.O.W. Division)

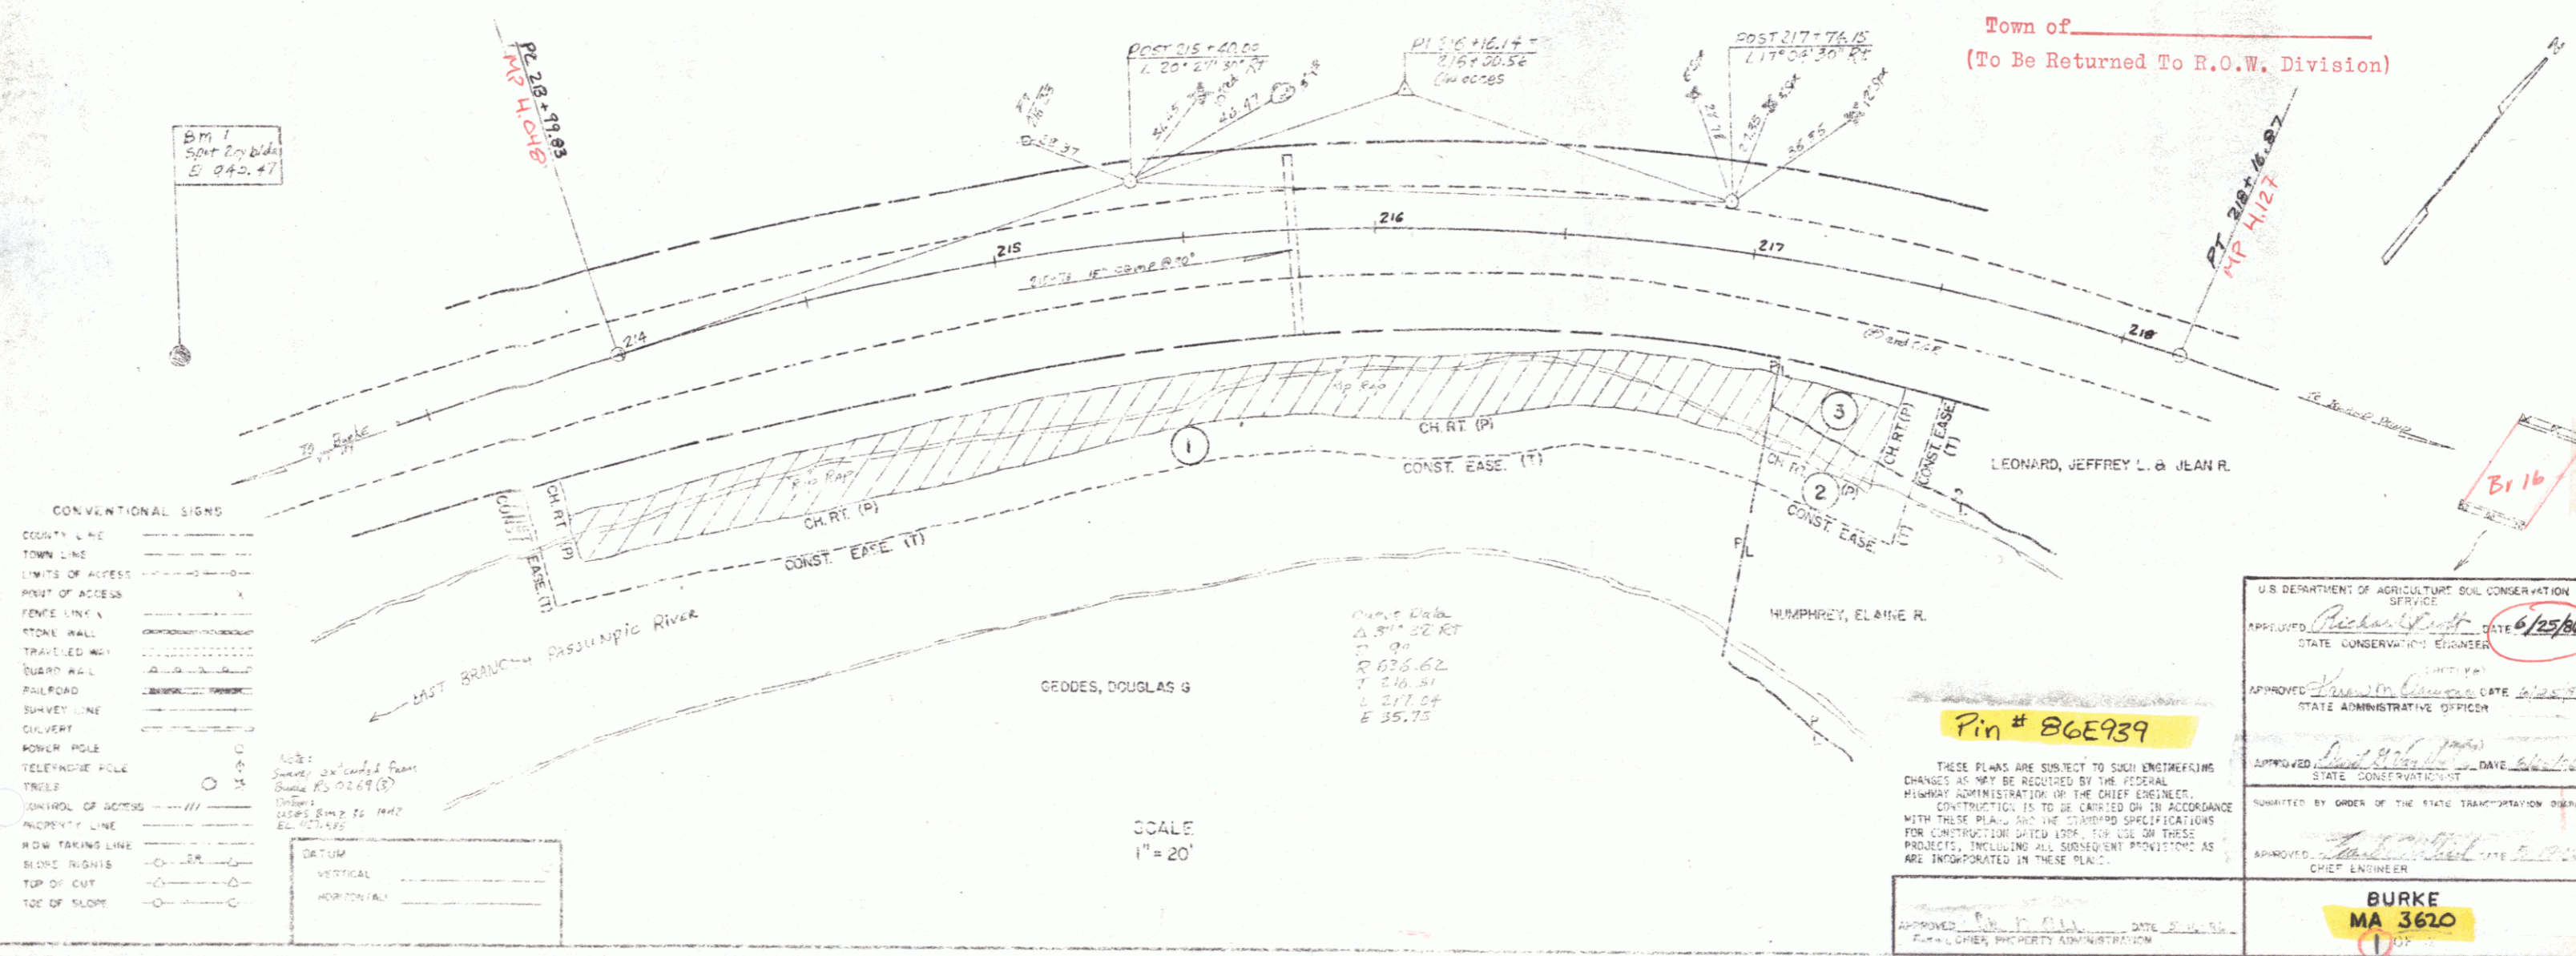

U.S. DEPARTMENT OF AGRICULTURE SOIL CONSERVATION SERVICE

APPROVED: *[Signature]* DATE: 6/25/64  
STATE CONSERVATION ENGINEER

APPROVED: *[Signature]* DATE: 6/25/64  
STATE ADMINISTRATIVE OFFICER

APPROVED: *[Signature]* DATE: 6/25/64  
STATE CONSERVATIONIST

QUARANTEED BY ORDER OF THE STATE TRANSPORTATION BOARD

APPROVED: *[Signature]* DATE: 6/25/64  
CHIEF ENGINEER

**BURKE  
MA 3620**

Pin # 86E939

THESE PLANS ARE SUBJECT TO SUCH ENGINEERING CHANGES AS MAY BE REQUIRED BY THE FEDERAL HIGHWAY ADMINISTRATION OR THE CHIEF ENGINEER. CONSTRUCTION IS TO BE CARRIED ON IN ACCORDANCE WITH THESE PLANS AND THE STANDARD SPECIFICATIONS FOR CONSTRUCTION DATED 1954. FOR USE ON THESE PROJECTS, INCLUDING ALL SUBSEQUENT PROVISIONS AS ARE INCORPORATED IN THESE PLANS.

APPROVED: *[Signature]* DATE: 6/25/64  
CHIEF, PROPERTY ADMINISTRATION