 

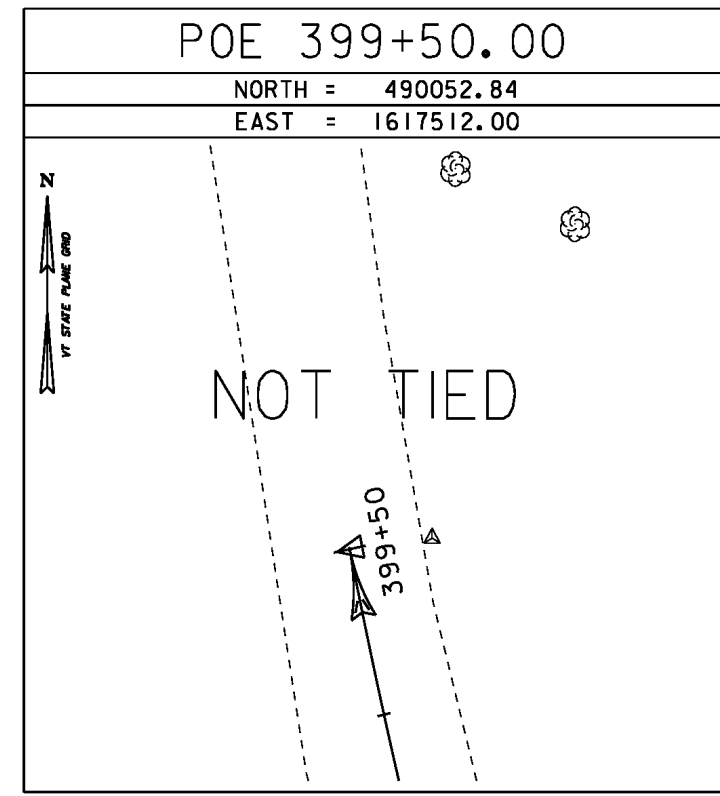
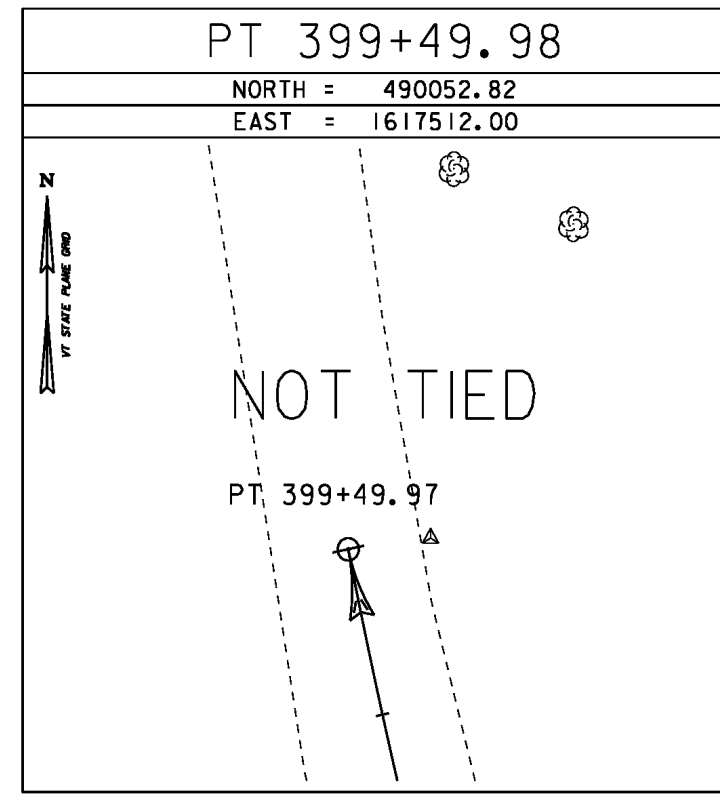
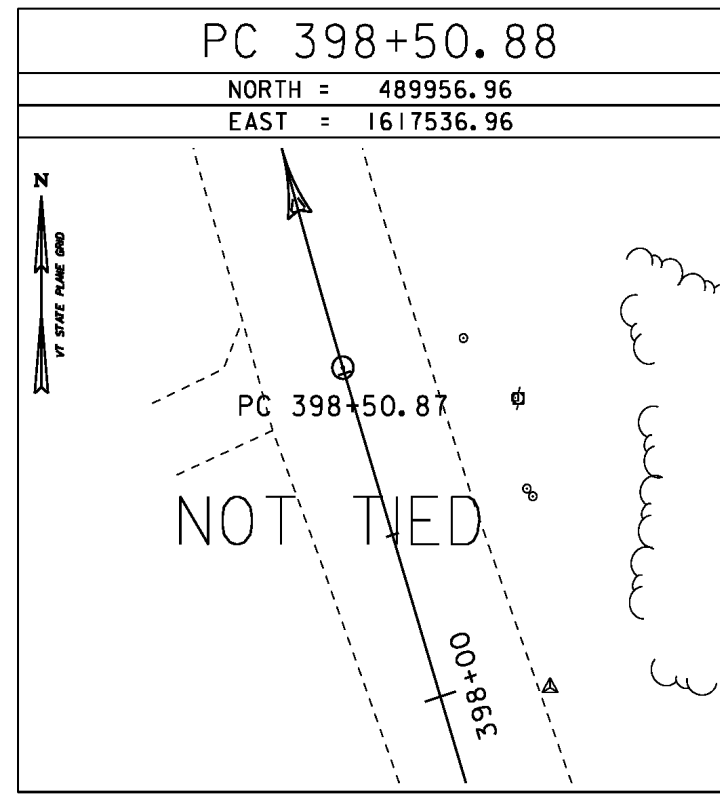


ALIGNMENT TIES

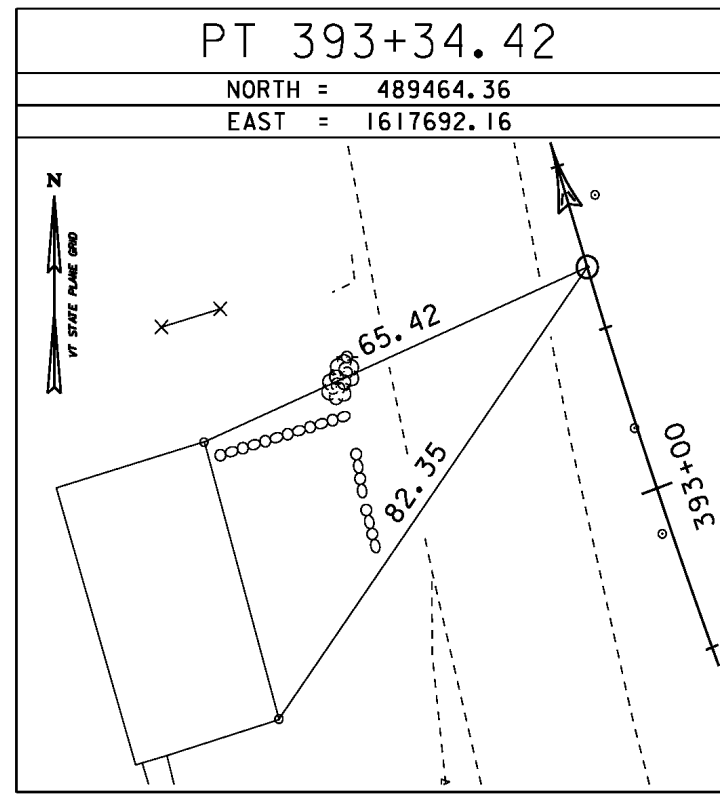

DATUM	
VERTICAL	NAVD 88
HORIZONTAL	NAD 83 (96)
ADJUSTMENT	Compass

PROJECT NAME: Roylton	
PROJECT NUMBER: BRS 0147 (13)	
FILE NAME: 86e055\survey\86e055t1.dgn	PLOT DATE: 12-APR-2017
PROJECT LEADER: C. CARLSON	DRAWN BY: R. Bullock
DESIGNED BY: D. PETERSON	CHECKED BY: C. CARLSON
Bridge 27	TIE SHEET (2) ROW SHEET 20 OF 38