


TOWNS OF GUILFORD-SPRINGFIELD

Pin # 87A028


Project IR 091-1(10)41

Route I91

Date 9/4/2004

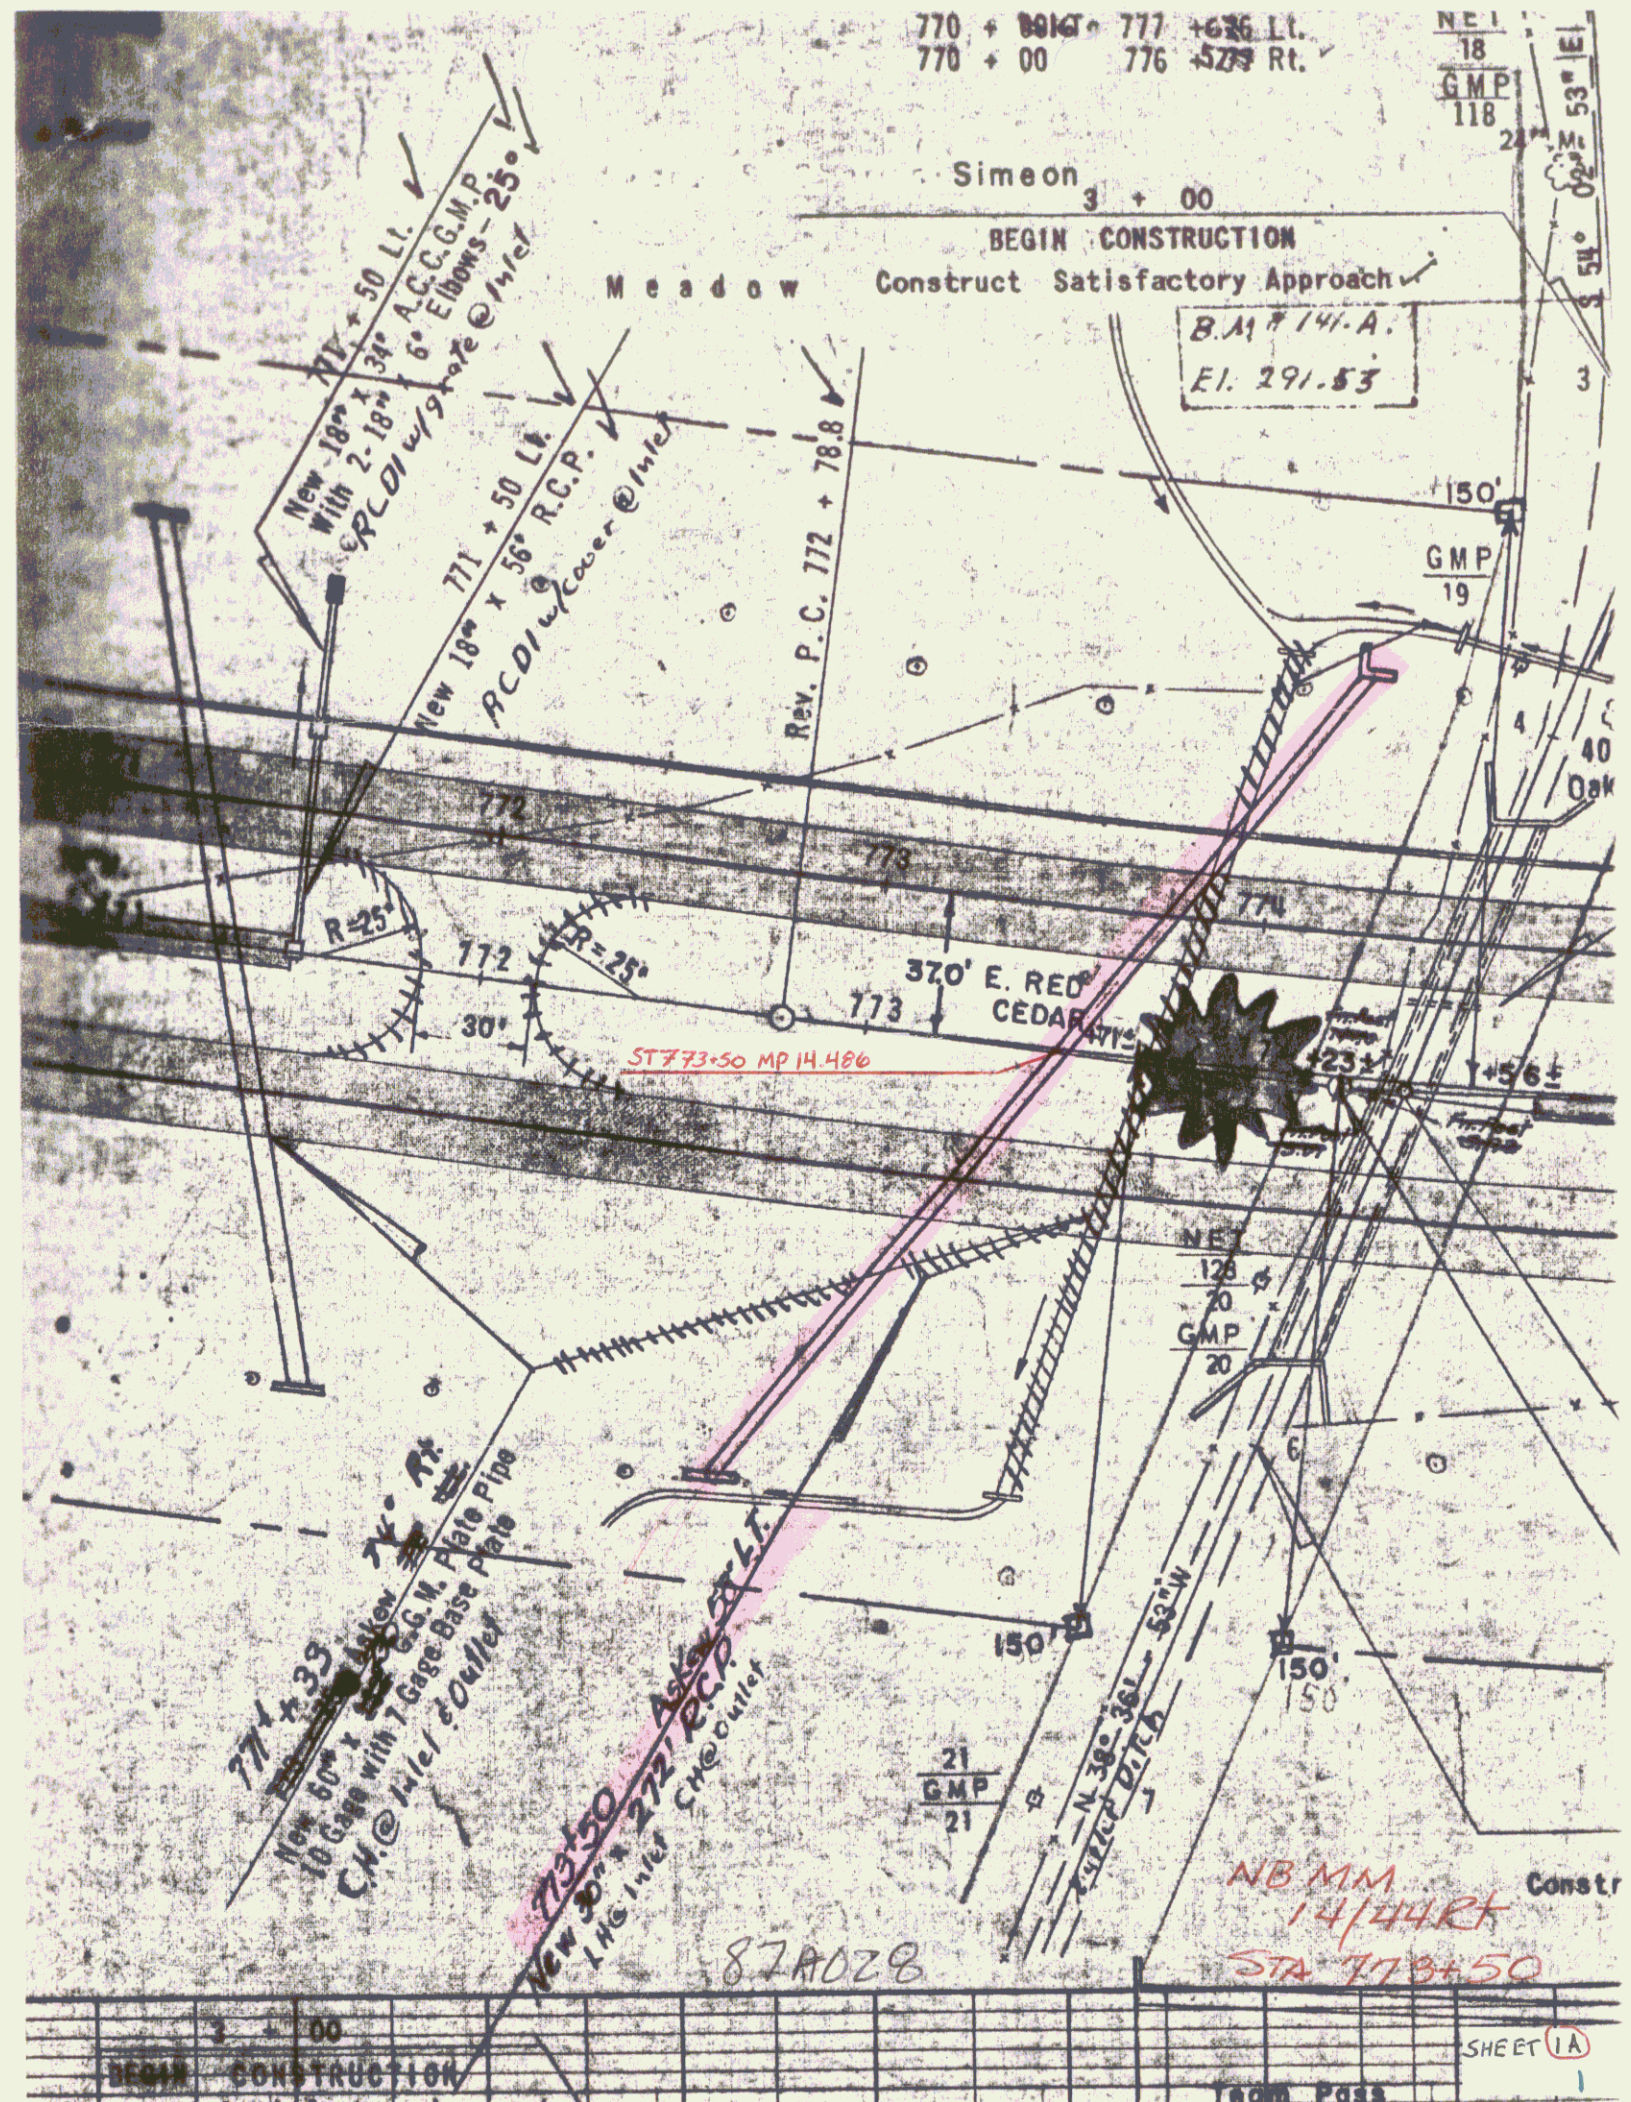



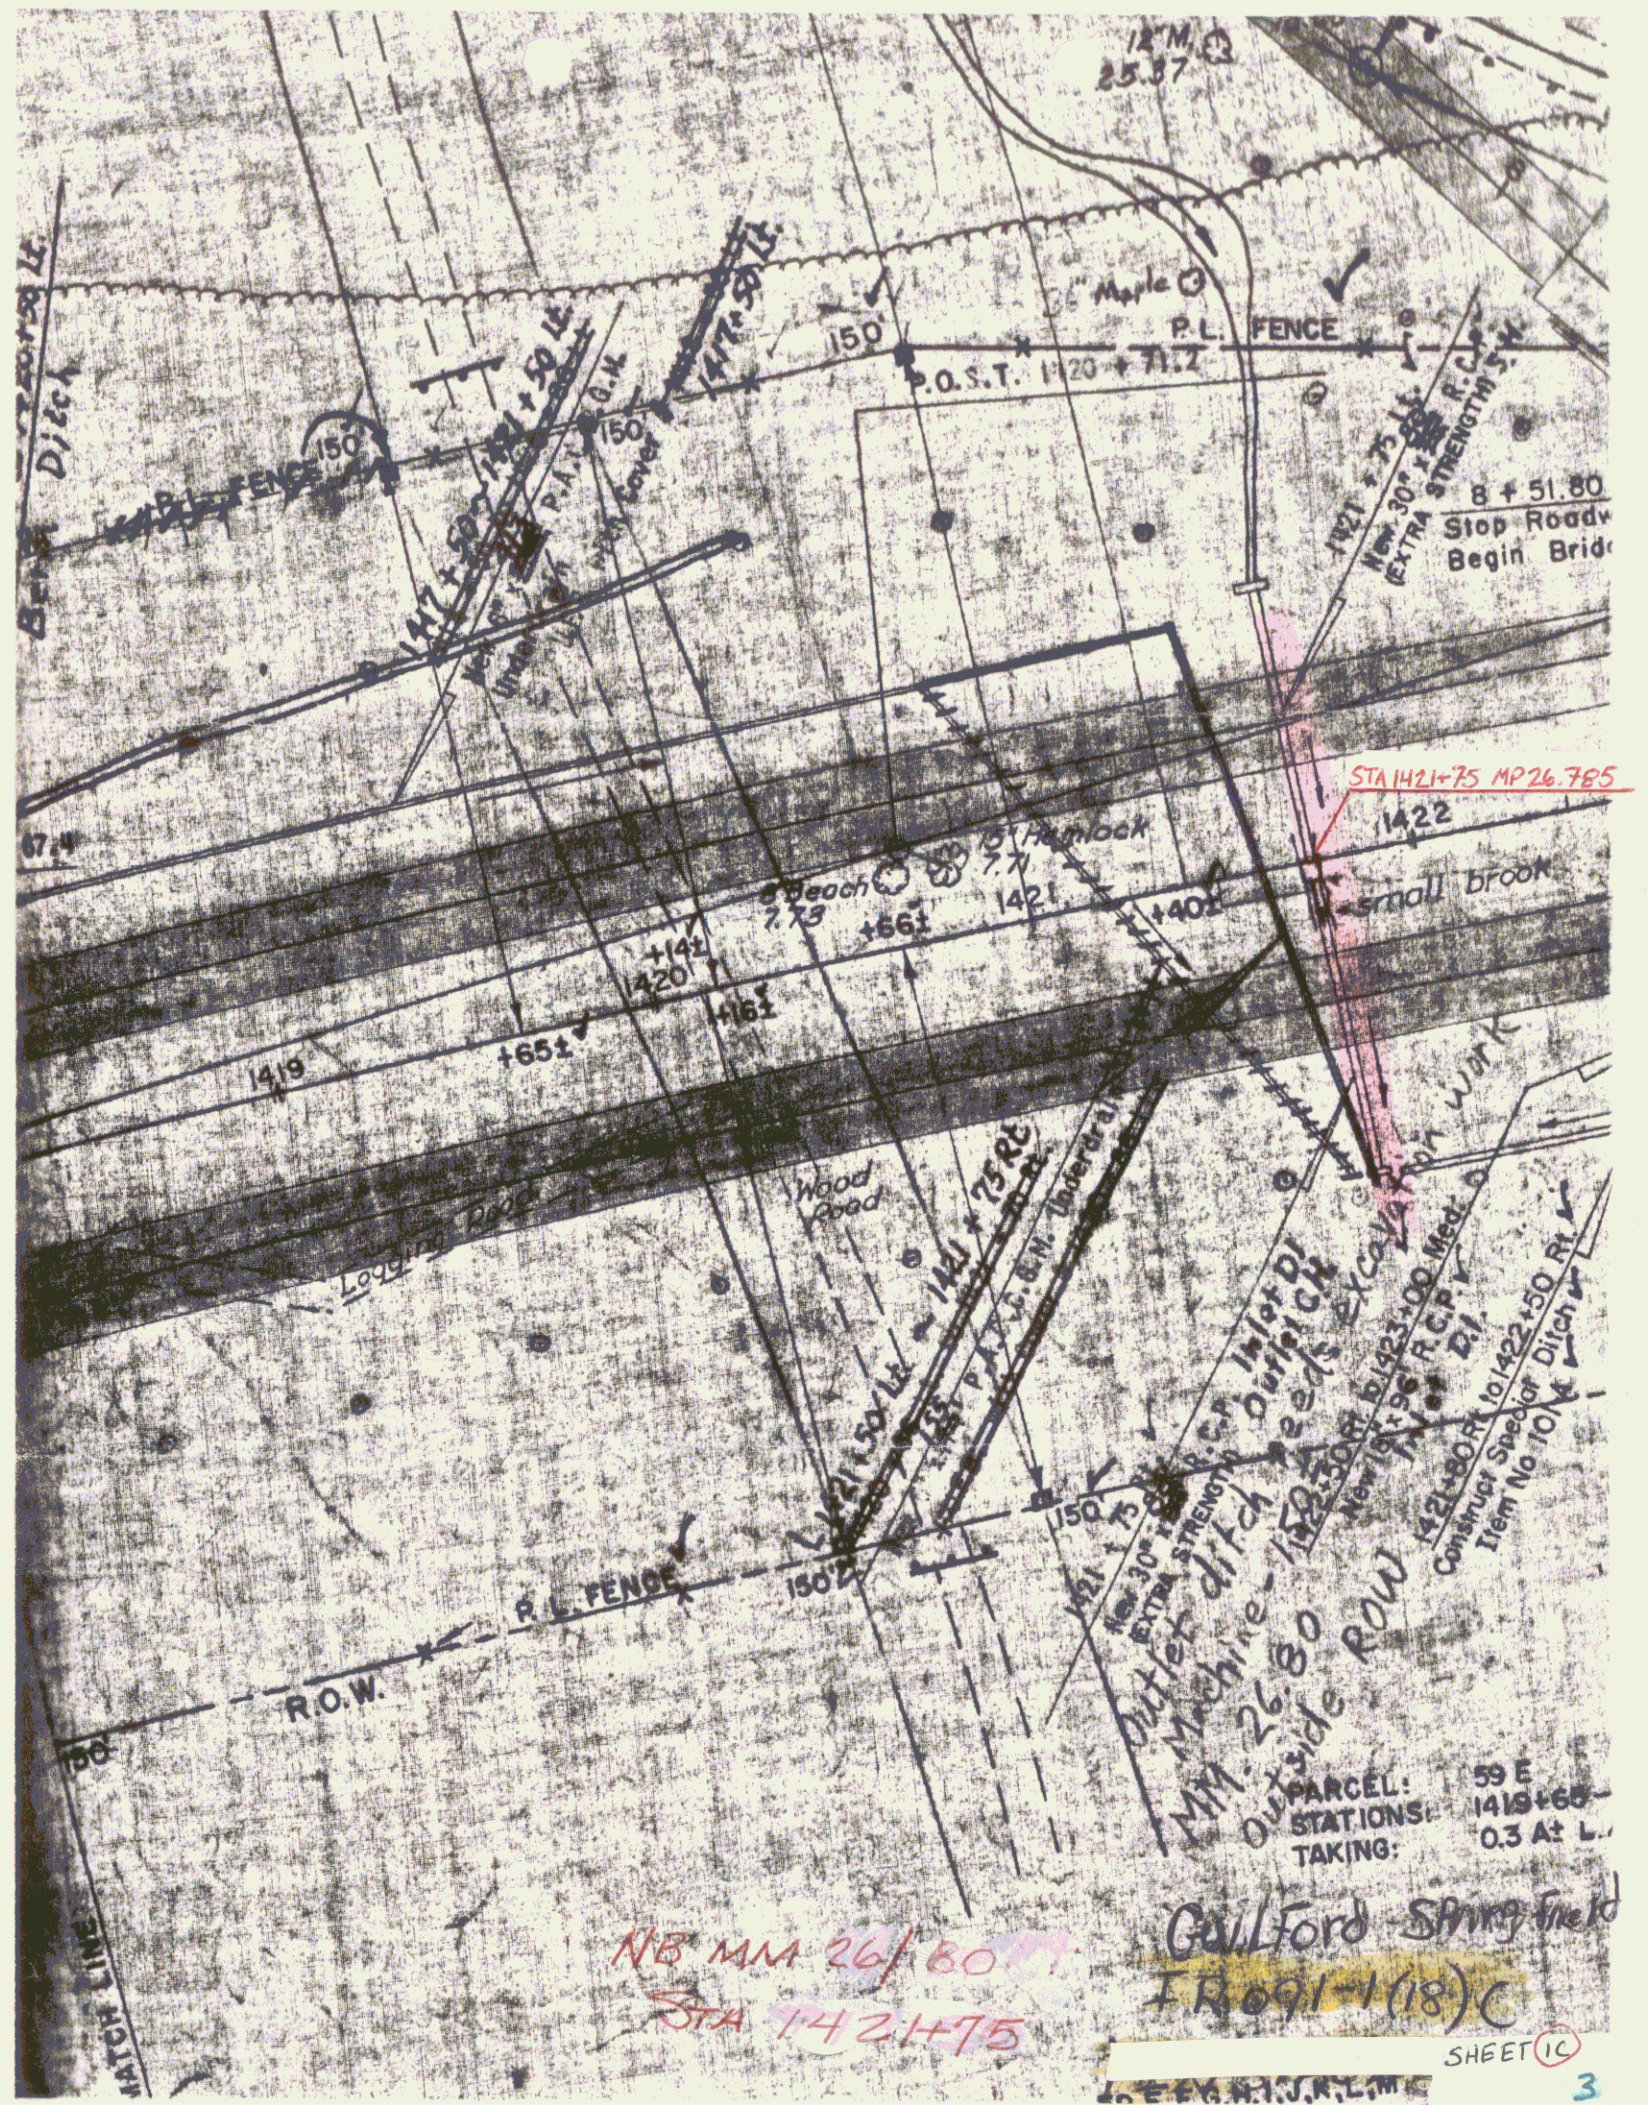

115 MM 26/80  
 STA 1421+75

PARCEL: 59 E  
 STATIONS: 1419+68  
 TAKING: 0.3 A L.  
 GAILFORD SPRINGFIELD  
 FR 091-1(18)C  
 SHEET 10 3