


INDEX OF SHEETS
SEE SHEET # 2

STATE OF VERMONT
AGENCY OF TRANSPORTATION



PROPOSED IMPROVEMENT

TOWN OF MARSHFIELD
COUNTY OF WASHINGTON
U.S. ROUTE 2 - F.A.P.

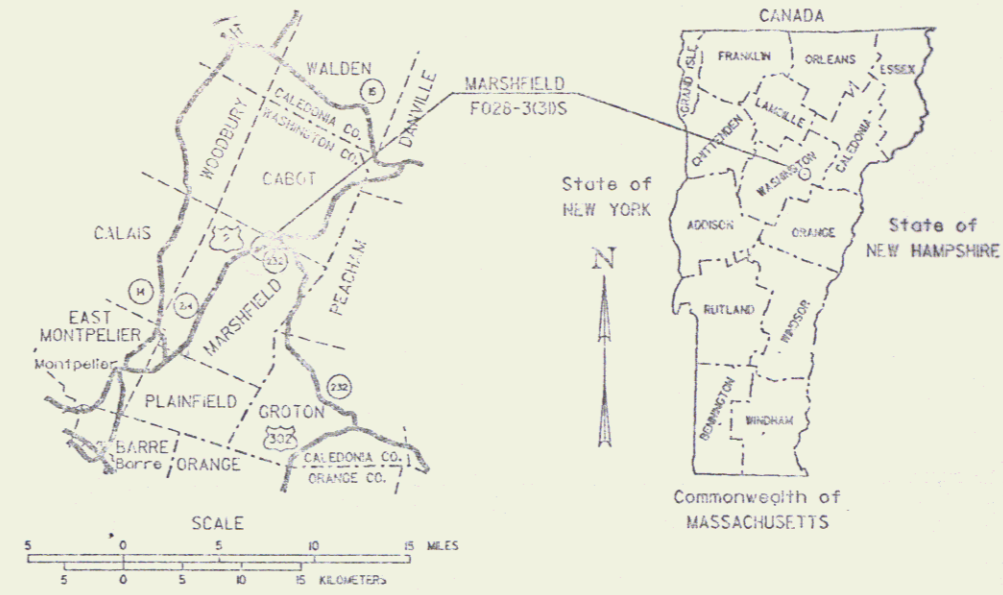

R.O.W. PLANS

BEGINNING AT A POINT APPROXIMATELY 7.333 MILES EASTERLY OF THE PLAINFIELD - MARSHFIELD TOWN LINE AND EXTENDING EASTERLY ALONG U.S. ROUTE 2 FOR A DISTANCE OF 3685.44 FEET .

LENGTH OF ROADWAY 3685.44 FEET= 0.698 MILES
LENGTH OF PROJECT 3685.44 FEET= 0.698 MILES
LENGTH OF R.O.W. PROJECT 898.00 FEET= 0.170 MILES

WORK TO BE PERFORMED UNDER THIS PROJECT INCLUDES RESURFACING OF AN EXISTING HIGHWAY, WITH A LEVELING COURSE TO CORRECT SUPERELEVATION DEFICIENCIES AND A 1 1/4" BITUMINOUS CONCRETE OVERLAY, APPLYING NEW PAVEMENT MARKINGS AND REHABILITATION TO GUARD RAIL AND SIGNS.

BEGIN R.O.W. PROJECT
F 028-3(31)S 80+79 34' LT.


END R.O.W. PROJECT
F 028-3(31)S STA. 89+77 43' RT.

CONVENTIONAL SIGNS

COUNTY LINE	---
TOWN LINE	---
LIMIT OF ACCESS	---
POINT OF ACCESS	X
FENCE LINE	---
STONE WALL	---
TRAVEL WAY	---
RAILROAD	---
SURVEY LINE	---
CULVERT	---
POWER POLE	○
TELEPHONE POLE	○
TREES	⊗
CONTROL OF ACCESS	---
PROPERTY LINE	---
FLYING BUTTRESS	---
SLOPE GRADES	---
TOP OF CUT	---
TOE OF SLOPE	---

DATUM

VERTICAL	USGS 1929
HORIZONTAL	N/A

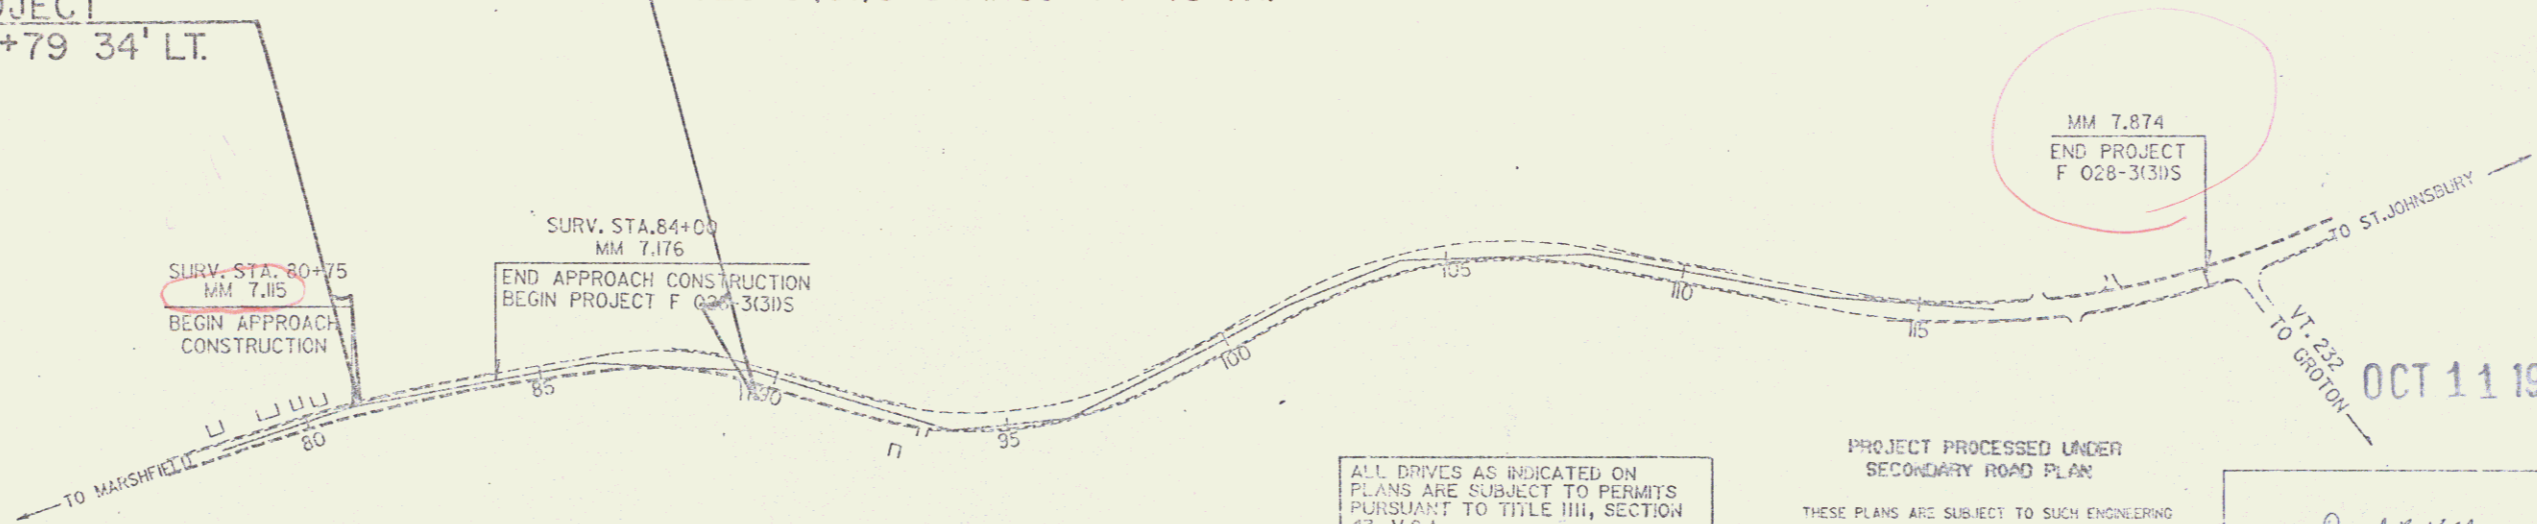

ALL DRIVES AS INDICATED ON PLANS ARE SUBJECT TO PERMITS PURSUANT TO TITLE III, SECTION 43, V.S.A.

0 200 400
SCALE IN FEET

PROJECT PROCESSED UNDER
SECONDARY ROAD PLAN

THESE PLANS ARE SUBJECT TO SUCH ENGINEERING CHANGES AS MAY BE REQUIRED BY THE FEDERAL HIGHWAY ADMINISTRATION OR THE CHIEF ENGINEER. CONSTRUCTION IS TO BE CARRIED ON IN ACCORDANCE WITH THESE PLANS AND THE STANDARD SPECIFICATIONS FOR CONSTRUCTION DATED 1985 AS APPROVED BY THE FEDERAL HIGHWAY ADMINISTRATION ON NOVEMBER 21, 1985 FOR USE ON THIS PROJECT, INCLUDING ALL SUBSEQUENT REVISIONS AND SUCH REVISED SPECIFICATIONS AND SPECIAL PROVISIONS AS ARE INCORPORATED IN THESE PLANS.

APPROVED: *David H. Kelly* DATE: 9/29/88
Dir., Dept. of Engineering and Construction

APPROVED: *James A. ...* DATE: 10/3/88
Chief, Property Administration

MARSHFIELD
Project NO F 028-3(31)S
R.O.W. SHEET 1 OF 11

Pin # 87B200

OCT 11 1989

