



BM*9
CHIS. ON N.W.
CORNER
ELEV. 1054.17

PI 113+08.79
06'-04"-30" LT.

BM *5
CHIS. O
ON LEDGE
ELEV. 1054.48

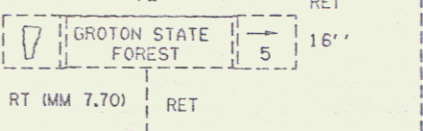

APPROXIMATE LOCATION OF BURIED
CABLE TELEPHONE CABLE
DO NOT DISTURB

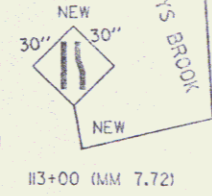

SEP 11 1988

DATUM
VERTICAL USGS 1928
HORIZONTAL N/A

0 20 40
SCALE IN FEET

ROW PLANS			
SURVEYED BY	MOREAU	DATE	01/88
DRAWN BY	MELINIER	DATE	04/88
SQUAD LEADER	BOYD		
DESIGN FILE NO.	876202	DATE PLOTTED	09/11/88
MARSHFIELD F028-3431S			
SHEET 9		OF 11 SHEETS	

8