


RESEARCH DRAWER SET

STATE OF VERMONT  
AGENCY OF TRANSPORTATION




PROPOSED IMPROVEMENT  
COLCHESTER - ESSEX  
COUNTY OF CHITTENDEN  
VT ROUTE 15(FAP)

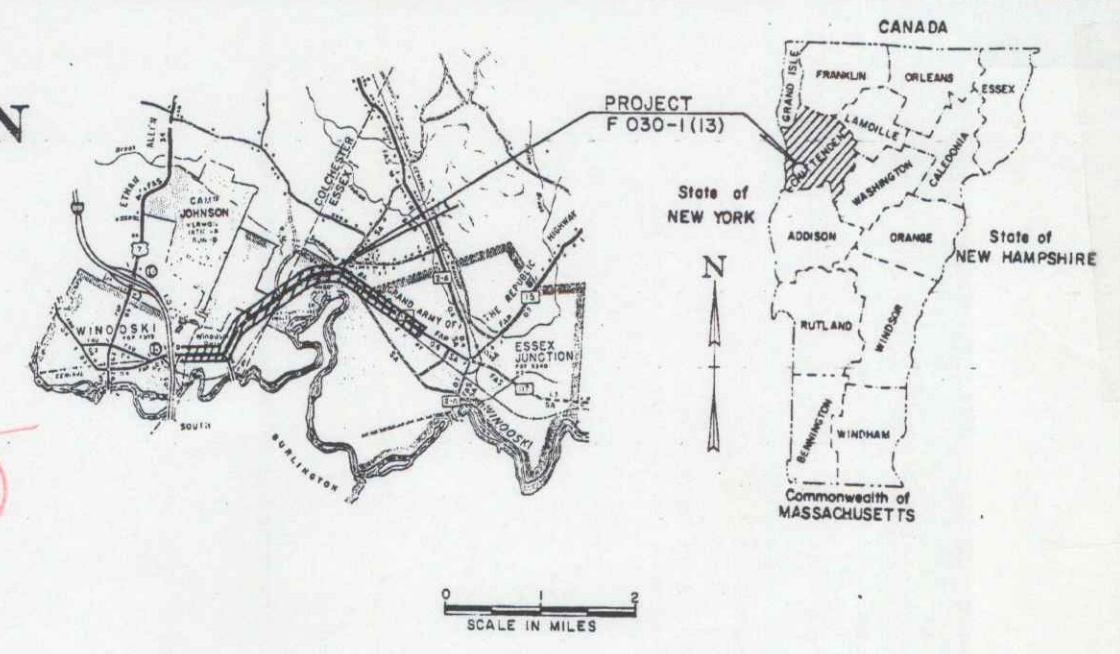

BEGINNING AT A POINT ON VT. RTE 15 AT THE WINOOSKI-COLCHESTER TOWN LINE AND EXTENDING EASTERLY FOR 2.931 MILES.  
LENGTH OF PROJECT = 15477.00 FT = 2.931 MILES  
LENGTH OF R.O.W. PROJECT = 809.00 FT = 0.153 MILES  
WORK TO BE DONE UNDER THIS PROJECT INCLUDES HIGHWAY RESURFACING WITH UPGRADING OF GUARD RAIL, DRAINAGE FEATURES, SIGNS, SIGNALS, MARKINGS AND TURN LANES.

R.O.W. PLANS

Colchester - MP 0000 T/L - M.P. 0136  
Essex - MP 0000 T/L - M.P. 0161

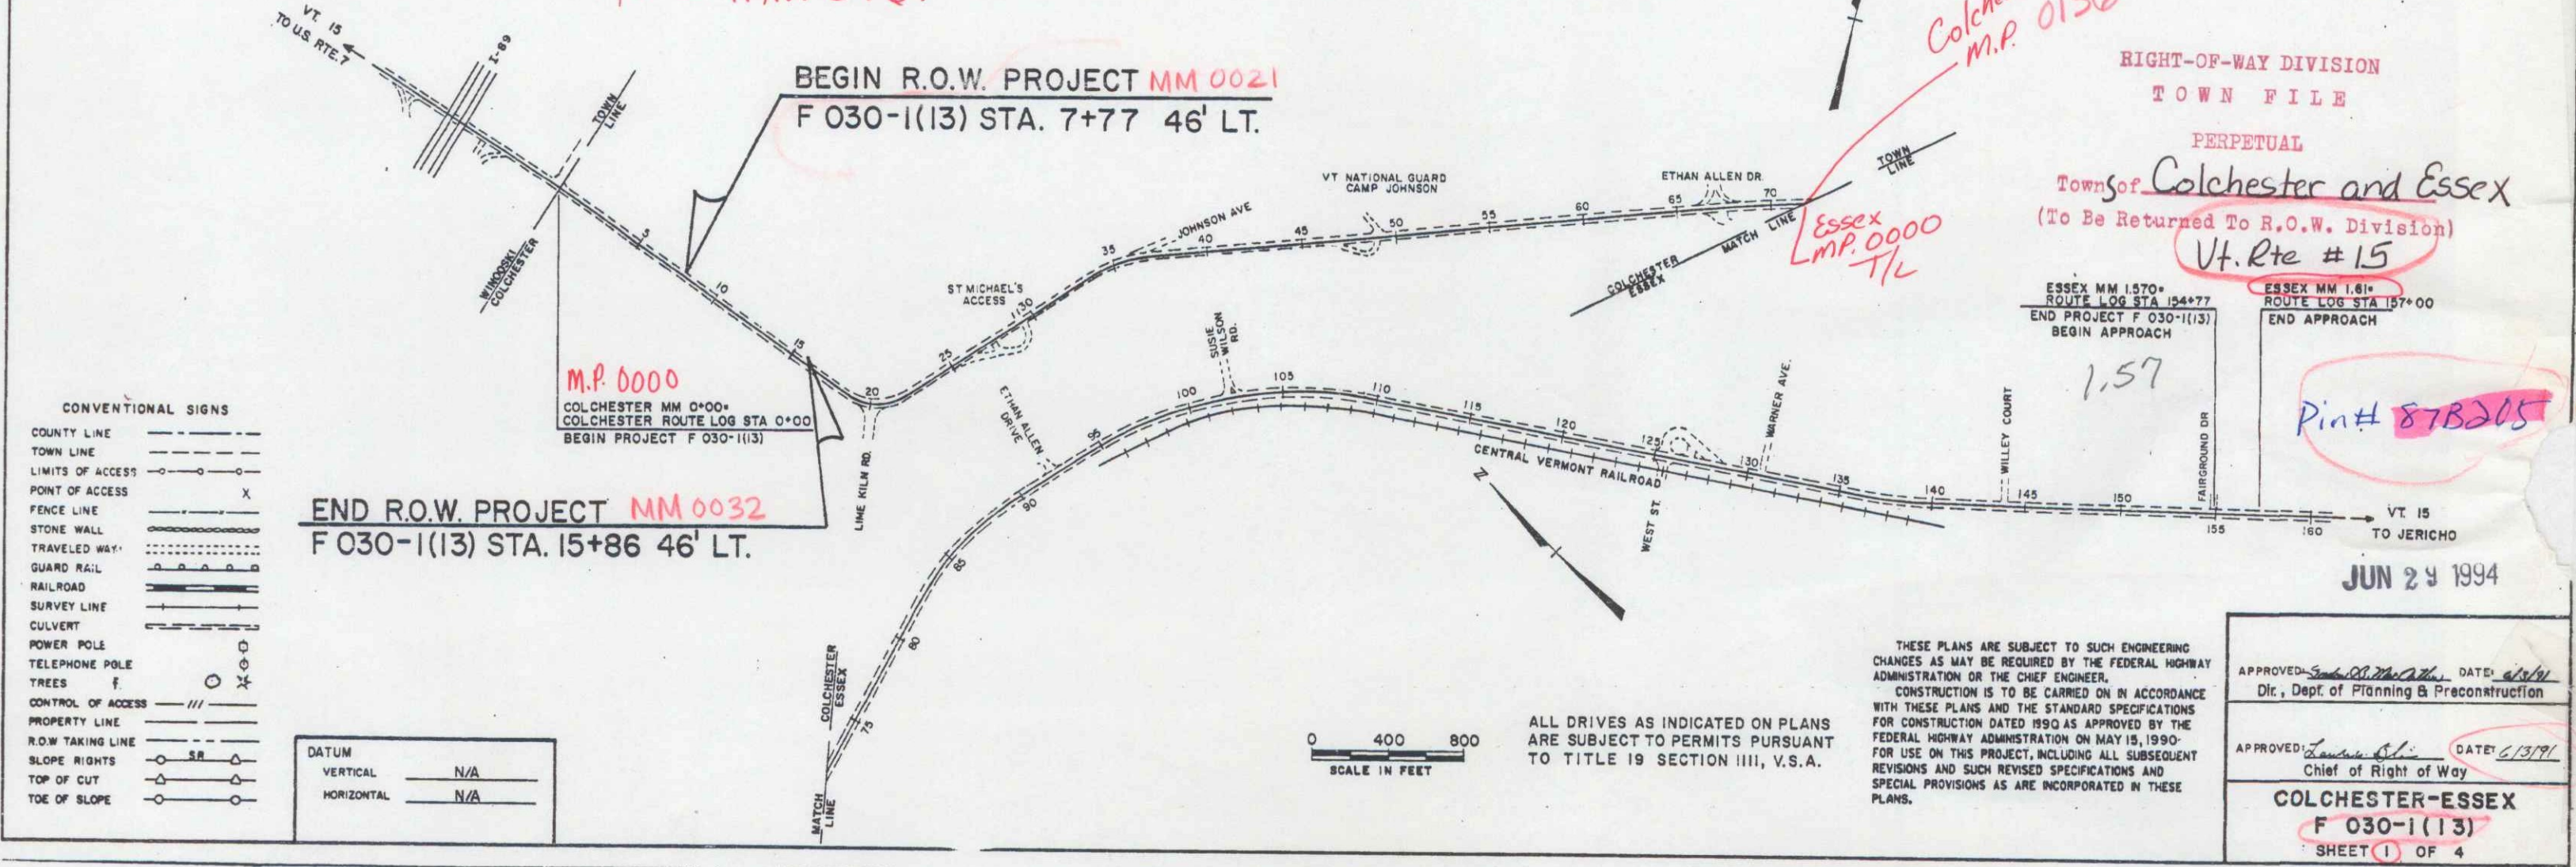

RIGHT-OF-WAY DIVISION  
TOWN FILE  
PERPETUAL  
Towns of Colchester and Essex  
(To Be Returned To R.O.W. Division)  
VT. Rte # 15

ESSEX MM 1570+  
ROUTE LOG STA 154+77  
END PROJECT F 030-1(13)  
BEGIN APPROACH

ESSEX MM 1581+  
ROUTE LOG STA 157+00  
END APPROACH

Pin # 87B205

JUN 24 1994

THESE PLANS ARE SUBJECT TO SUCH ENGINEERING CHANGES AS MAY BE REQUIRED BY THE FEDERAL HIGHWAY ADMINISTRATION OR THE CHIEF ENGINEER. CONSTRUCTION IS TO BE CARRIED ON IN ACCORDANCE WITH THESE PLANS AND THE STANDARD SPECIFICATIONS FOR CONSTRUCTION DATED 1990 AS APPROVED BY THE FEDERAL HIGHWAY ADMINISTRATION ON MAY 15, 1990 FOR USE ON THIS PROJECT, INCLUDING ALL SUBSEQUENT REVISIONS AND SUCH REVISED SPECIFICATIONS AND SPECIAL PROVISIONS AS ARE INCORPORATED IN THESE PLANS.

APPROVED: *[Signature]* DATE: 6/15/94  
Dir., Dept. of Planning & Preconstruction

APPROVED: *[Signature]* DATE: 6/15/94  
Chief of Right of Way

COLCHESTER-ESSEX  
F 030-1(13)  
SHEET (1) OF 4

ALL DRIVES AS INDICATED ON PLANS ARE SUBJECT TO PERMITS PURSUANT TO TITLE 19 SECTION IIII, V.S.A.