

Remove & Reset Curb  
 12+00~16+00 Lt  
 12+00~12+65 Rt  
 12+95~14+45 Rt  
 17+00~18+00 Rt (Median)  
 5" Portland Cement Concrete Sidewalk  
 12+00~16+00 Lt  
 12+65~12+95 Rt (drive ramp)


Removal of Existing Sidewalk  
 (to be paid as Removal of  
 Concrete or Masonry)  
 12+00~16+00 Lt  
 12+65~12+95 Rt

Vertical Granite Curb  
 12+65~12+70 Rt  
 12+90~12+95 Rt sloped ends

Remove Existing Curb  
 12+65~12+70 Rt  
 12+90~12+95 Rt

Granite Slope Edging  
 (New Median)  
 12+00~12+75 Rt  
 12+75~17+00 Lt & Rt  
 Removing Small Trees  
 12+00 Lt (12' Locust)

END R.O.W. PROJECT  
 F030-1(13) STA. 15+86 46' LT.

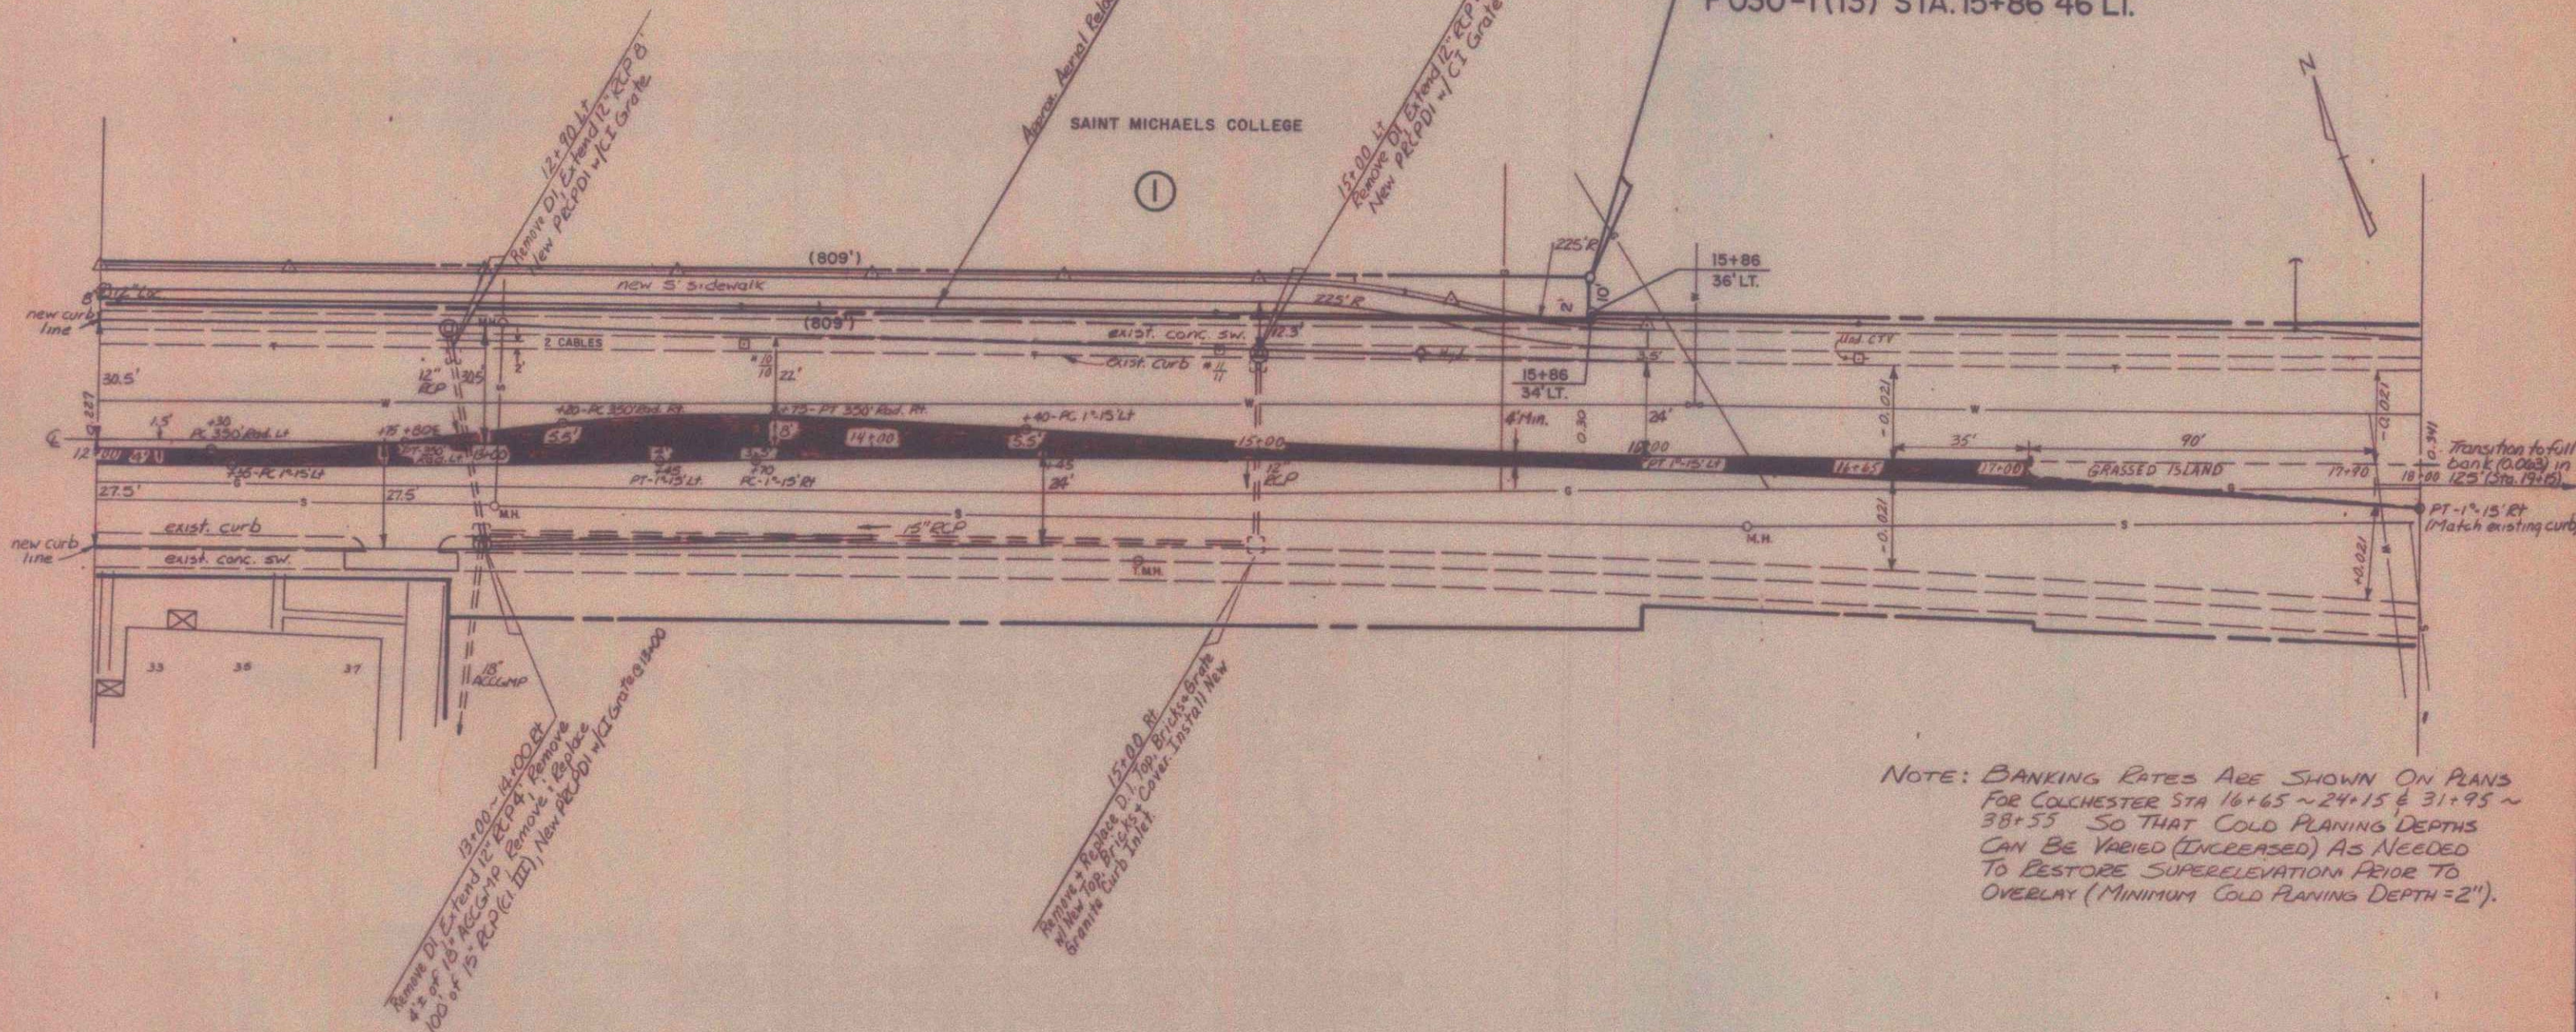

DATUM  
 VERTICAL \_\_\_\_\_  
 HORIZONTAL \_\_\_\_\_

0 20 40  
 SCALE IN FEET

COLCHESTER MM 0.227-0341  
 ROUTE LOG 12+00-18+00  
 SURVEYED BY \_\_\_\_\_ DATE \_\_\_\_\_  
 DRAWN BY AS BUILT DATE 1958  
 TRACED BY JANAWICZ DATE 2/88  
 COLCHESTER-ESSEX  
 PROJ. F NO. 030-1(13)  
 SHEET 4 OF 4  
 19 OF 144

This sheet for R.O.W. information only.