



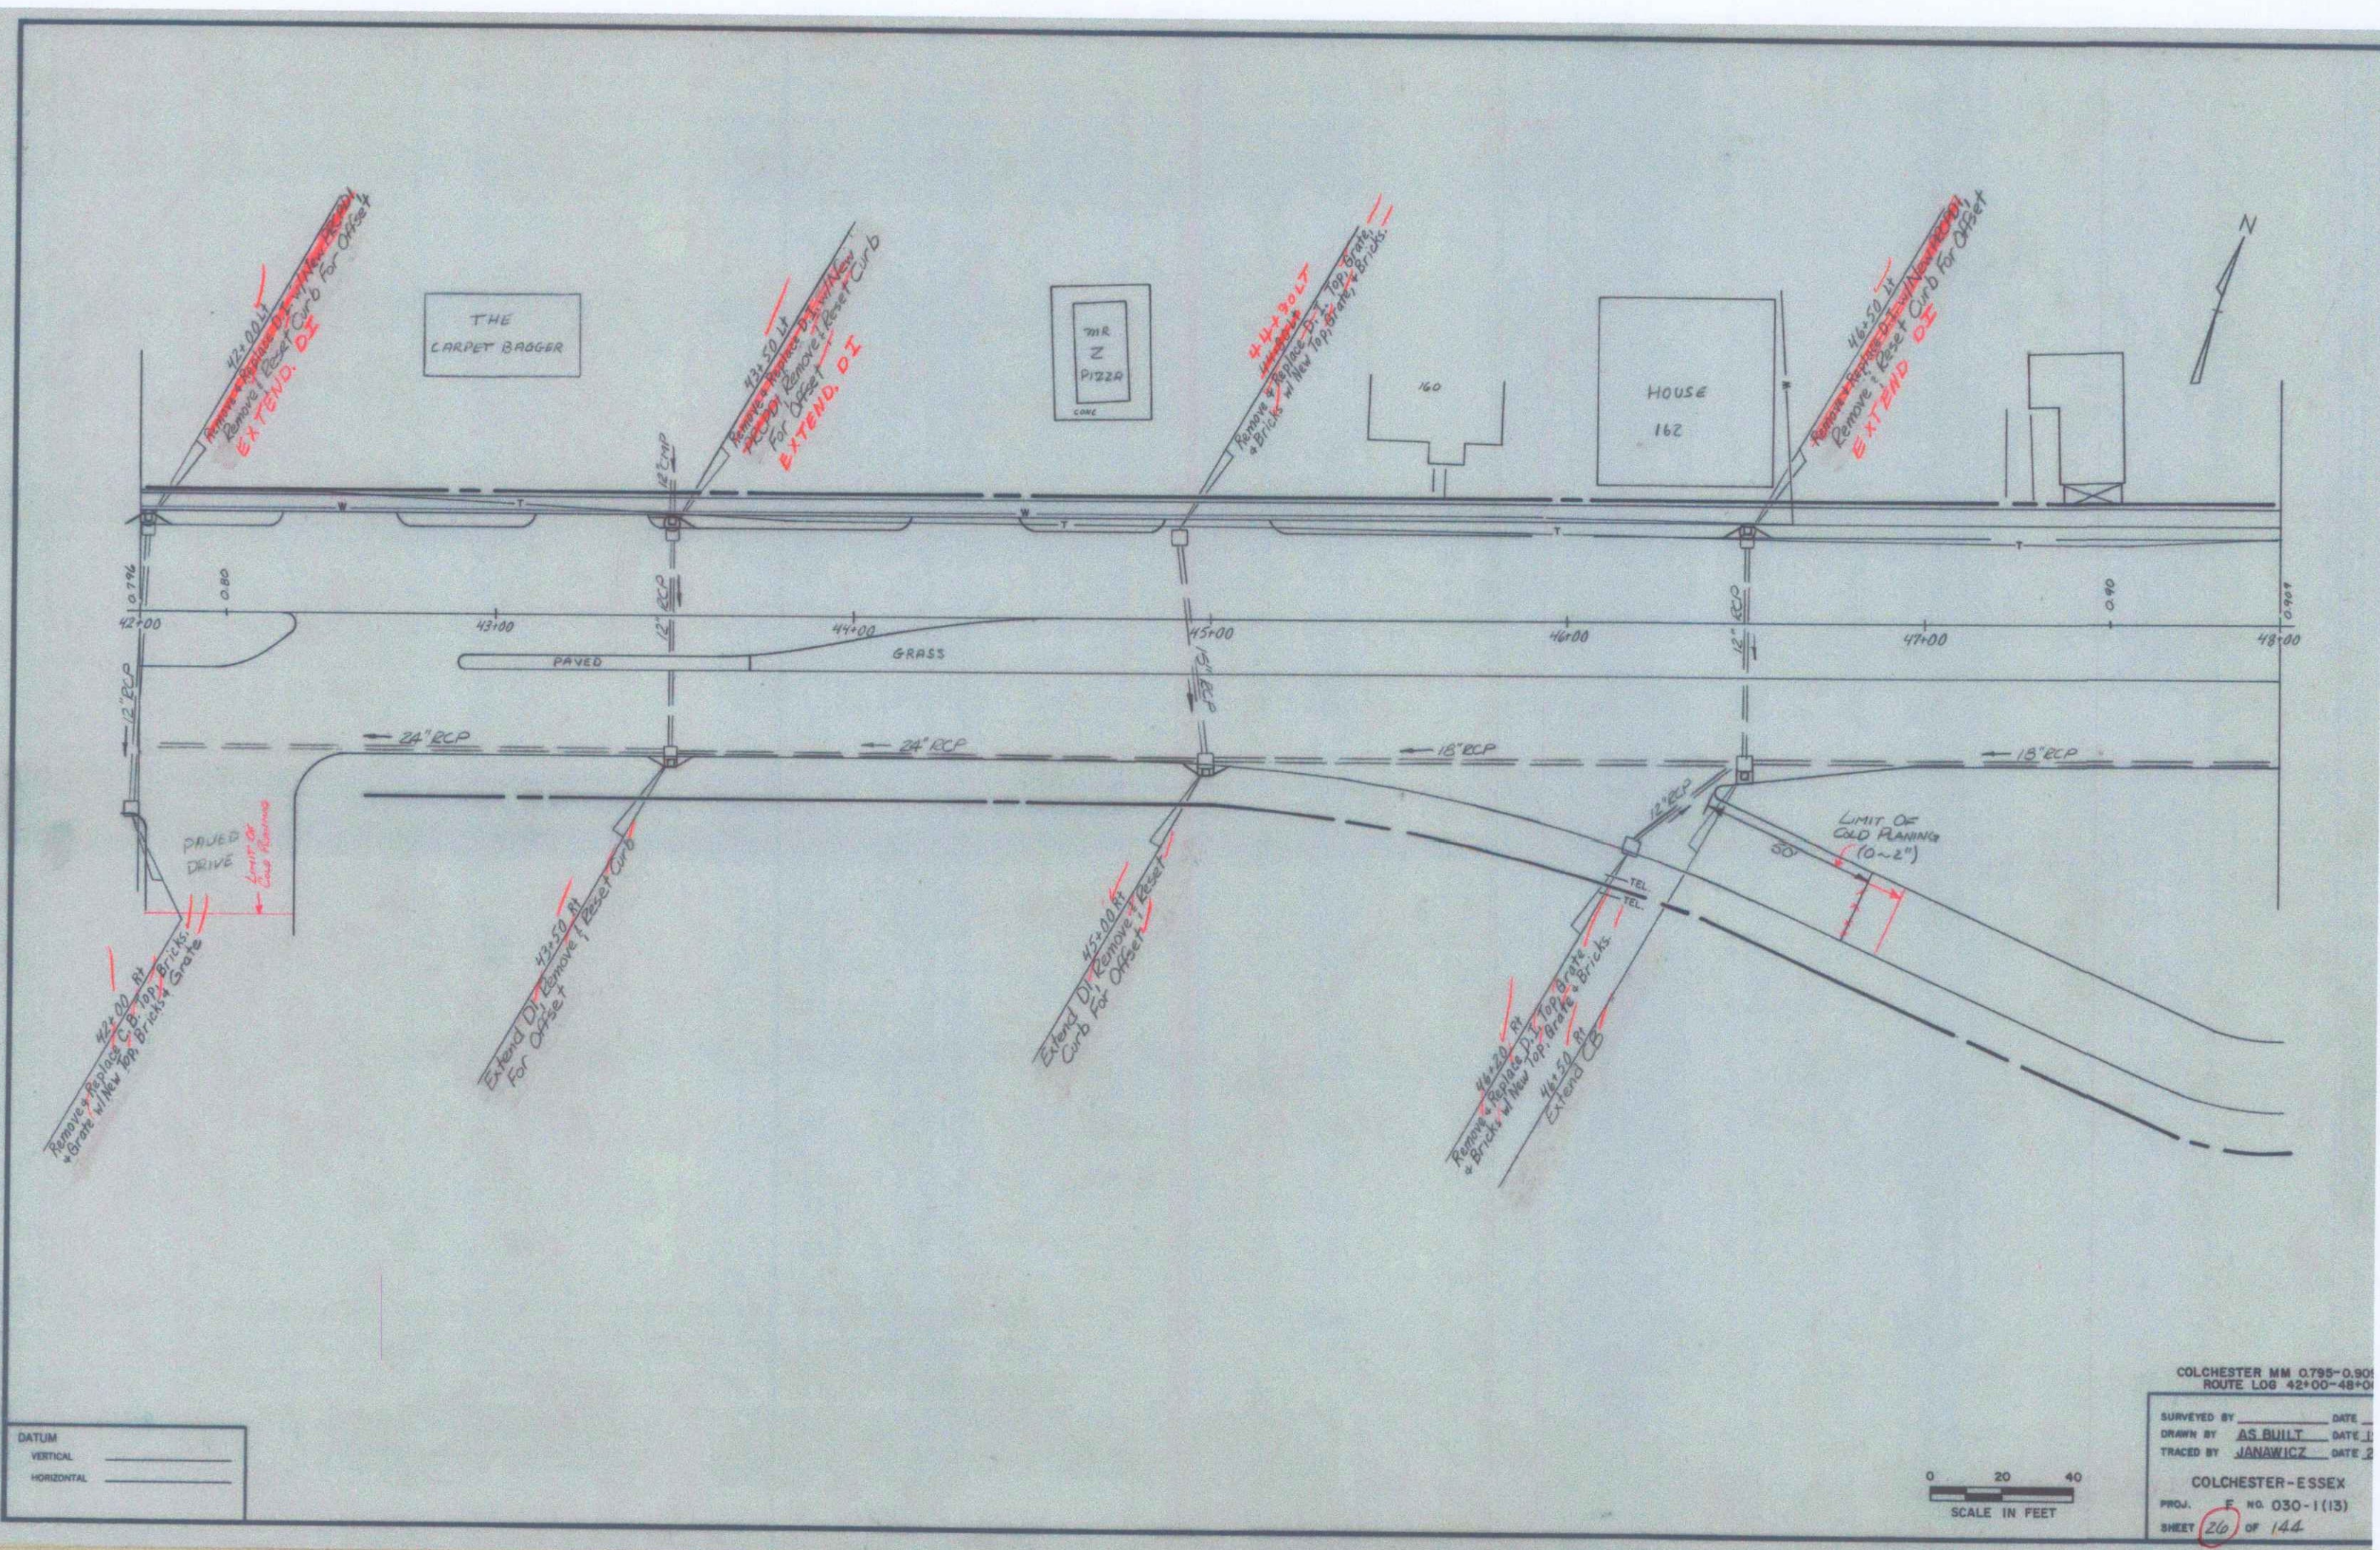

COLCHESTER MM 0.795-0.901
ROUTE LOG 42+00-48+00

SURVEYED BY	DATE
DRAWN BY AS BUILT	DATE
TRACED BY JANAWICZ	DATE

COLCHESTER-ESSEX
PROJ. F. NO. 030-1 (13)
SHEET 20 OF 144

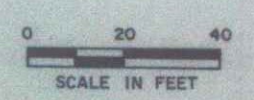

DATUM
VERTICAL _____
HORIZONTAL _____