


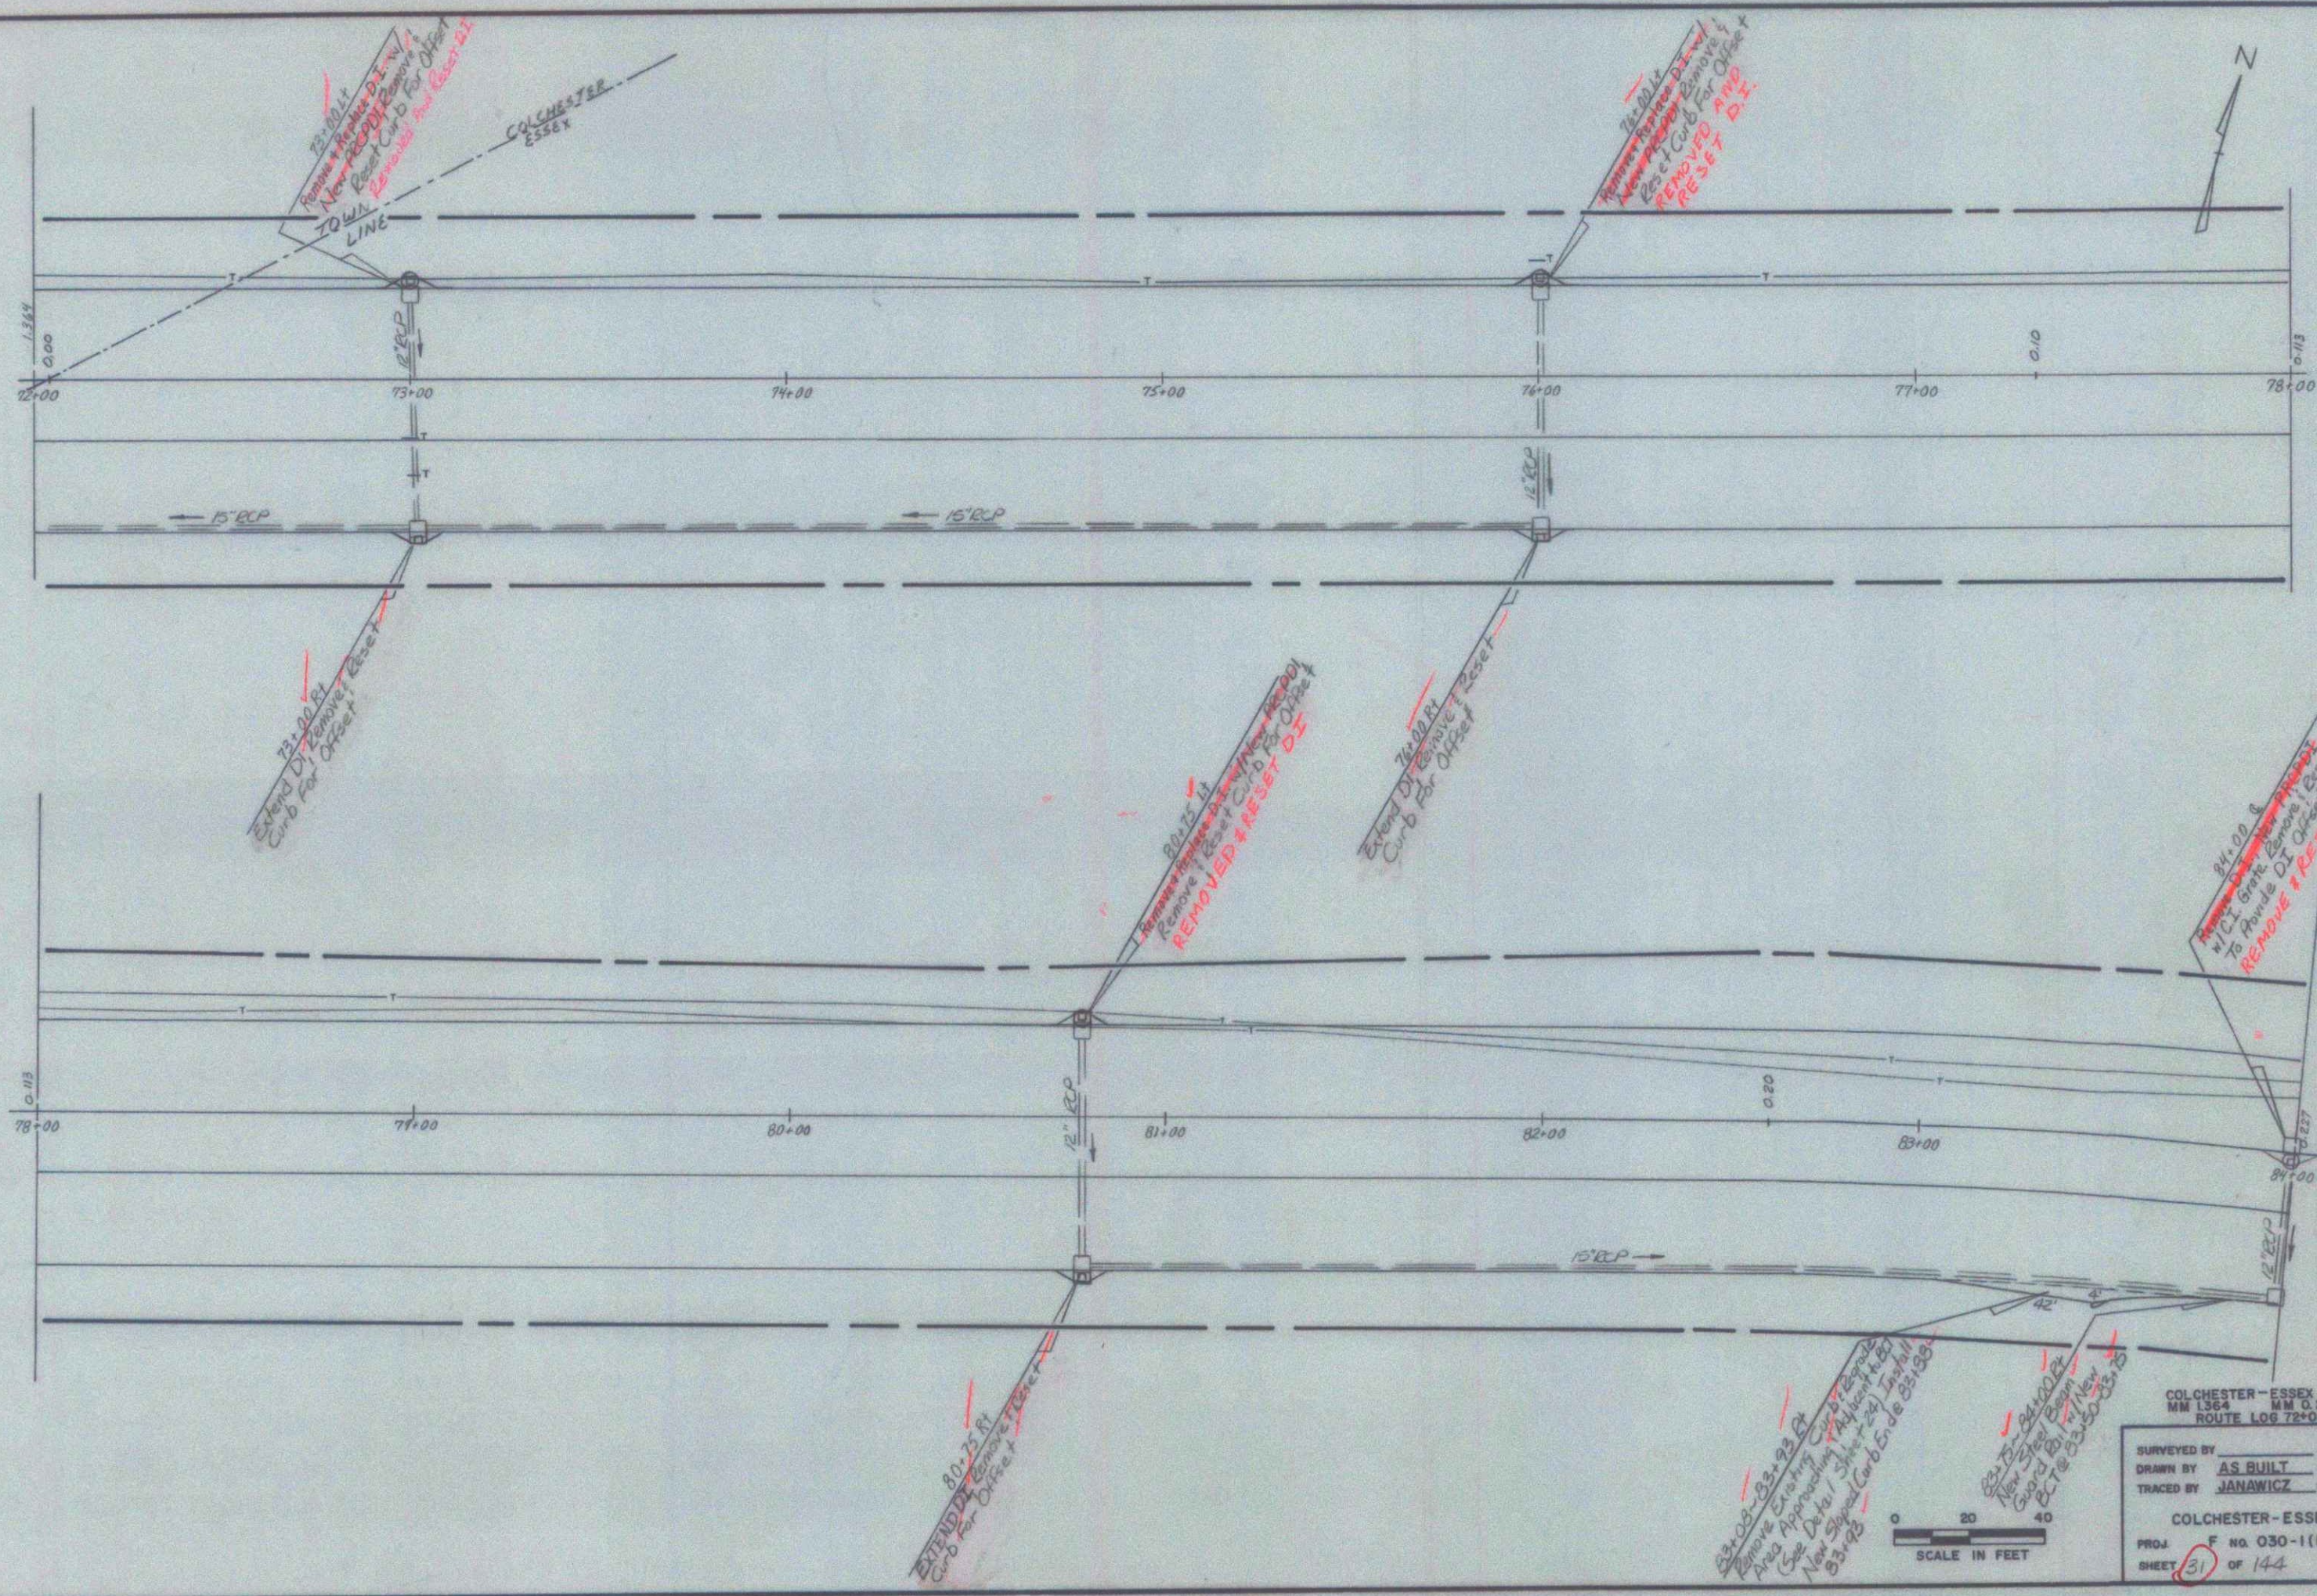

COLCHESTER - ESSEX
 MM 1364 MM 0.227
 ROUTE LOG 72+00-84+00

SURVEYED BY	DATE
DRAWN BY	DATE 1958
TRACED BY	DATE 2/58

COLCHESTER - ESSEX
 PROJ. F. NO. 030-1(13)
 SHEET 31 OF 144