


VILLAGE OF ESSEX
TOWN OF ESSEX

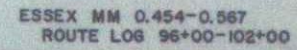

SURVEYED BY _____ DATE _____
DRAWN BY AS BUILT DATE 1958
TRACED BY JANAWICZ DATE 2/88

COLCHESTER - ESSEX

PROJ. F NO. 030-1 (13)

SHEET 33 OF 144