



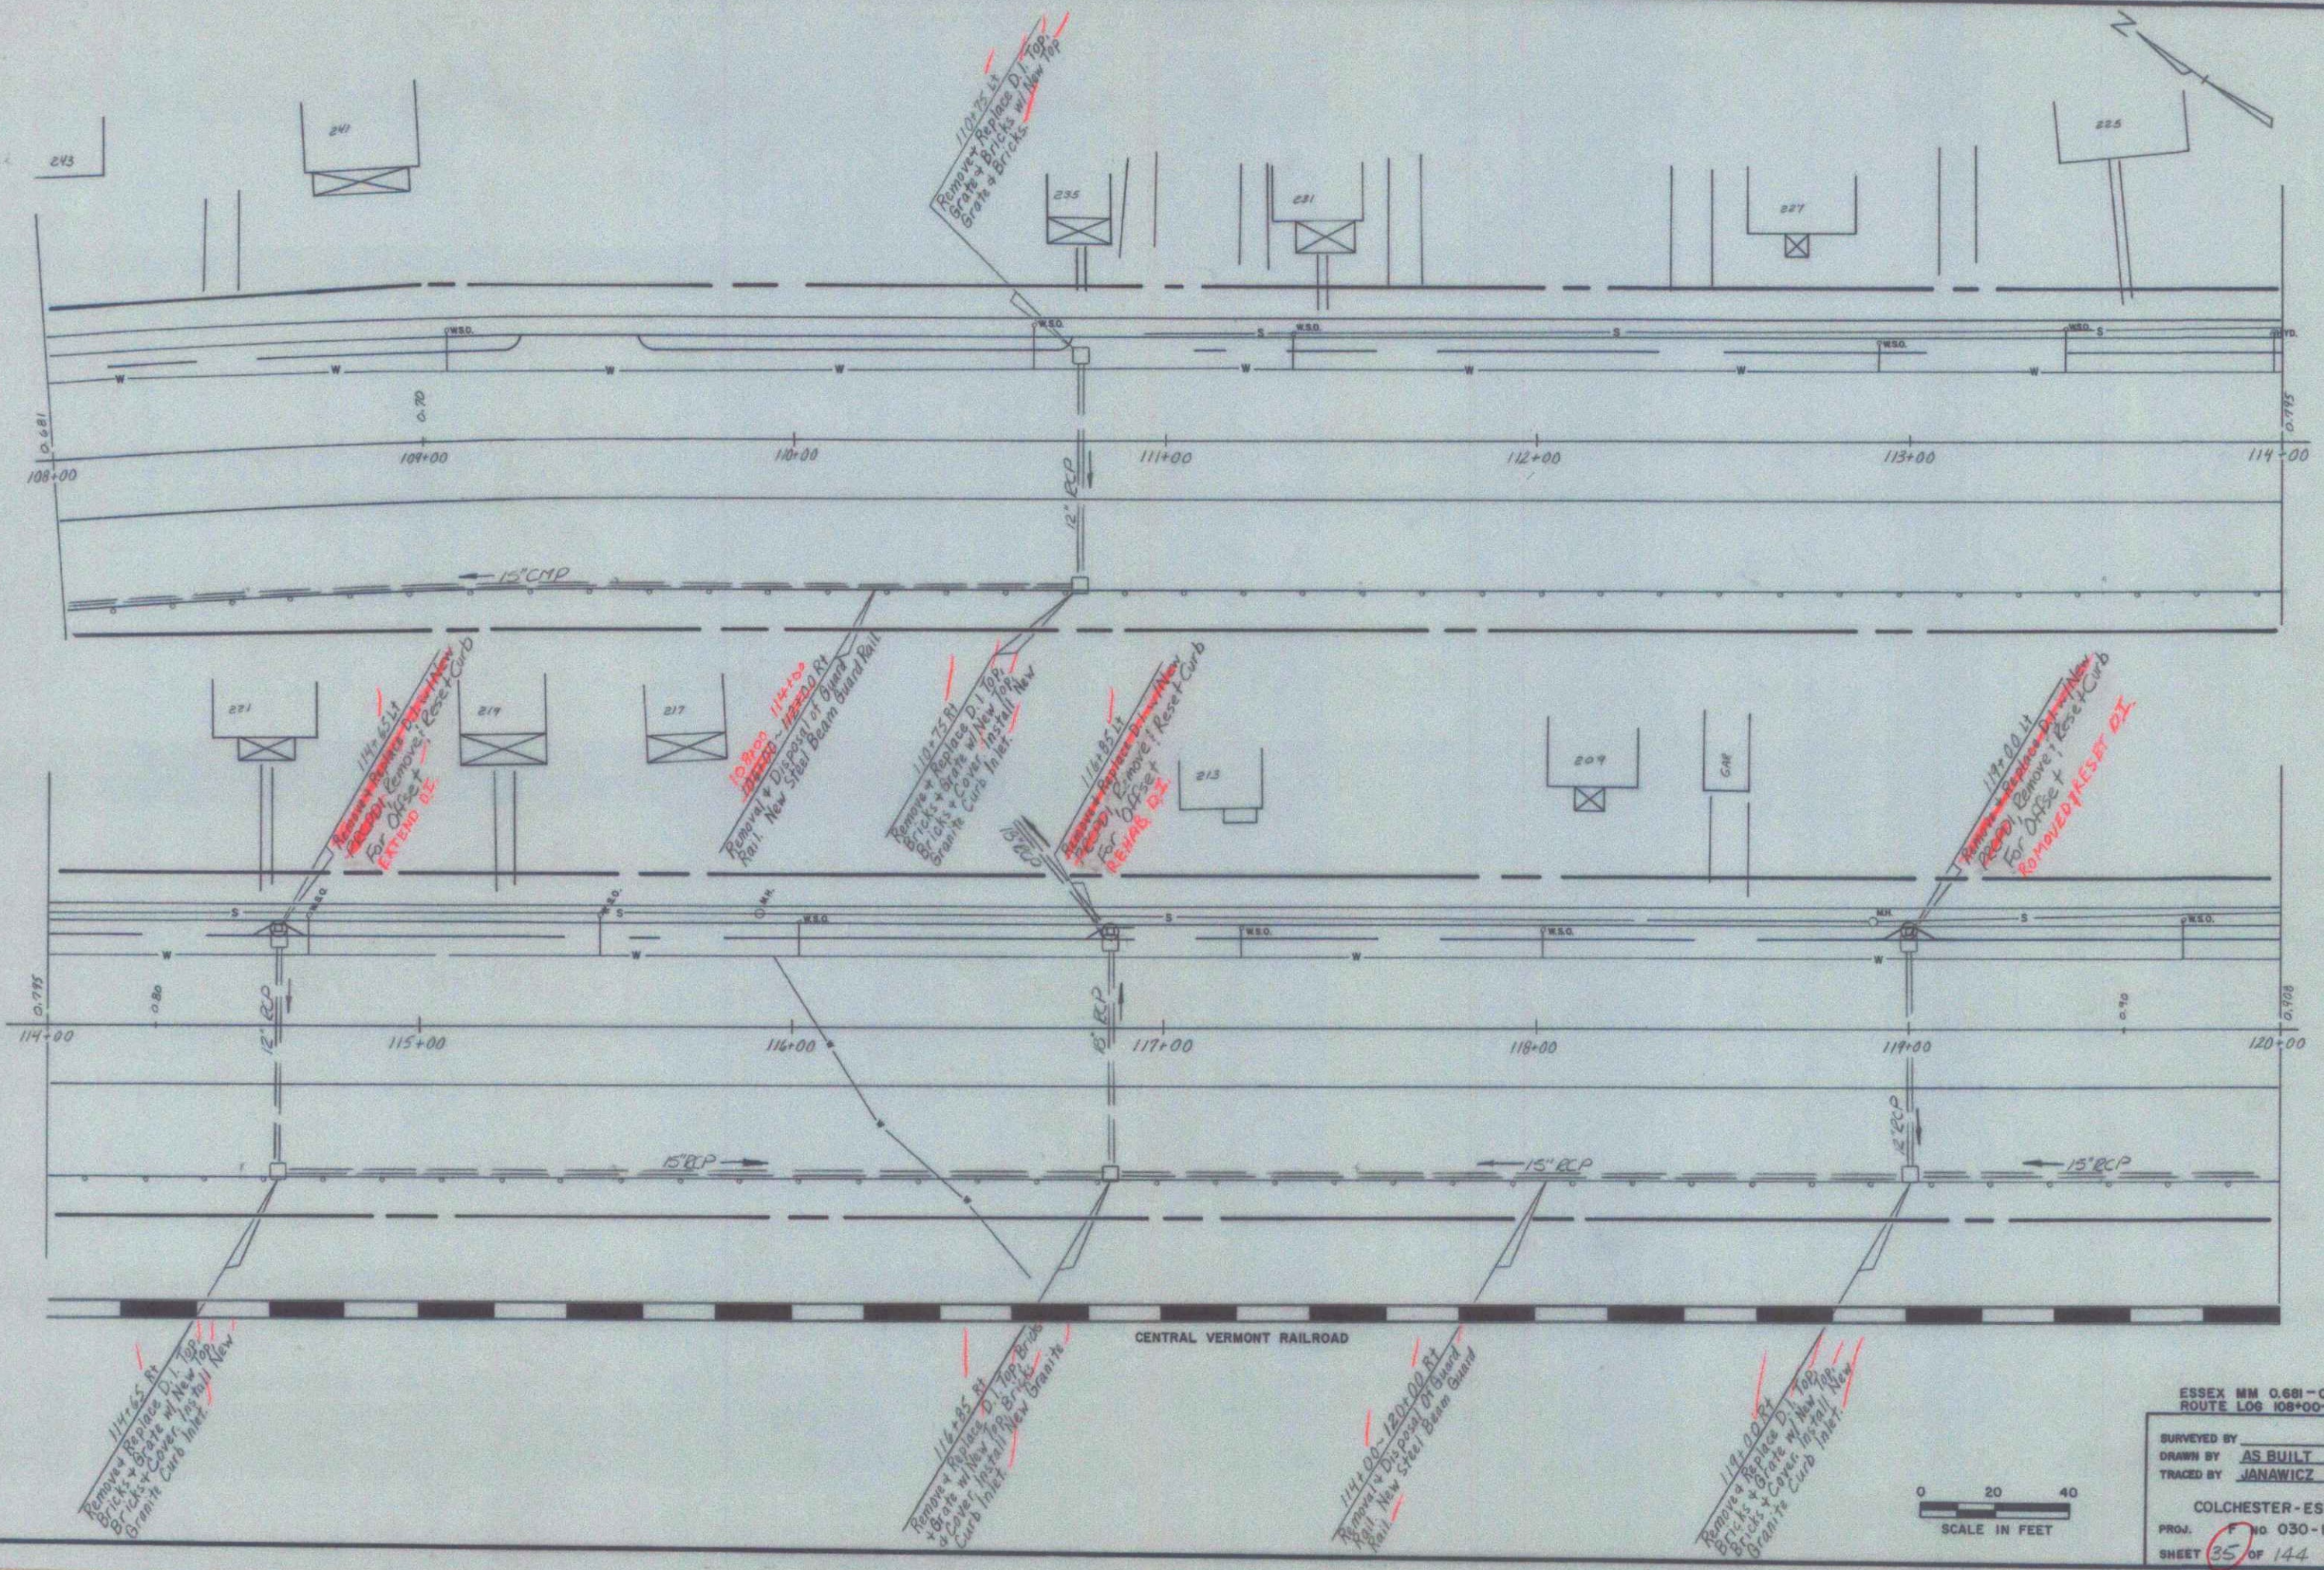

CENTRAL VERMONT RAILROAD

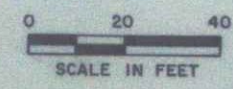

ESSEX MM 0.681-0.908	
ROUTE LOG 108+00-120+00	
SURVEYED BY	DATE
DRAWN BY AS BUILT	DATE 1958
TRACED BY JANAWICZ	DATE 2/88
COLCHESTER-ESSEX	
PROJ. No 030-1(13)	
SHEET 35 OF 144	