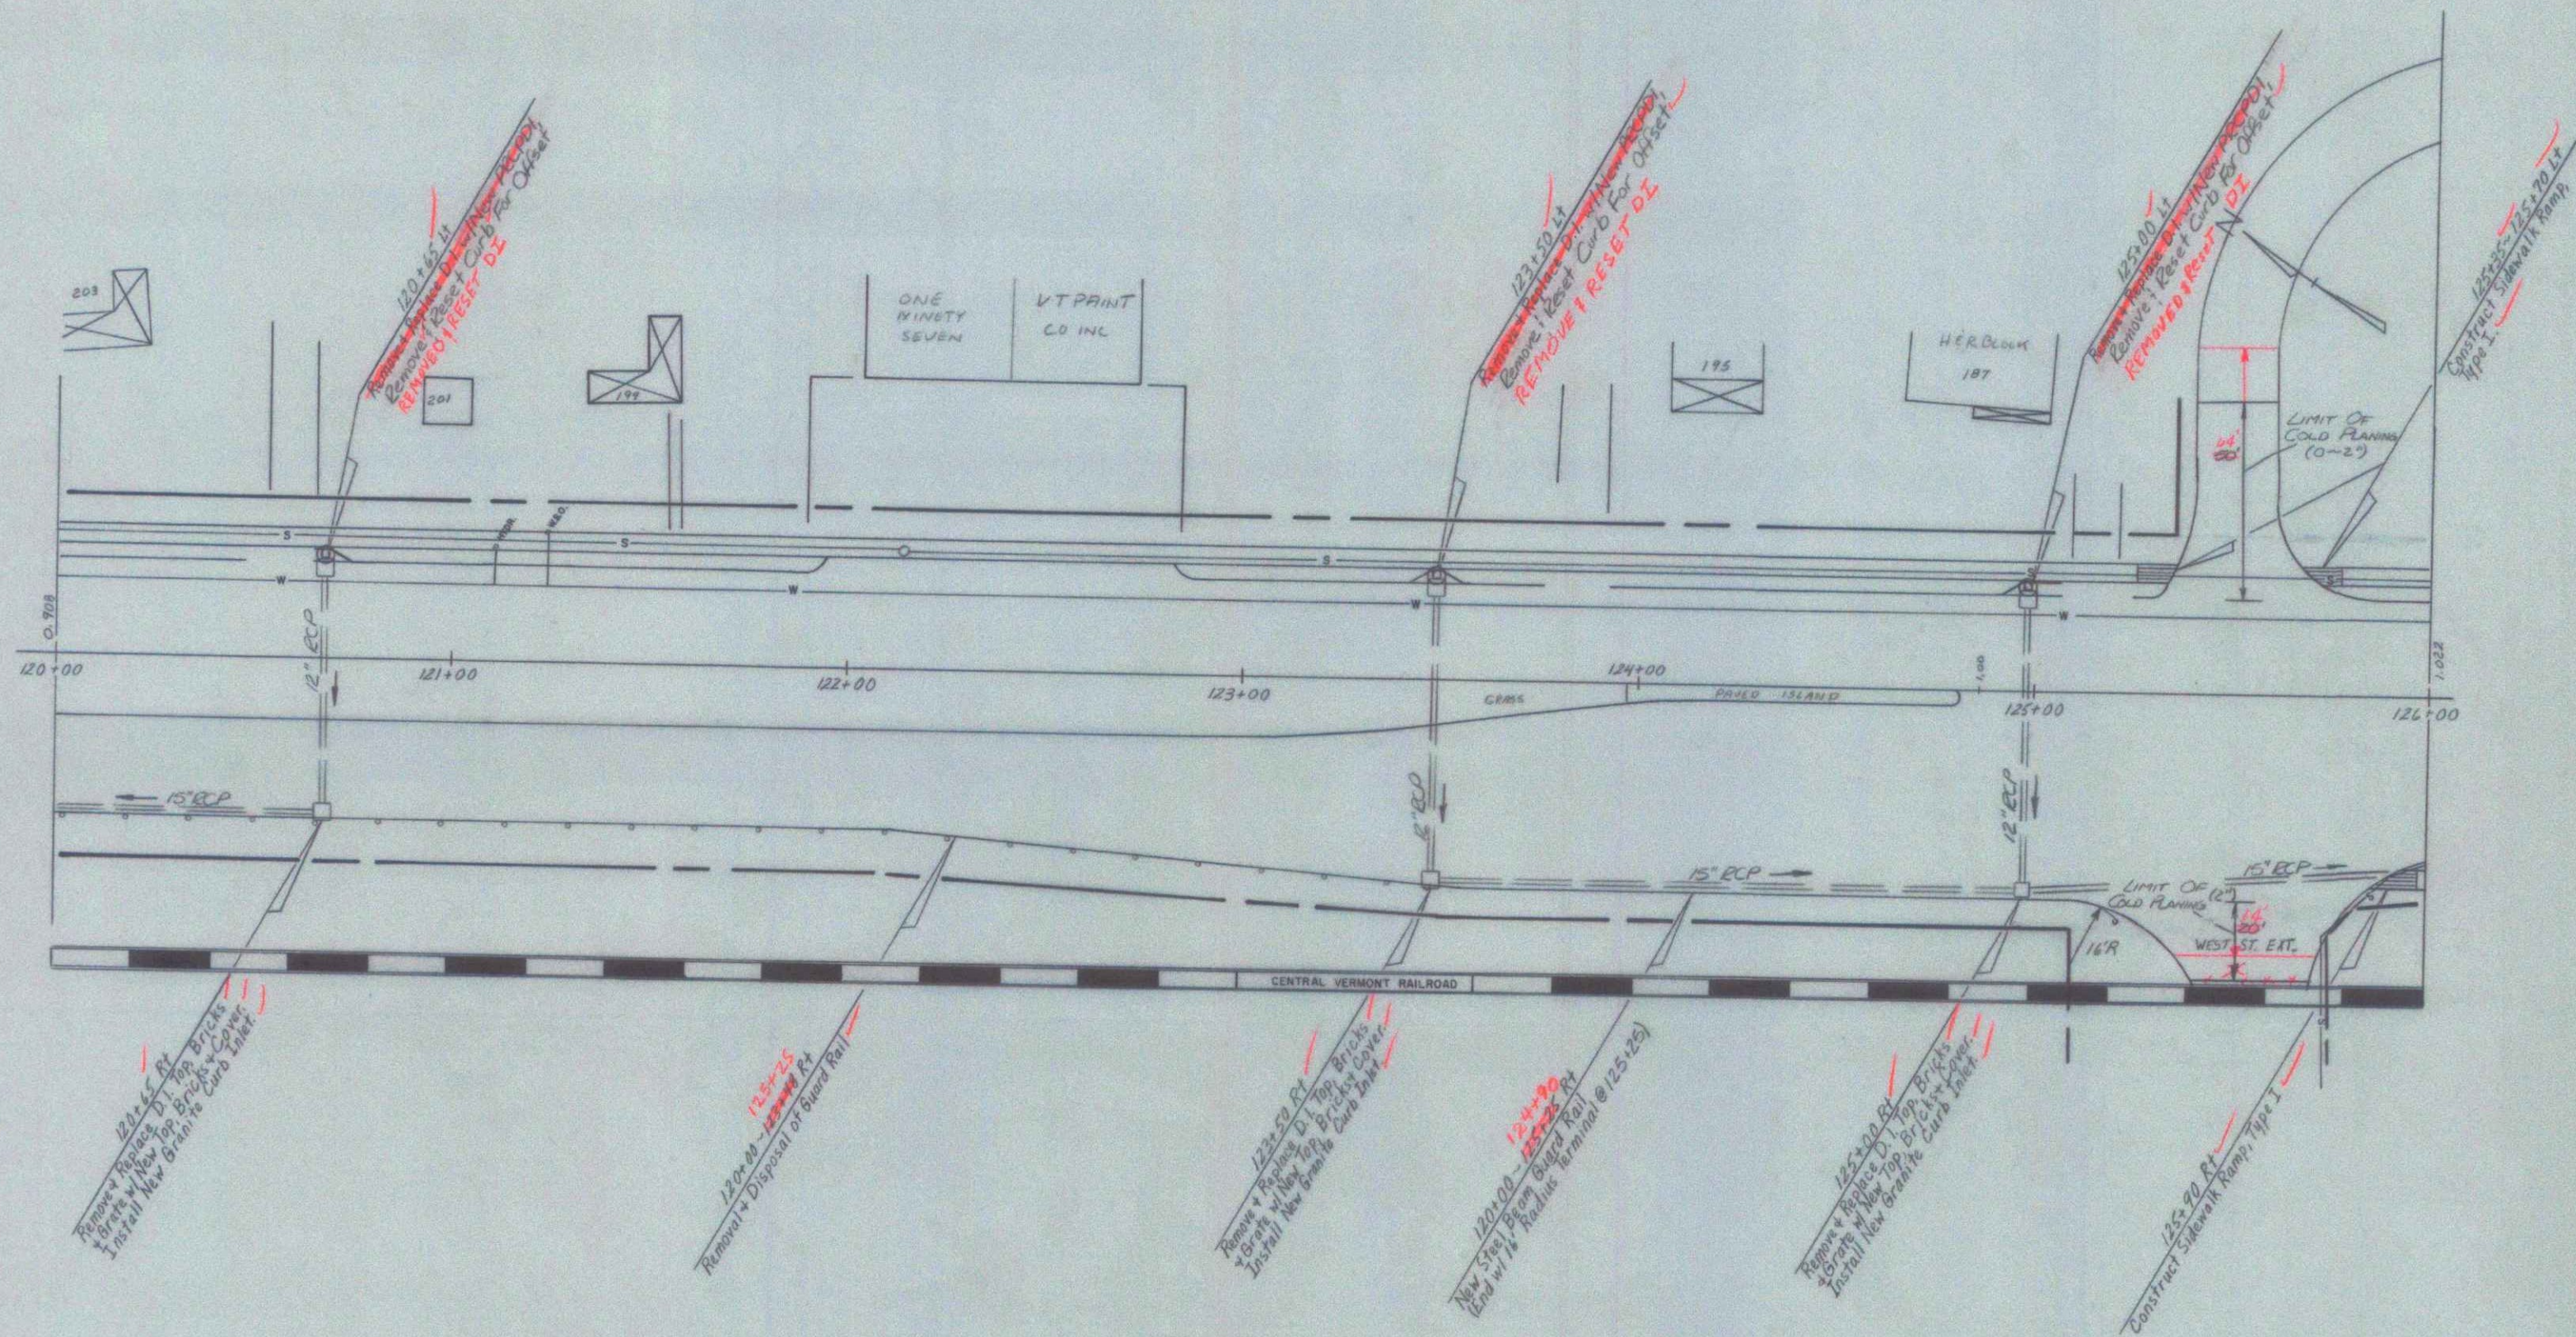


ESSEX MM 0.905-1.022
ROUTE 106 120+00-126+00

SURVEYED BY	DATE
DRAWN BY AS BUILT	DATE 1958
TRACED BY JANAWICZ	DATE 2/88

COLCHESTER-ESSEX
PROJ. No. 030-1 (13)
SHEET 36 OF 144