



EXISTING CURVE DATA (CHORD DEFINITION)

$\Delta = 56^{\circ}-44'-00''$ RT.
 $D = 6^{\circ}-00'-00''$
 $R = 955.4'$
 $T = 515.9'$
 $L = 945.6'$
 $E = 130.4'$
 BANKING = 0.0729%

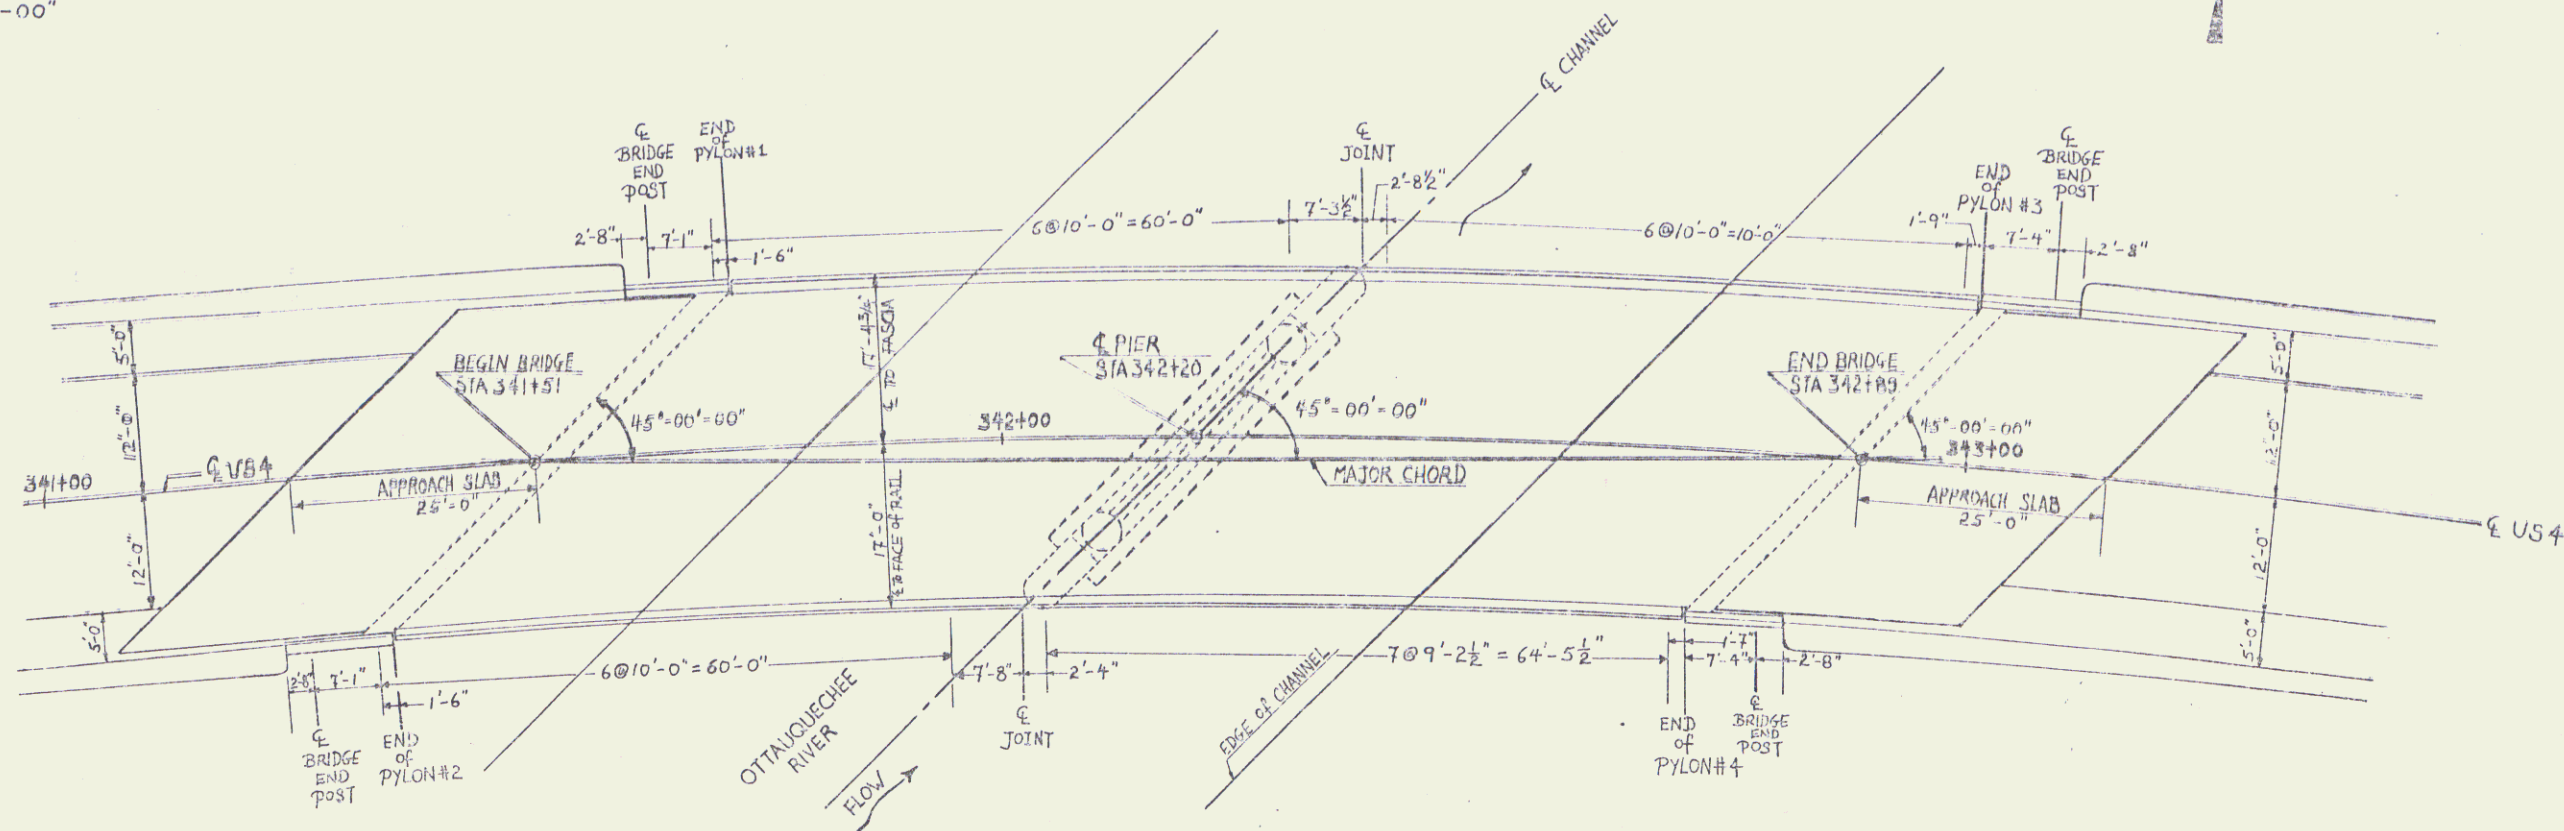

PLAN

1" = 10'-0"

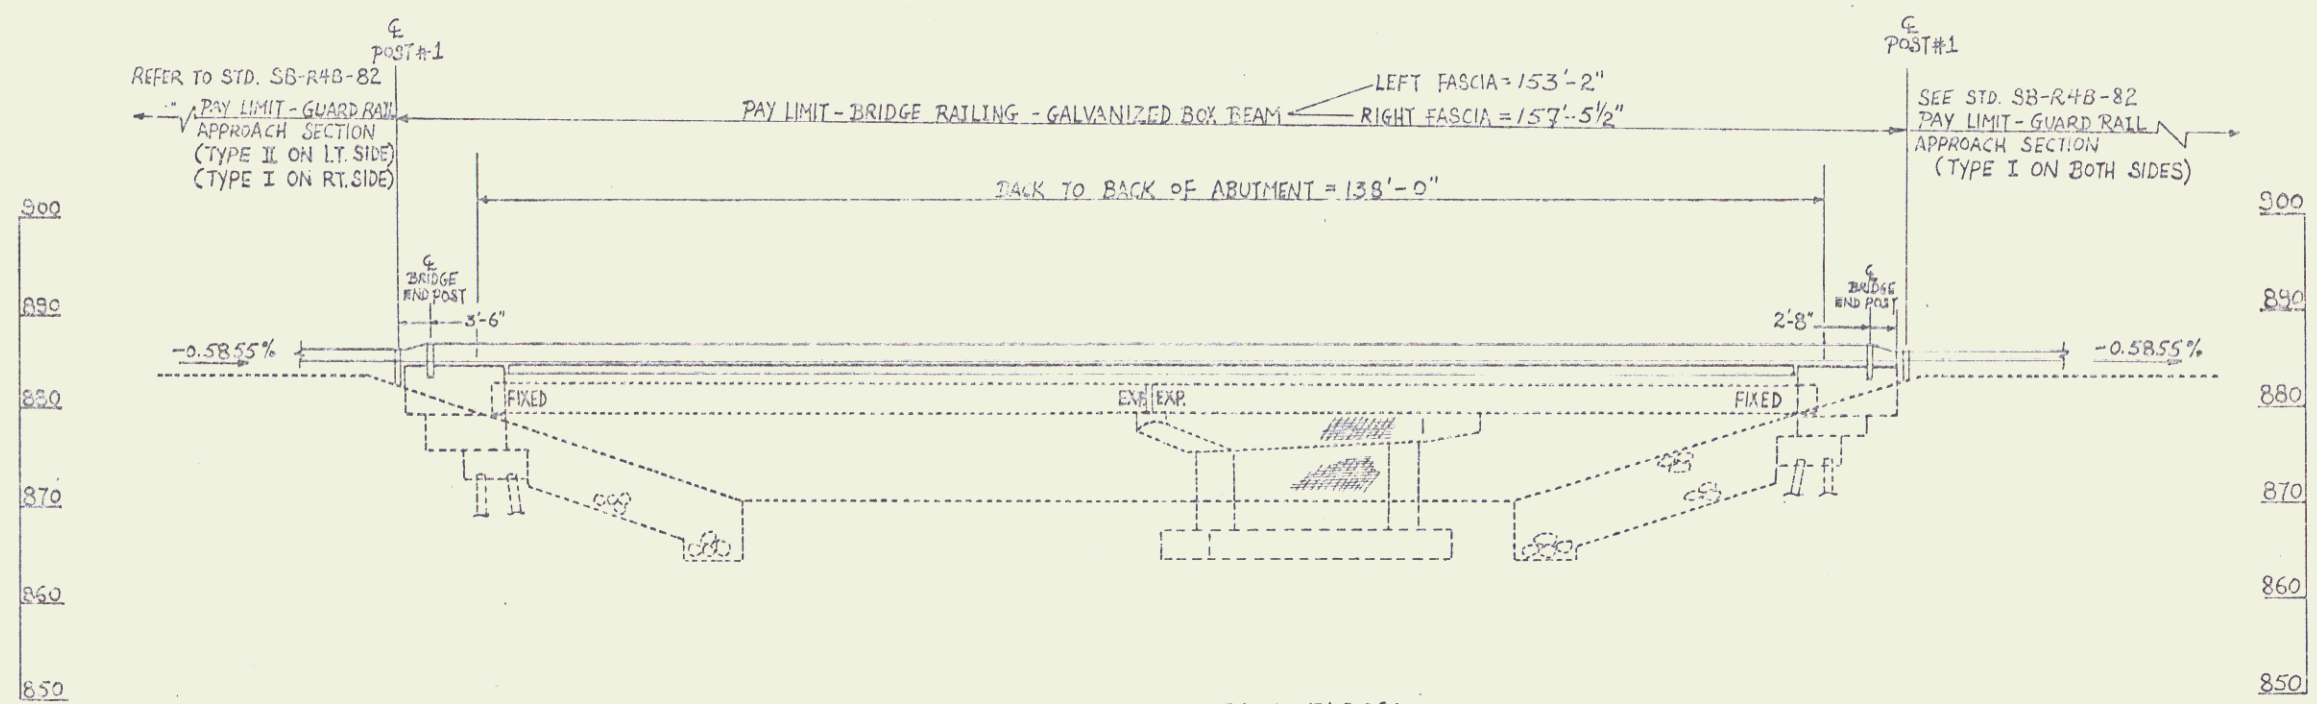

ELEVATION VIEW ALONG UPSTREAM FASCIA

1" = 10'-0"

STATE OF VERMONT	
AGENCY OF TRANSPORTATION	
Town of BRIDGEWATER	Bridge No. 47
Highway No. US 4	Log Sta. ---
PLAN & ELEVATION VIEWS	
Designed By T. SOO	Drawn By T. SOO
BRIDGEWATER	
F 020-2(2)S	
R.O.W. SHEET 2 OF 4	

JAN 06 1993

2