

INDEX OF SHEETS

STATE OF VERMONT
AGENCY OF TRANSPORTATION




PROPOSED IMPROVEMENT

TOWN OF WILLIAMSTOWN

COUNTY OF ORANGE


VT. RTE. 64

LENGTH OF R.O.W. PROJECT 339.00 FEET

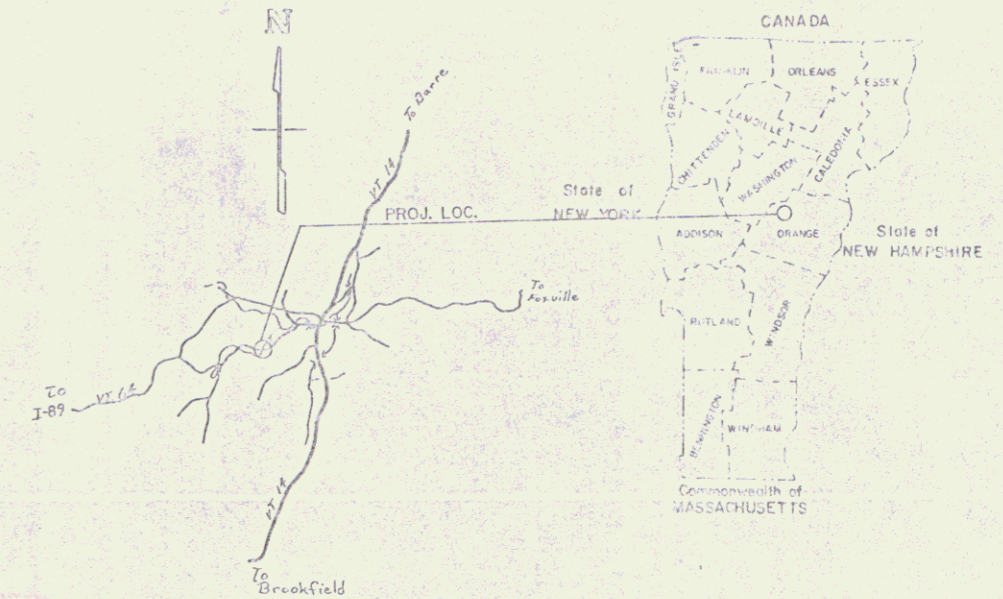

R.O.W. PLANS

BEGIN R.O.W. PROJECT
BP 1761 STA. 190+18 25'LT.
MP 3583

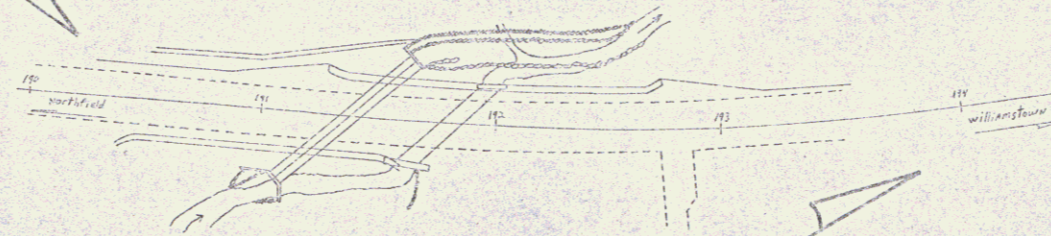

END R.O.W. PROJECT
BP 1761 STA. 193+80 25'LT.
MP 3651

RIGHT-OF-WAY DIVISION
TOWN FILE
PERPETUAL
Town of Williamstown Vt64
(To Be Returned To R.O.W. Division)

CONVENTIONAL SIGNS

- COUNTY LINE
- TOWN LINE
- LIMITS OF ACCESS
- POINT OF ACCESS
- FENCE LINE
- STONE WALL
- TRAVELED WAY
- BOARD WALK
- RAILROAD
- CONVEY LINE
- CONVEY LINE
- POWER POLE
- TELEPHONE POLE
- TREES
- CONTROL OF ACCESS
- PROPERTY LINE
- R.O.W. TAKING LINE
- SLOPE RIGHTS
- TOP OF CUT
- TOP OF SLOPE

DATE	VERTICAL
DATE	HORIZONTAL

SCALE 1" = 40'



OCT 06 1989

Pin 87E061

THESE PLANS ARE SUBJECT TO SUCH ENGINEERING CHANGES AS MAY BE REQUIRED BY THE FEDERAL HIGHWAY ADMINISTRATION OR THE CHIEF ENGINEER. CONSTRUCTION IS TO BE CARRIED ON IN ACCORDANCE WITH THESE PLANS AND THE STANDARD SPECIFICATIONS FOR CONSTRUCTION DATED 1986. FOR USE ON THIS PROJECTS, INCLUDING ALL SUBSEQUENT PROVISIONS AS ARE INCORPORATED IN THESE PLANS.

APPROVED	<i>[Signature]</i> DATE <i>4/14/89</i>
Dir., Dept. of Planning & Finance	
APPROVED	<i>[Signature]</i> DATE <i>4/14/89</i>
Chief, Property Administration	
WILLIAMSTOWN	
VT. RTE. 64 BP 1761	
SHEET 1 OF 3	

STATE OF VERMONT
AGENCY OF TRANSPORTATION
RIGHT OF WAY PLANS
DETAIL SHEET

PARCEL NO.	GRANTOR	SHEET NO.	BEGINNING STATION	ENDING STATION	TAKING	REM.	RIGHTS	TITLE TAKEN	DATE	TOWN OR CITY RECORDED	BK.	PG.	REMARKS	REVISION NO.	SHEET NO.	DESCRIPTION OF REVISION	DATE	MADE BY	APPROVED BY	
1	REGECZI, ROBERT A. & WENDY A.	3	90+48 RT. 90+30 RT.	91+05 RT. 90+95 RT.	0.01 A±		CONST.EASE.(T) (0.01 A±)	WDOE	10/19/87	WILLIAMSTOWN	66	270-71	(513 S.F.±) (540 S.F.±)	1	2,3	PARCEL NO. 4 PEABODY: ADD NEW PARCEL & RT.S. NEW P.O. FOUND. FLICKINGER NOW STARTS AT STA. 191+64 LT. AND THE TAKING WAS REDUCED TO 0.08 FROM 0.12A± ALSO BEANS ENDING STA. WAS CORRECT ACCORDINGLY PER CO 6922	5/14/87	A.S.J.	<i>[Signature]</i>	
2	FLICKINGER, WILLIAM C. & GERTRUDE M.	3	191+64 LT. 191+75 LT. 192+70 LT.	193+50 LT. 193+80 LT.	0.08 A±		CONST.EASE.(T) (0.04 A±) DRAINAGE (P)	WDOE	8/6/87	WILLIAMSTOWN	65	520-2	(3480 SF±) (1695 SF±)	2	2,3	PARCEL NO. 1 REGECZI TITLE CHANGE FROM RELANGER, TO REGECZI, ROBERT A. & WENDY A. PER CO NO. 7016	6/5/87	A.S.J.	<i>[Signature]</i>	
3	MEAN, ETHEL G. SHEPARD, ALBERTA A. HEAVITT, LYDIA L.	3	190+95 RT. 190+88 RT.	192+03 RT. 192+14 RT.	0.04 A±		CONST.EASE.(T) (0.02 A±)	WDOE	6/14/87	WILLIAMSTOWN	66	19-22	(1700 S.F.±) (805 S.F.±)							
4	PEABODY, WILLIAM D. & SHERI LYNN	3	190+41 LT. 190+18 LT.	191+75 LT. 191+79 LT.	0.04A±		CONST. EASE. (T) (0.02 A±)	WDOE	9/15/87	WILLIAMSTOWN	66	162-63	(1585 S.F.±) (1035 S.F.±)							

OCT 06 1987

MADE BY: H.J.B. DATE: 4-15-87
 CHECKED BY: E.J.M. DATE: 3-15-87

DR. RT. - DRAINAGE RIGHT
 DIT. RT. - DITCHING RIGHT
 CH. RT. - CHANNEL RT.
 DRIVE RT. - DRIVE RIGHT
 CUL. RT. - CULVERT RIGHT
 (R) - RESURFACING OR REMOVAL
 (S) - SIDEWALKS

PRESENT R.O.W.
 TAKING WITHOUT ACCESS
 TAKING WITH ACCESS
 (P) - PERMANENT EASEMENT
 (T) - TEMPORARY EASEMENT

LEGEND
 --- CONST. EASE. ---
 SR --- CB --- SLOPE RIGHTS
 P --- L --- PROPERTY LINE
 ---▲--- TOP OF CUT
 ---○--- TOE OF SLOPE

R.O.W. PLANS

APPROVED: [Signature] DATE: 4-15-87
 AGENT OF PLANS & TITLES

WILLIAMSTOWN
 BP 1761
 SHEET **2** OF 3

