


PLAN
SCALE 1" = 10'-0"

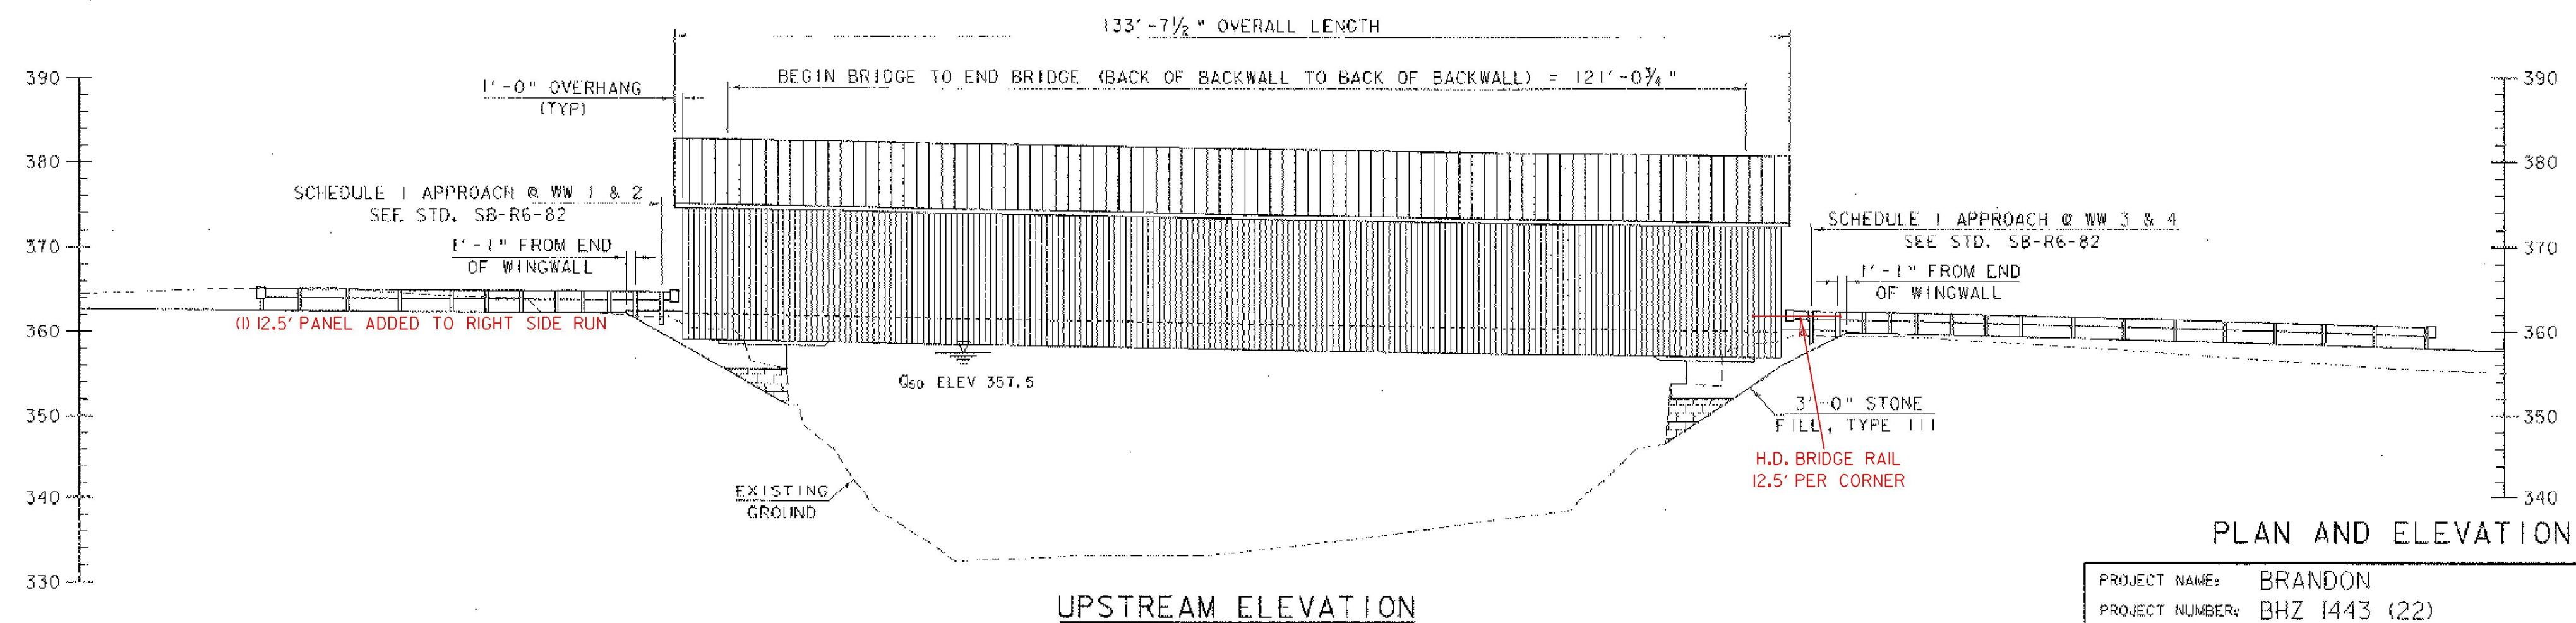

UPSTREAM ELEVATION
SCALE 1" = 10'-0"

PLAN AND ELEVATION

PROJECT NAME:	BRANDON	PLOT DATE:	16-MAY-2002
PROJECT NUMBER:	BHZ 1443 (22)	DRAWN BY:	G. ROY
FILE NAME:	87137\structures\87137pe.d	CHECKED BY:	T. SUMNER
PROJECT MANAGER:	R. R. WHITCOMB	SHEET	17 OF 51
DESIGNED BY:	T. SUMNER		