

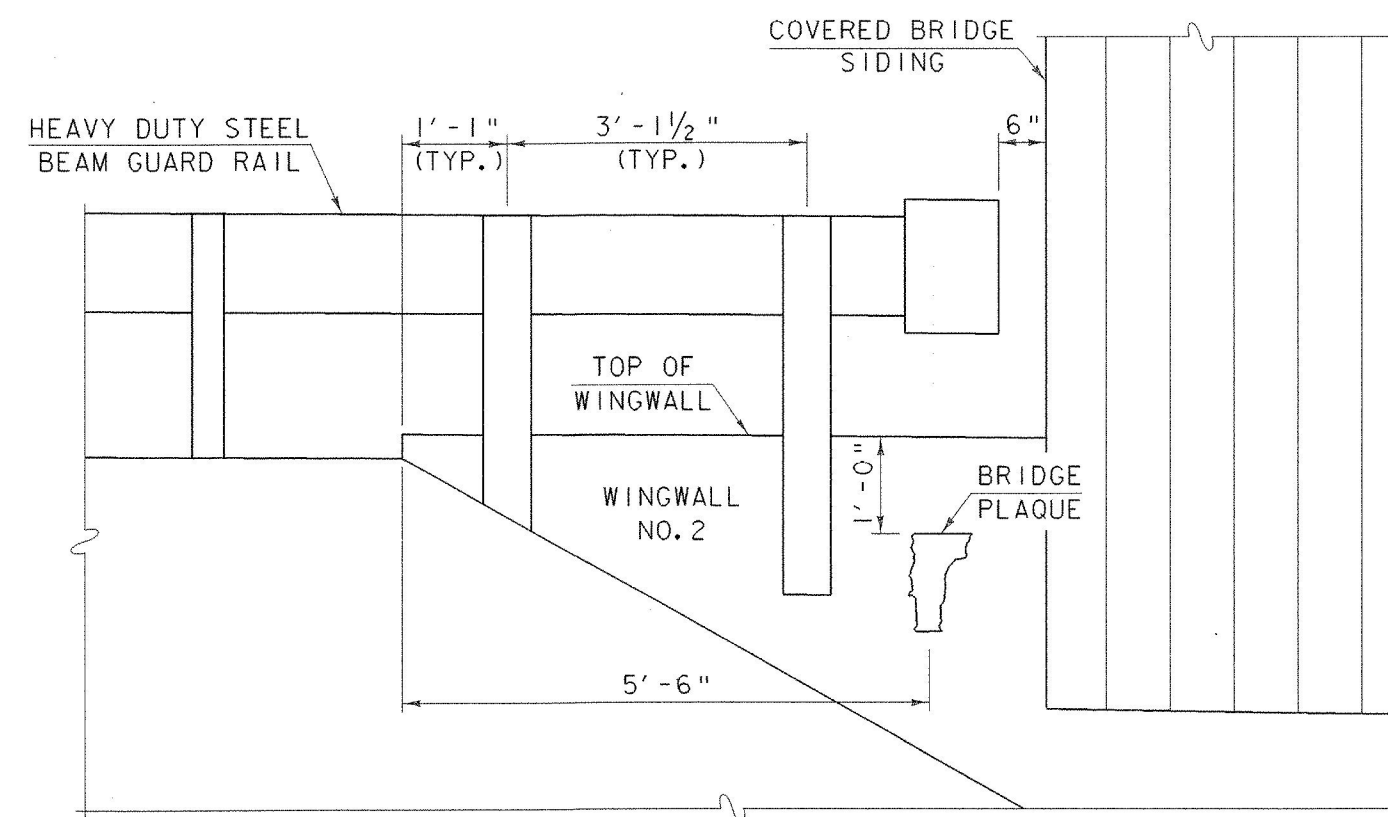


WINGWALL RAIL DETAIL
SCALE: 1/2" = 1'-0"

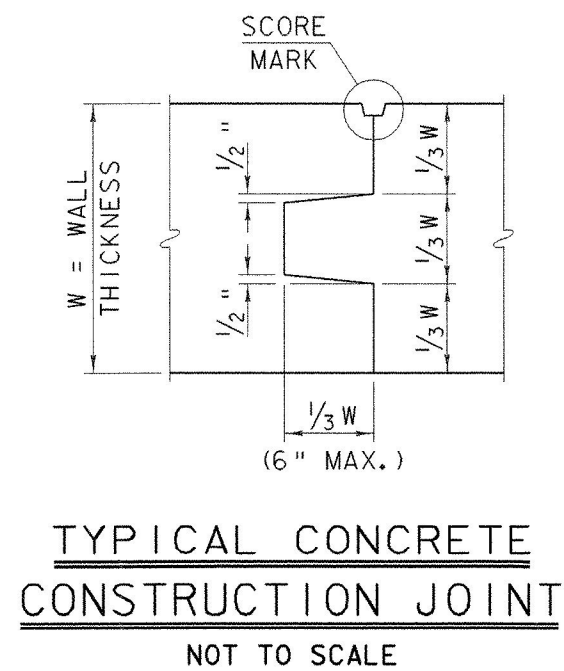

BRIDGE PLAQUE DETAIL
NOT TO SCALE

THE BENCH MARK AND BRIDGE PLAQUE WILL BE SUPPLIED BY THE AGENCY OF TRANSPORTATION AND SHALL BE INSTALLED BY THE CONTRACTOR AS SHOWN OR AS DIRECTED BY THE ENGINEER.

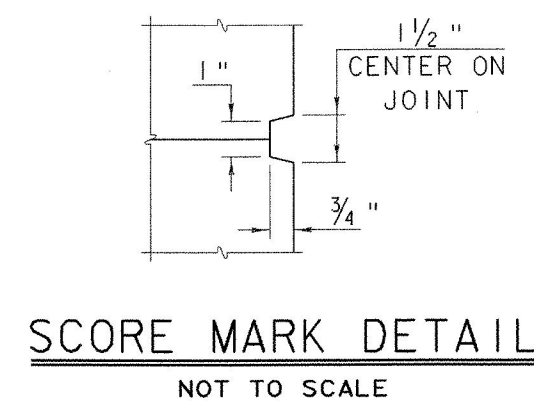

MISCELLANEOUS PROJECT DETAILS

PROJECT NAME:	BRANDON	FILE NAME:	87J137\Structures\s137mpd.i	PLOT DATE:	16-MAY-2002
PROJECT NUMBER:	BHZ 1443 (22)	PROJECT MANAGER:	R. R. WHITCOMB	DRAWN BY:	G. ROY
		DESIGNED BY:	T. SUMNER	CHECKED BY:	T. SUMNER
				SHEET	34 OF 51