


REV. CURVE #2
 $\Delta = 80^\circ 56' 15''$ RT.
 $D = 12^\circ 30'$
 $R = 458.37'$
 $T = 126.85'$
 $L = 247.50'$
 $E = 17.22'$

PLAN
 Scale: 1"=20'

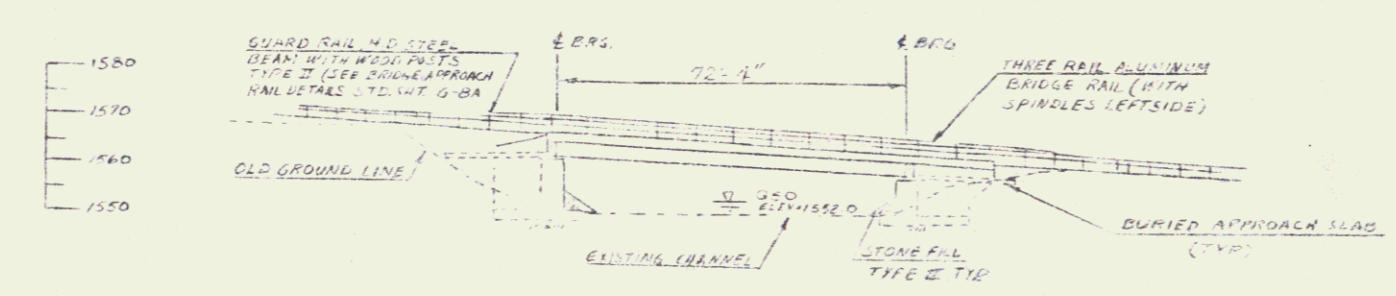

ELEVATION
 Scale: 1"=20'

SEP 23 1986

STATE OF VERMONT	
AGENCY OF TRANSPORTATION	
TOWN OF <u>DANVILLE</u>	Bridge No. <u>52</u>
HIGHWAY NO. <u>US. ROUTE 2</u>	Log Sta. <u>57+00</u>
<u>US. 2 OVER JOE'S BROOK</u>	
<u>PLAN AND ELEVATION</u>	
Designed by <u>J. RICHET</u>	Drawn by <u>J. E. JONES</u>
Checked by <u>DELATHROP</u>	Bridge Design Supervisor
DATE <u>5/83</u>	DATE <u>5/83</u>
PROJECT <u>DANVILLE</u>	PROJECT NO. <u>DRF 028-3(19) S</u>
Sheet <u>3</u> of <u>12</u>	