

STONE WALL TYPE #1
REV 81+60 - 83+60, LT


EDGEMOUNT MATTING
REV 82+29 - 84+00, RT

REMOVAL AND DISPOSAL OF
EXISTING GUARD RAIL
REV 82+10 - 83+52, LT

GUARD RAIL - STANDARD STEEL BEAM
W/ WOOD POSTS TYPE #2
REV 82+00 - 83+50, LT

CONSTRUCT DRIVE
REV 84+55, RT

BEGIN ROW PROJECT
BRF 028-3(19)S STA. 80+70.10

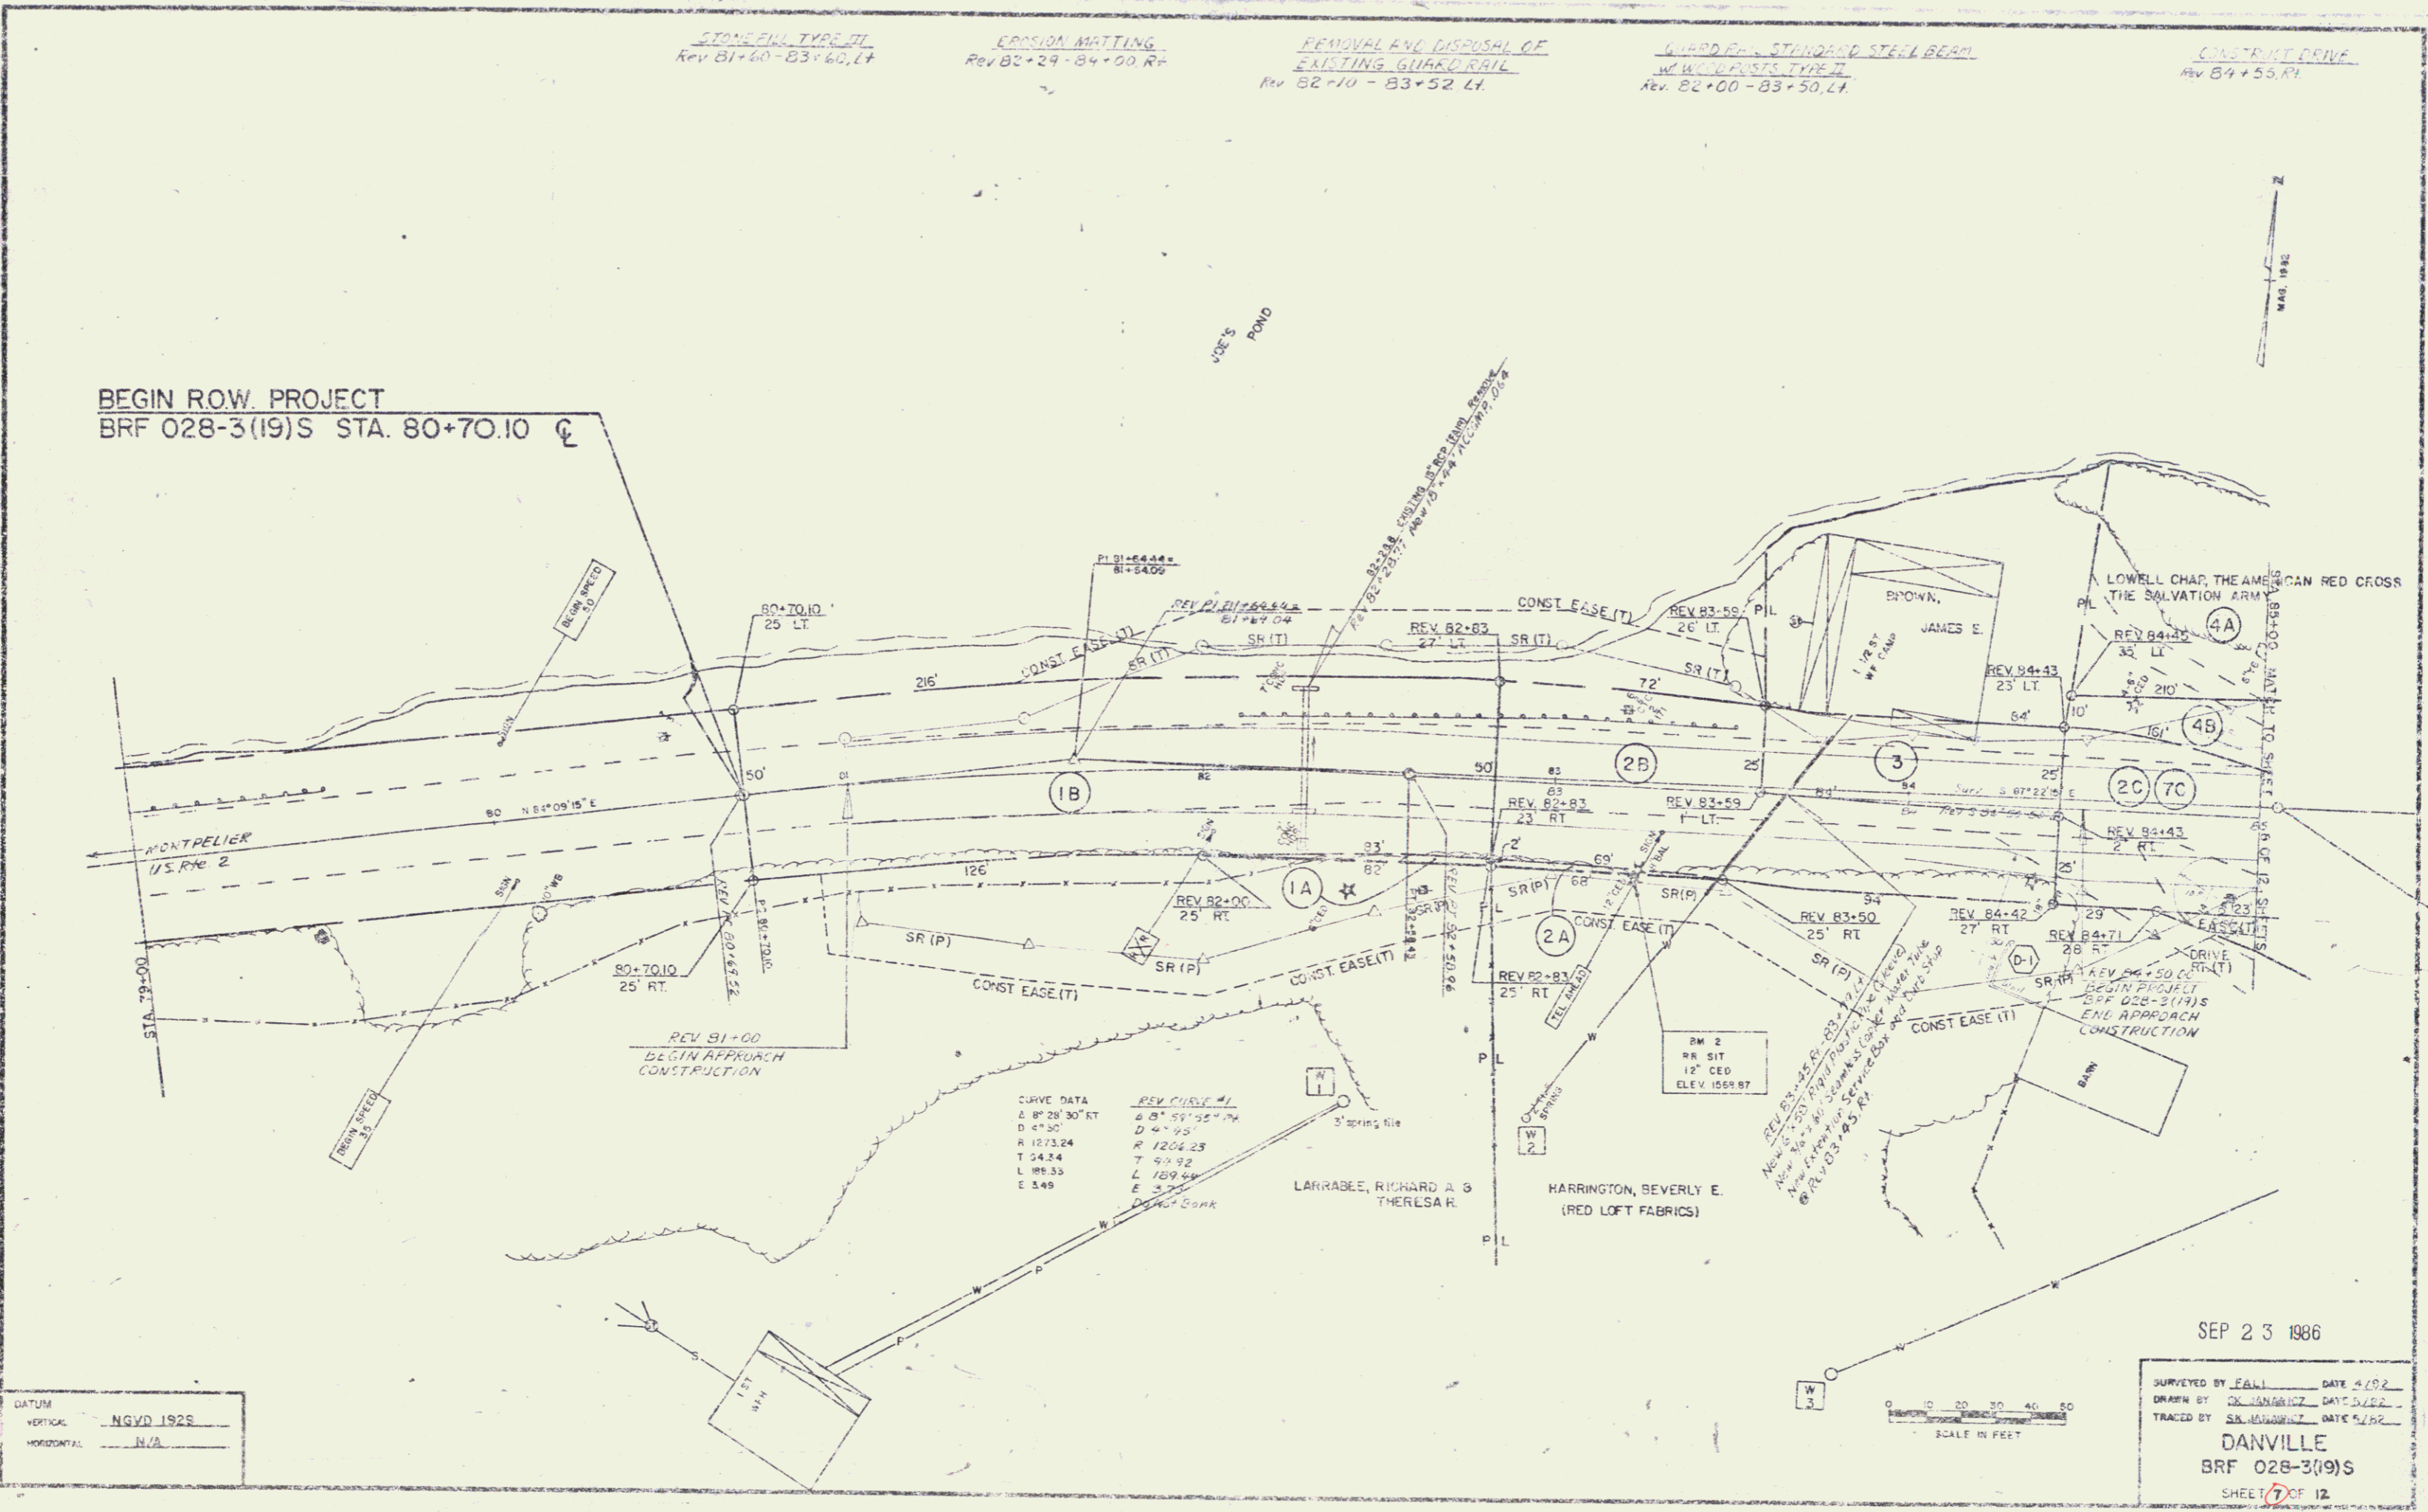

SEP 23 1986

DATUM
VERTICAL: NGVD 1928
HORIZONTAL: N/A

SCALE IN FEET
0 10 20 30 40 50

SURVEYED BY FALL DATE 4/82
DRAWN BY SK. MORGANZ DATE 5/82
TRACED BY SK. MORGANZ DATE 5/82
DANVILLE
BRF 028-3(19)S
SHEET 7 OF 12