
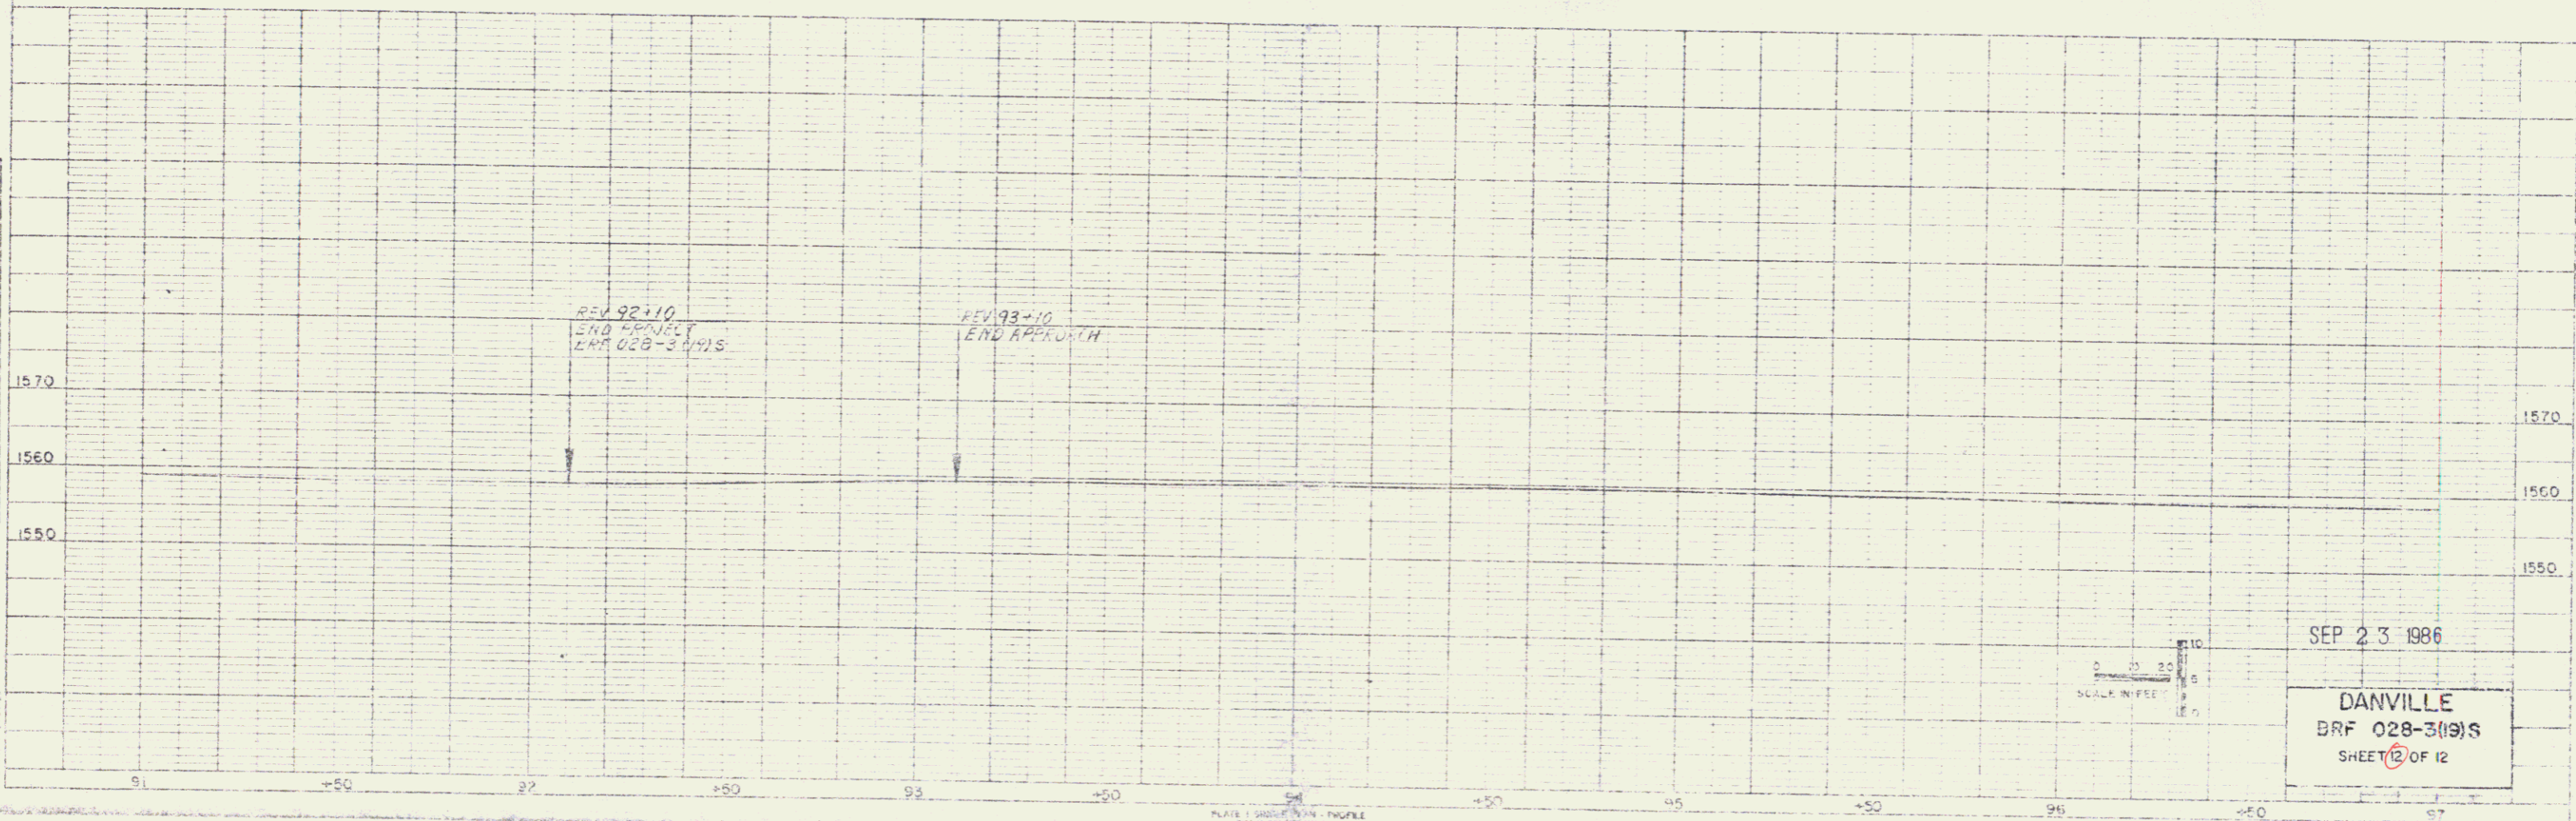


PLAN
 SURVEYED BY
 CHECKED BY
 DATE

PROFILE
 SURVEYED BY
 CHECKED BY
 DATE

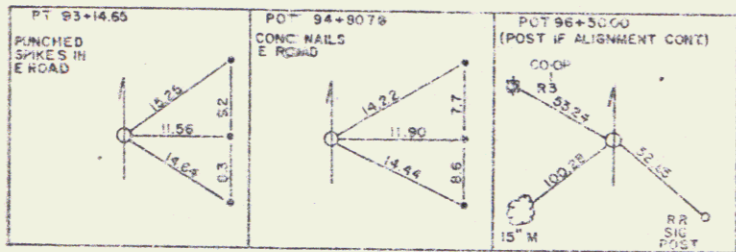

SEP 23 1986
 DANVILLE
 BR 028-3(1)S
 SHEET 2 OF 12