



TYPICAL SECTIONS

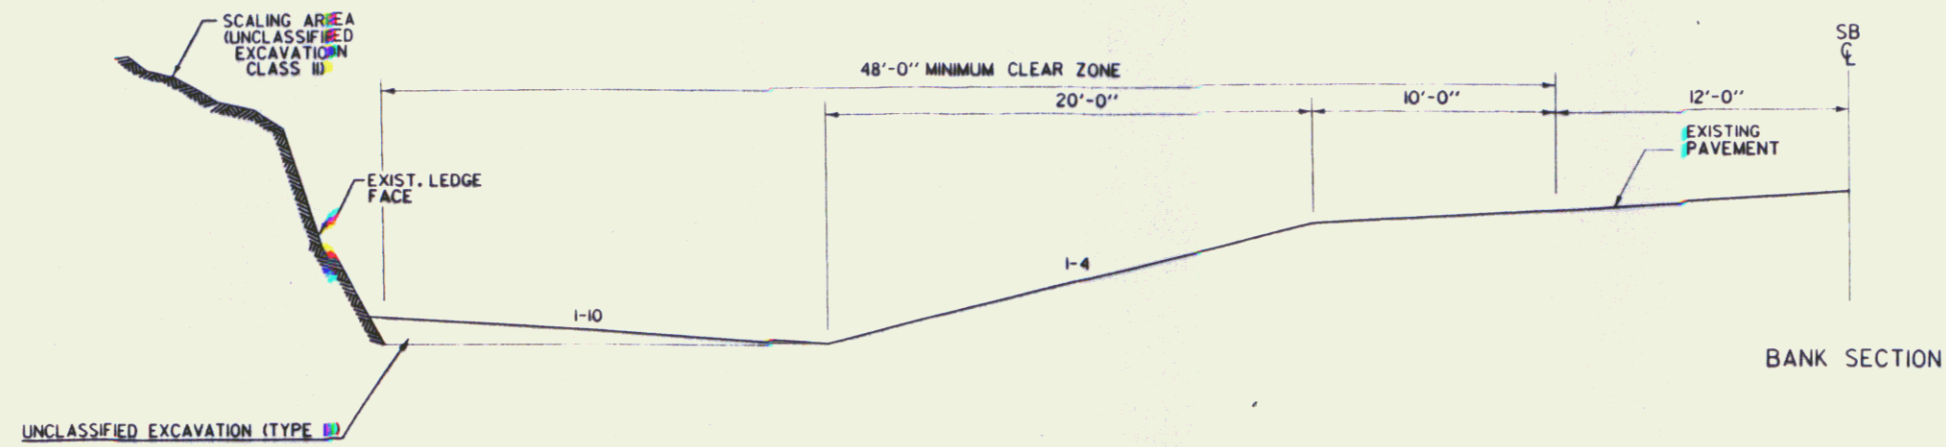

- NOTE:
1. THE REMOVAL OF ALL UNCLASSIFIED EXCAVATION (TYPE II) SHALL BE DONE PRIOR TO ANY SCALING OPERATION IN THIS AREA.
 2. ANY MATERIAL REMOVED FROM SCALING OPERATION SB - LT. BETWEEN MM 92.480 ~ MM 92.613 WILL BE STOCKPILED AND MEASURED AS UNCLASSIFIED EXCAVATION (TYPE II).

MM 92.480 ~ MM 92.613 SECTION II

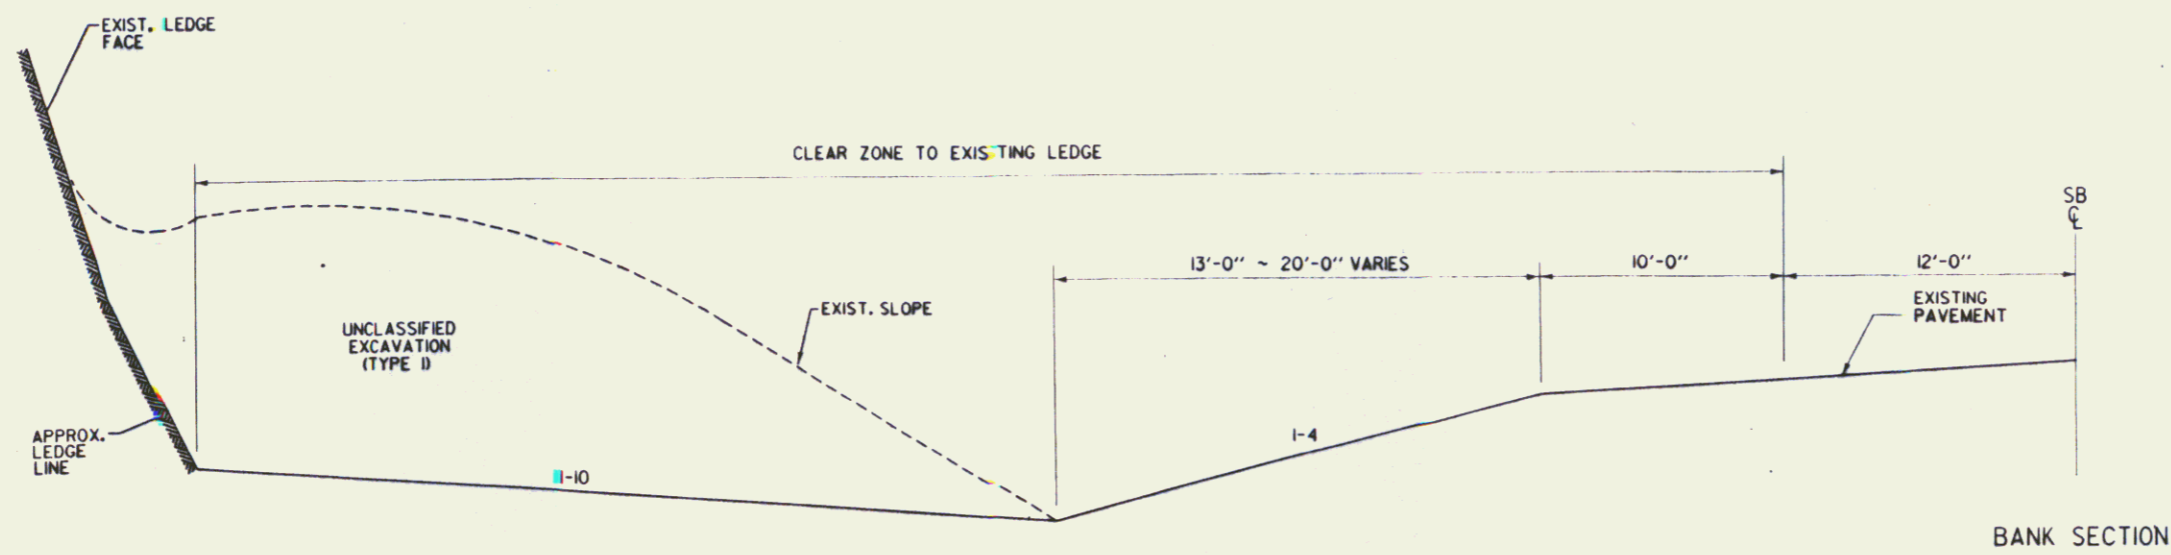

MM 92.613 ~ MM 92.708 SECTION II

NOT TO SCALE

SURVEYED BY	BULLOCK	DATE	5/91
DRAWN BY	PERKINS	DATE	5/91
SQUAD LEADER	PERKINS		
DESIGN FILE NO.	/usr2/squadd/89a006.dgn		
PRF FILE	89A006TY3.PRF	DATE PLOTTED	02-JUL-1992
THETFORD-FAIRLEE			
IR 091-2(7)			
R.O.W. SHEET 2 OF 12 SHEETS			

FEB 07 1997