



ROCK BOLT DETAILS

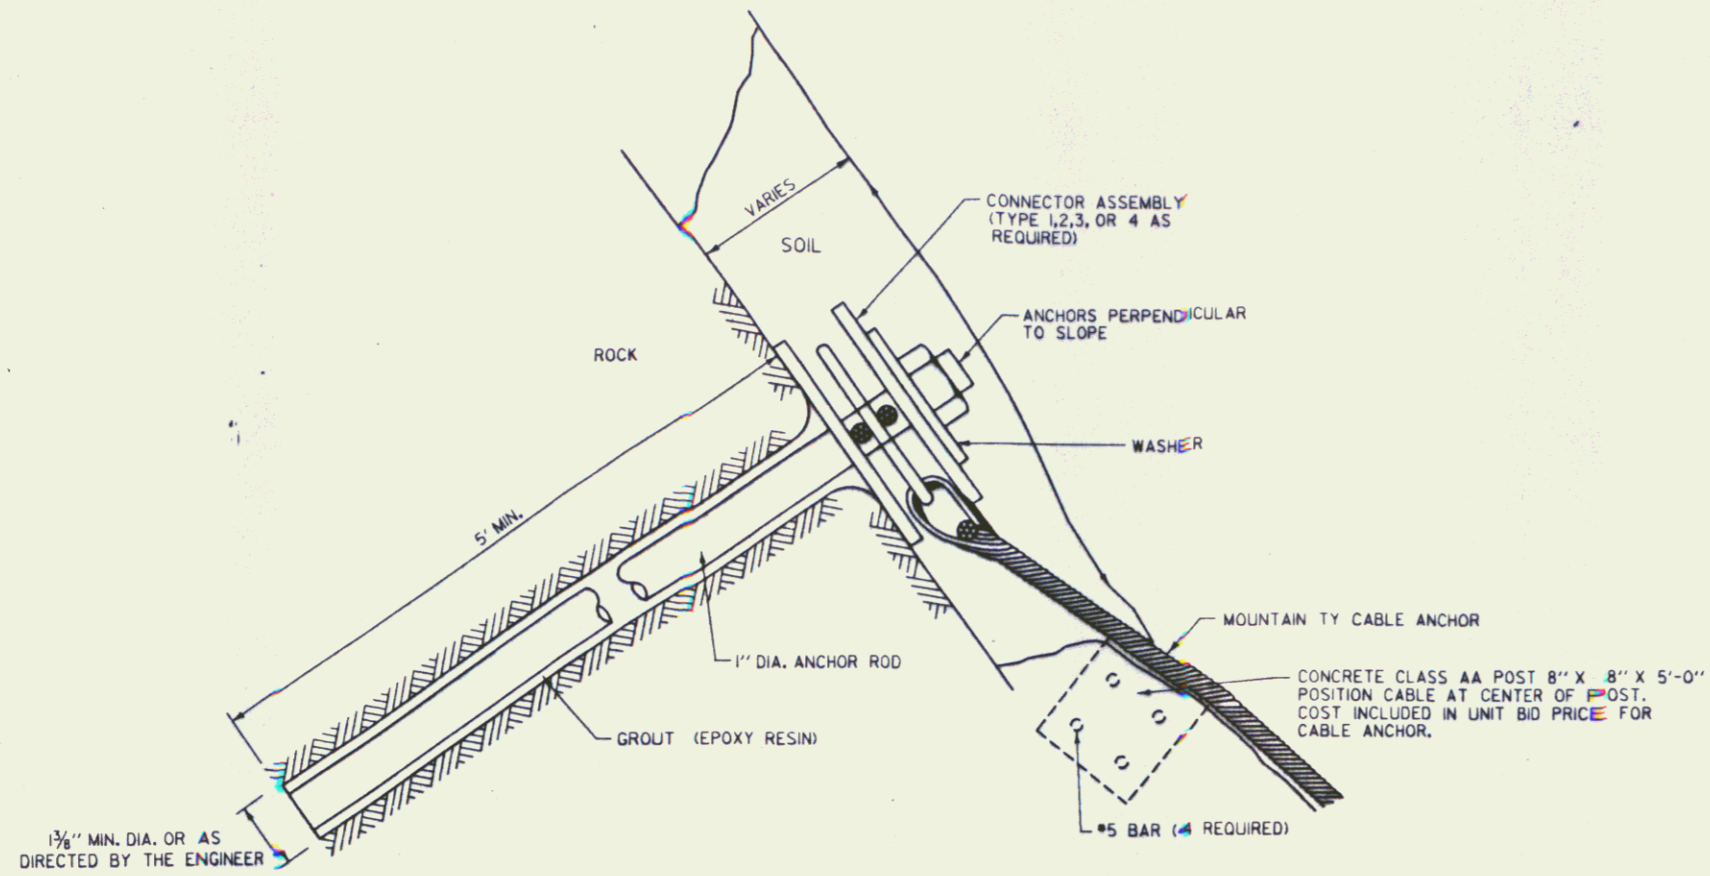


**TYPE 'B' ANCHOR
(FOR USE IN SOIL OVERBURDEN)**

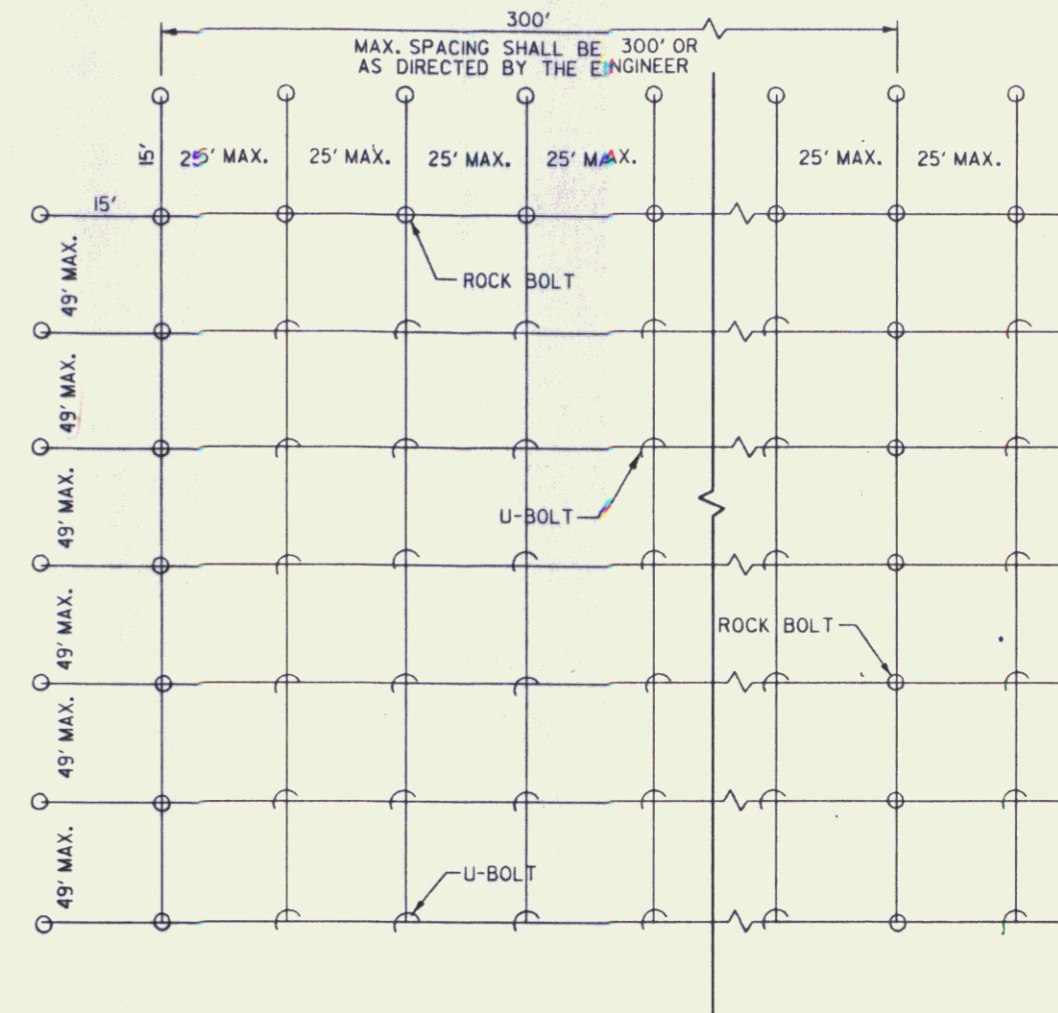


SPACING OF ROCK BOLTS


3/4" X 6" X 6" PLATE
GRADE ASTM A-36
(TYPICAL)

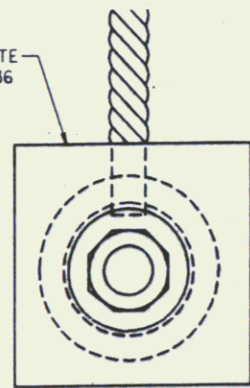


TYPE 1 CONNECTOR ASSEMBLY

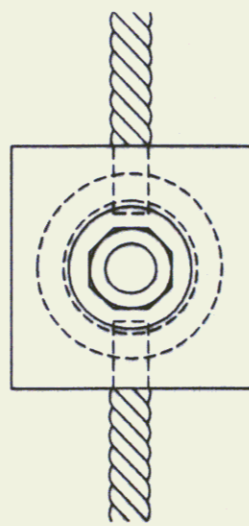

TYPE 2 CONNECTOR ASSEMBLY

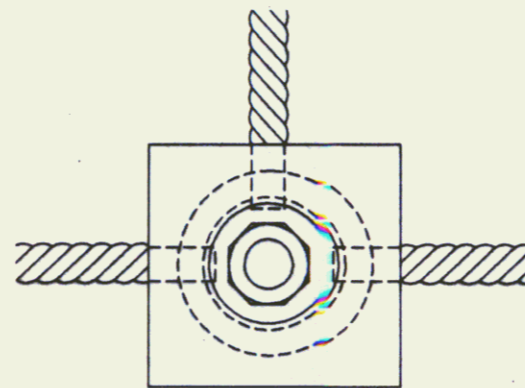

TYPE 3 CONNECTOR ASSEMBLY

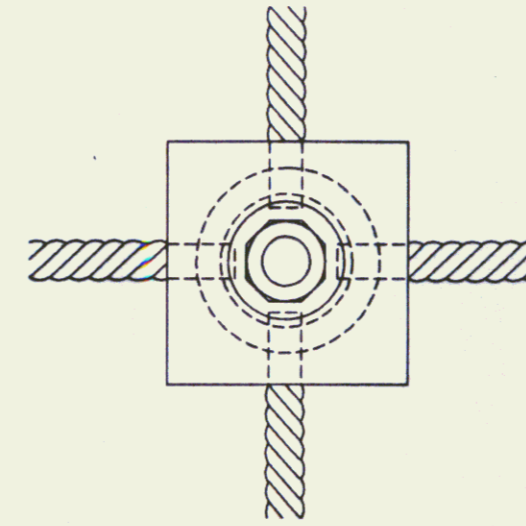

TYPE 4 CONNECTOR ASSEMBLY

NOT TO SCALE

SURVEYED BY	DATE
DRAWN BY	DATE 02-91
SQUAD LEADER	PERKINS
DESIGN FILE NO.	ZG0150.63189A006.DGN
PRF FILE	89A006D13.PRF DATE PLOTTED 22-AUG-1991
THETFORD-FAIRLEE IR 091-2(7)	
R.O.W. SHEET 5 OF 12 SHEETS	

FEB 07 1997