

STATE OF VERMONT
AGENCY OF TRANSPORTATION



PROPOSED IMPROVEMENT
TOWN OF BRISTOL
COUNTY OF ADDISON


VT. ROUTE 17 (F.A.P.) & VT. ROUTE 116 (F.A.P.)

BEGINNING AT A POINT APPROXIMATELY 100 FEET WESTERLY OF THE VT. 17 - VT. 116 INTERSECTION AND EXTENDING EASTERLY 600 FEET.


LENGTH OF ROADWAY 600.00 FEET= 0.114 MILES
LENGTH OF PROJECT 600.00 FEET= 0.114 MILES

THE PURPOSE OF THIS PROJECT IS TO IMPROVE THE SIGHT DISTANCE APPROACHING THE INTERSECTION FROM THE EAST, INCLUDING GRADING, DRAINAGE, SUBBASE, BASE, AND SURFACE.

LENGTH OF R.O.W. PROJECT 800.00 FEET = 0.152 MILES

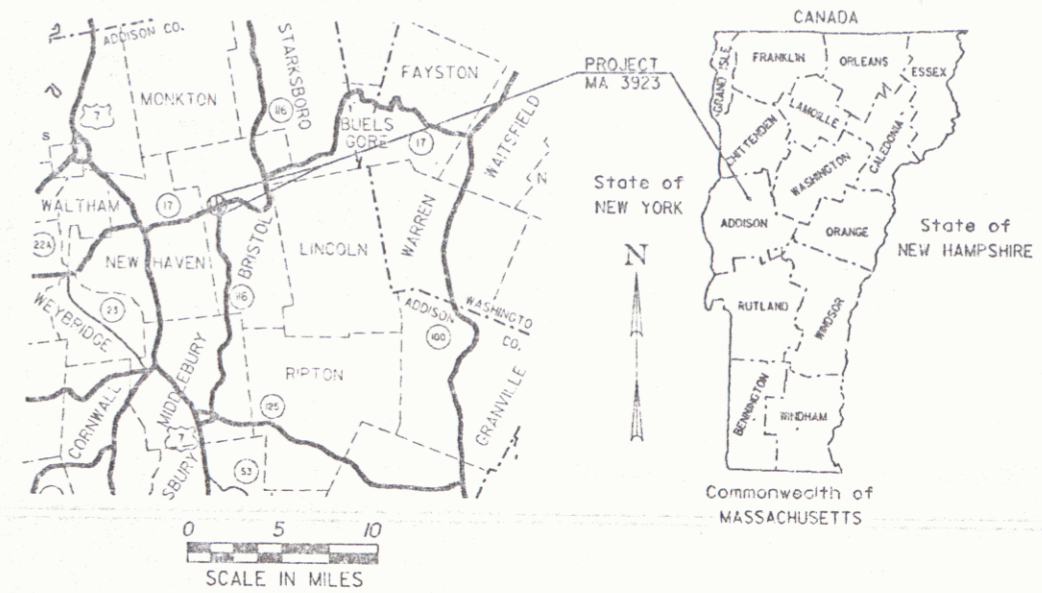

R.O.W. PLANS

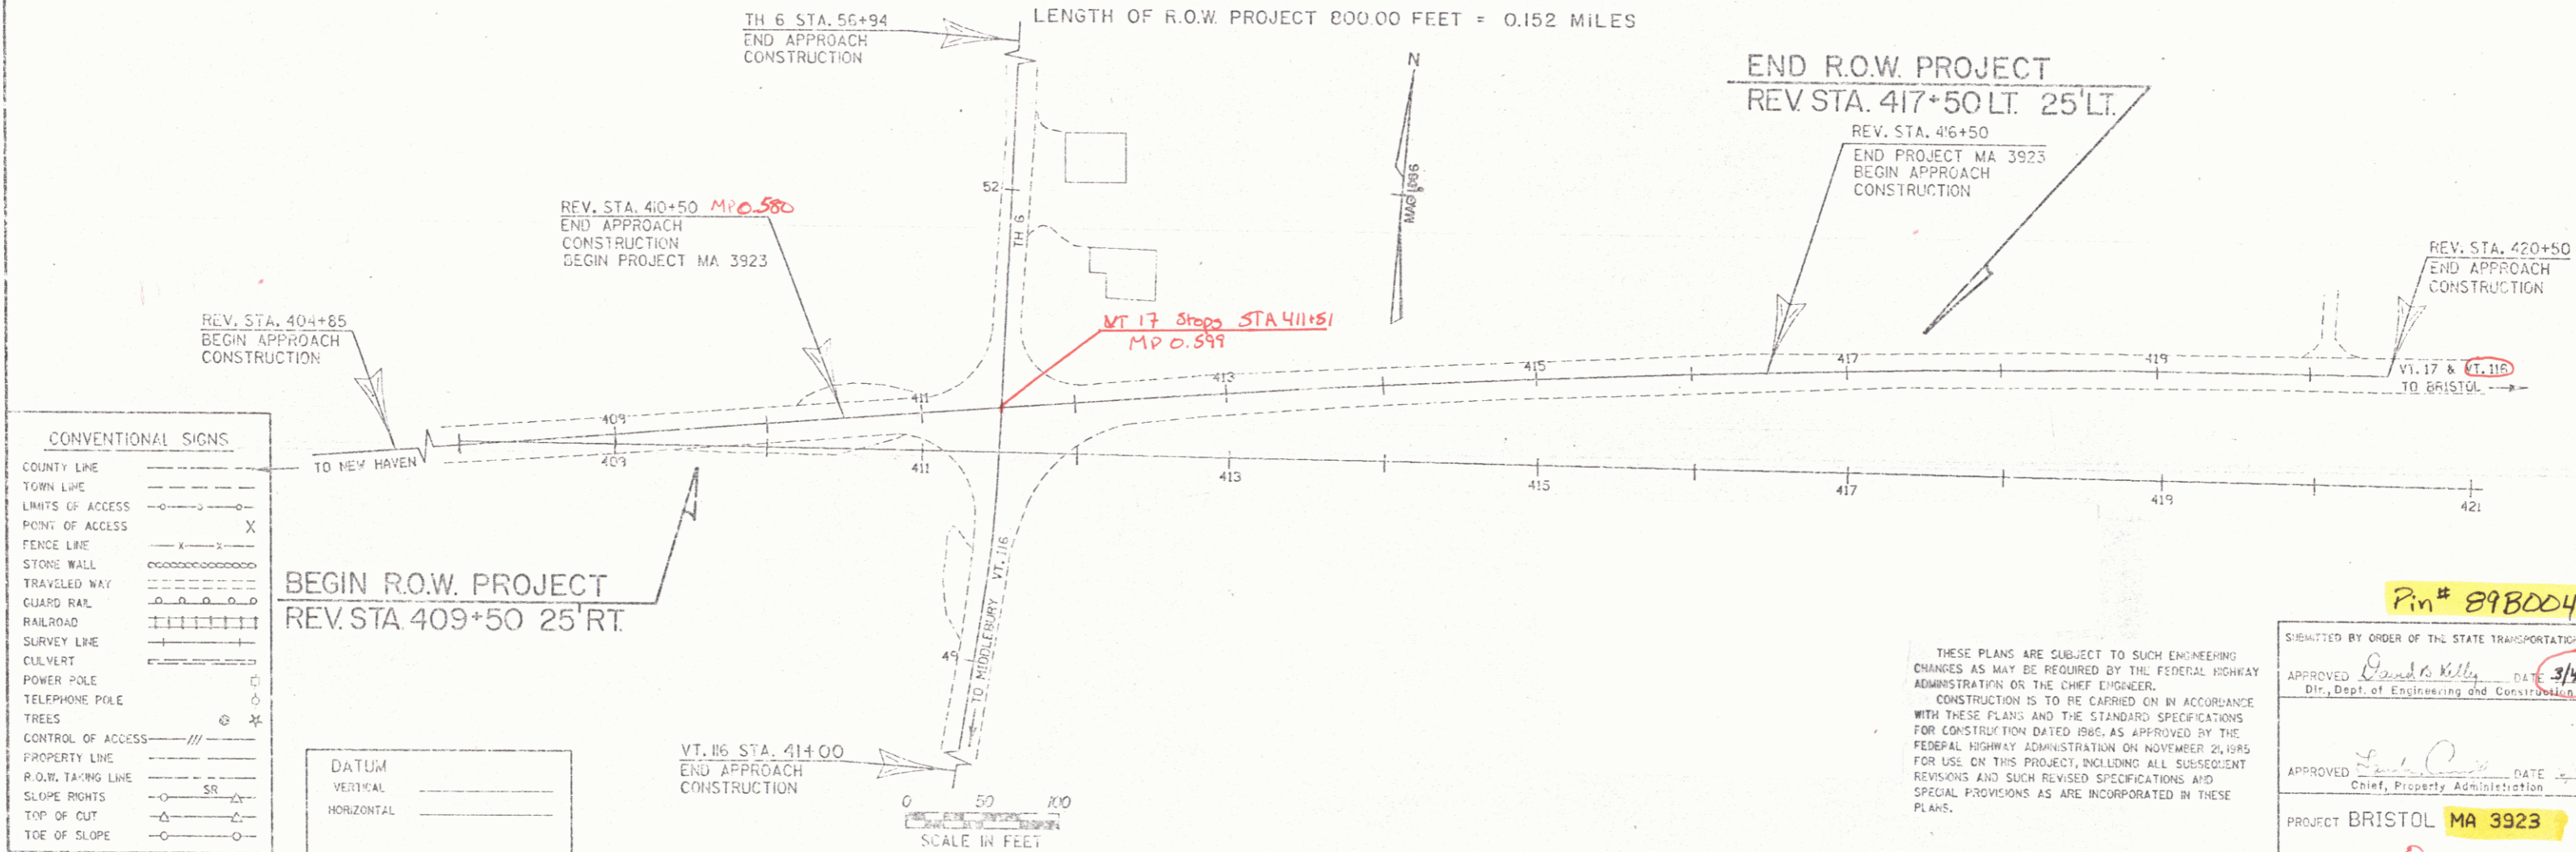

THESE PLANS ARE SUBJECT TO SUCH ENGINEERING CHANGES AS MAY BE REQUIRED BY THE FEDERAL HIGHWAY ADMINISTRATION OR THE CHIEF ENGINEER. CONSTRUCTION IS TO BE CARRIED ON IN ACCORDANCE WITH THESE PLANS AND THE STANDARD SPECIFICATIONS FOR CONSTRUCTION DATED 1986, AS APPROVED BY THE FEDERAL HIGHWAY ADMINISTRATION ON NOVEMBER 21, 1985 FOR USE ON THIS PROJECT, INCLUDING ALL SUBSEQUENT REVISIONS AND SUCH REVISED SPECIFICATIONS AND SPECIAL PROVISIONS AS ARE INCORPORATED IN THESE PLANS.

Pin # 898004

APPROVED *David A. Kelly* DATE 3/4/89
Dir., Dept. of Engineering and Construction

APPROVED _____ DATE _____
Chief, Property Administration

PROJECT BRISTOL MA 3923

SHEET 1 OF 5 SHEETS