

Revised 11-07-01

STATE OF VERMONT AGENCY OF TRANSPORTATION




PROPOSED IMPROVEMENT CITY OF MONTPELIER COUNTY OF WASHINGTON MONTPELIER STATE HIGHWAY (PRINCIPAL ARTERIAL) F EGC-F 028-2(8)

BEGINNING AT MM 0.000 ON THE MONTPELIER STATE HIGHWAY AND EXTENDING NORTH-EASTERLY 0.854 MILES ON THE MONTPELIER STATE HIGHWAY TO MM 0.854

LENGTH OF ROADWAY 4750 FEET= 0.900 MILES
LENGTH OF PROJECT 4750 FEET= 0.900 MILES

WORK TO BE PERFORMED UNDER THIS PROJECT INCLUDES WIDENING OF SECTIONS OF EXISTING ROADWAY AND RAMPS AND RESURFACING OF EXISTING ROADWAY AND SHOULDERS, FROM STA. 0+00 TO STA. 47+50, SECTIONS OF RAMPS "A" AND "B", DOG RIVER ROAD FROM STA. 30+40 TO 34+00 AND RAMPS "N" AND "M", WITH A LEVELING COURSE AND A 1 3/4" OVERLAY OF BITUMINOUS CONCRETE PAVEMENT. OTHER WORK TO BE PERFORMED UNDER THIS PROJECT INCLUDES REMOVING AND RESETTING OF GRANITE CURB, UPGRADING SUBSTANDARD 3-CABLE GUARDRAIL TO APPROVED STANDARDS, AND UPGRADING SIGNS AND SUPPORTS.

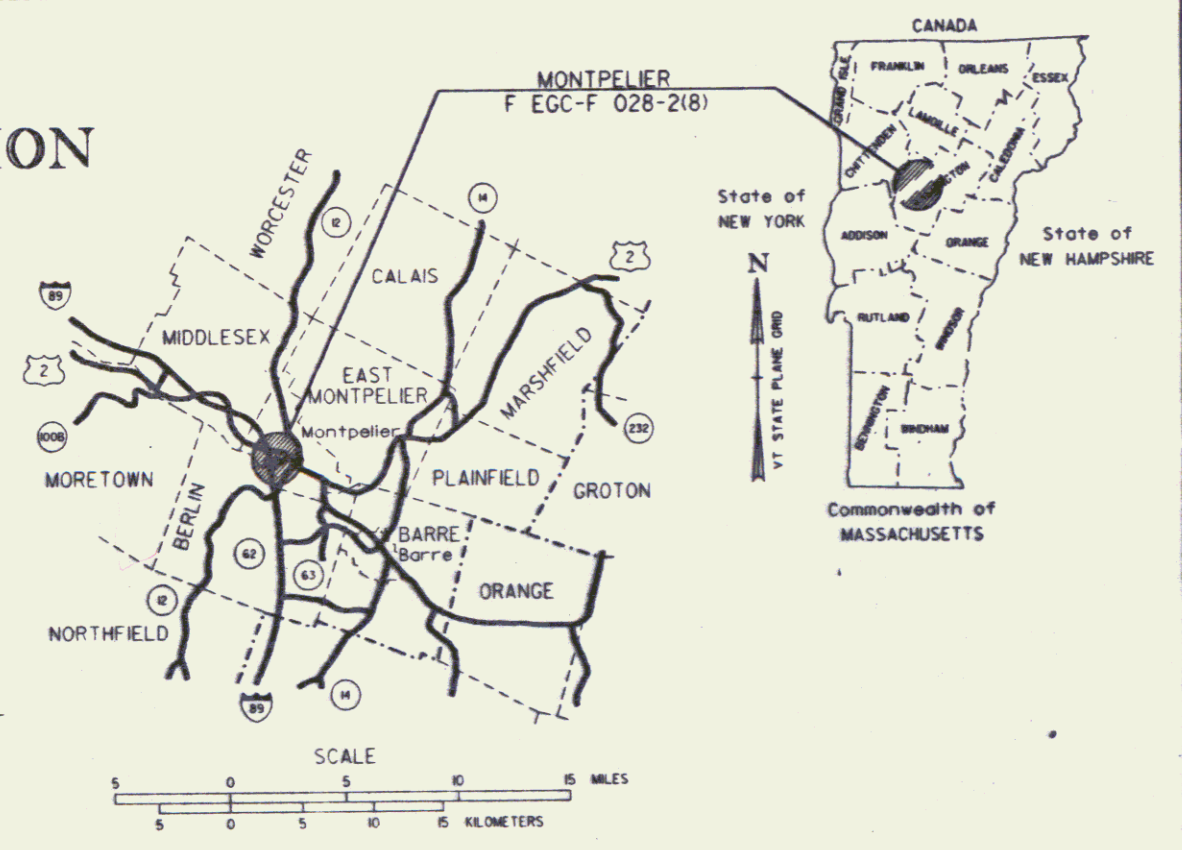


R.O.W. PLANS

SURVEY STA 0+00
BEGIN PROJECT MONTPELIER F EGC-F 028-2(8)
MM 0.000 ON MONTPELIER STATE HWY.

CONVENTIONAL SIGNS	
COUNTY LINE	---
TOWN LINE	----
LIMITS OF ACCESS	---X---
POINT OF ACCESS	X
FENCE LINE	-----
STONE WALL	-----
TRAVELED WAY	-----
GUARD RAIL	-----
RAILROAD	-----
SURVEY LINE	-----
CULVERT	-----
POWER POLE	○
TELEPHONE POLE	◇
TREES	●
CONTROL OF ACCESS	///
PROPERTY LINE	-----
R.O.W. TAKING LINE	-----
SLOPE RIGHTS	SR
TOP OF CUT	△
TOE OF SLOPE	○

DATUM	
VERTICAL	NGVD 1929
HORIZONTAL	N/A

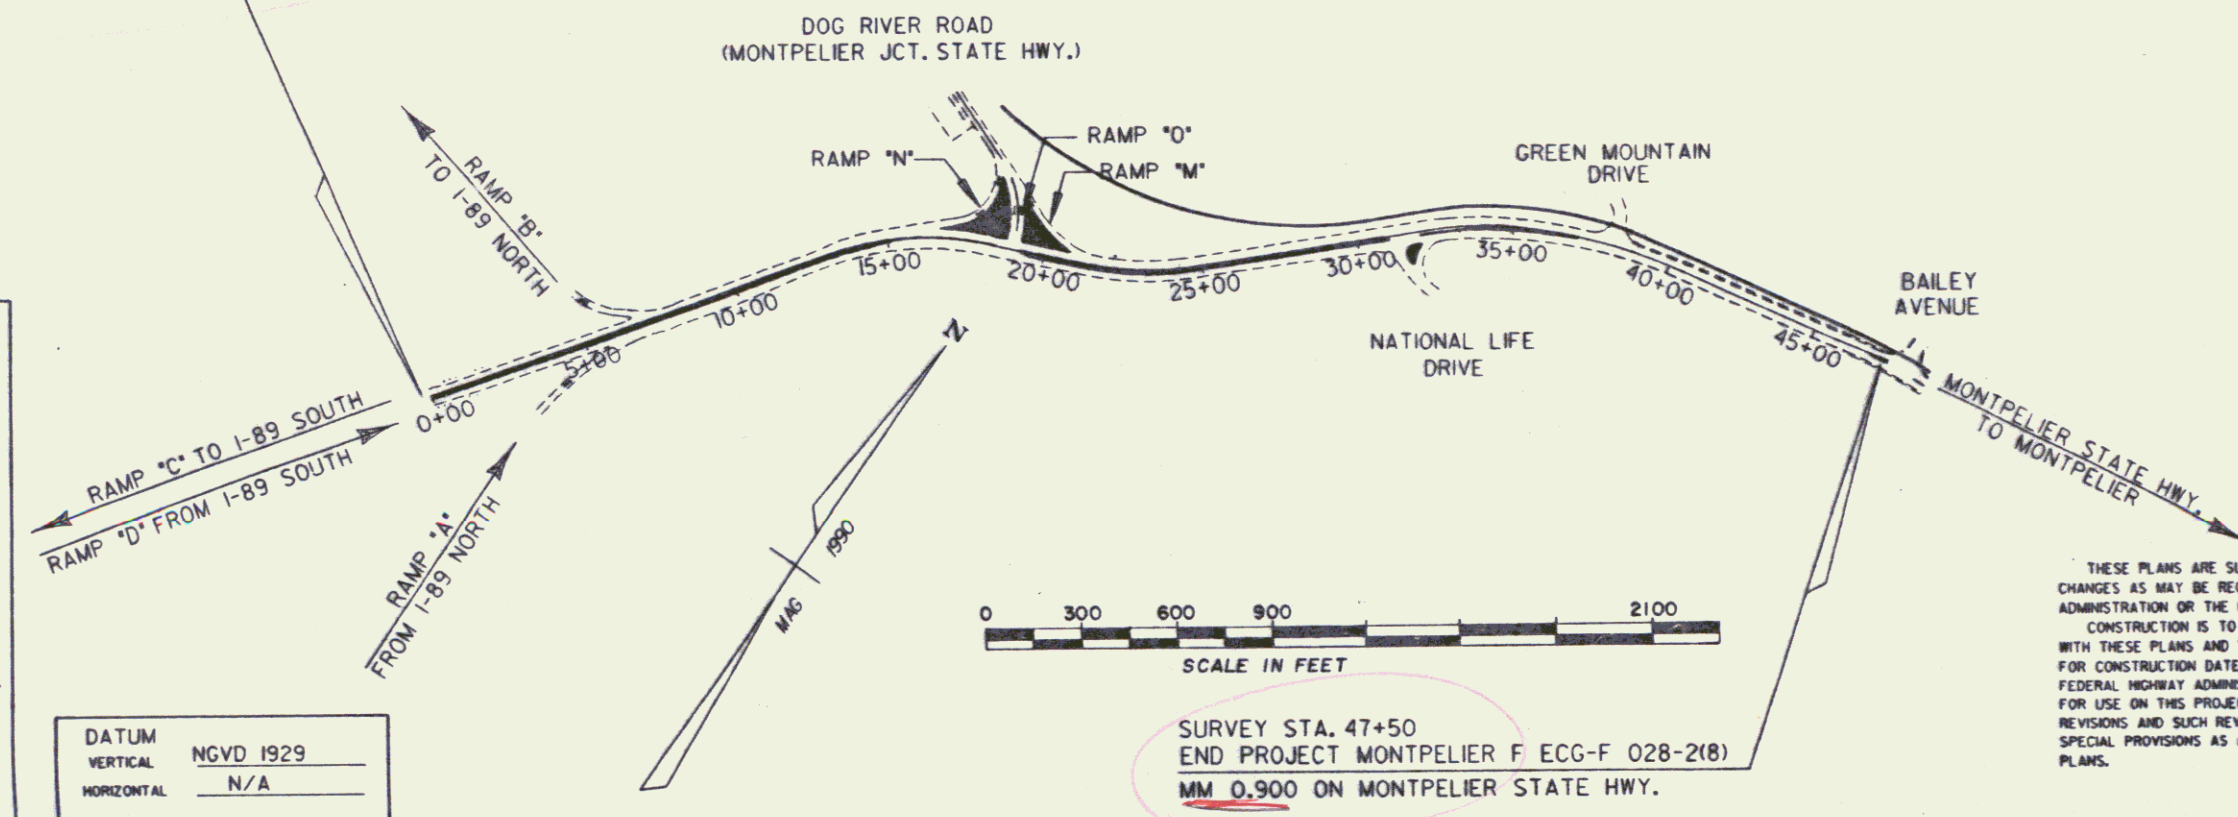

SURVEY STA. 47+50
END PROJECT MONTPELIER F EGC-F 028-2(8)
MM 0.900 ON MONTPELIER STATE HWY.

THESE PLANS ARE SUBJECT TO SUCH ENGINEERING CHANGES AS MAY BE REQUIRED BY THE FEDERAL HIGHWAY ADMINISTRATION OR THE CHIEF ENGINEER. CONSTRUCTION IS TO BE CARRIED ON IN ACCORDANCE WITH THESE PLANS AND THE STANDARD SPECIFICATIONS FOR CONSTRUCTION DATED 1990, AS APPROVED BY THE FEDERAL HIGHWAY ADMINISTRATION ON MARCH 15, 1990 FOR USE ON THIS PROJECT, INCLUDING ALL SUBSEQUENT REVISIONS AND SUCH REVISED SPECIFICATIONS AND SPECIAL PROVISIONS AS ARE INCORPORATED IN THESE PLANS.

Route #: ST HWY
Pin # 898018

APPROVED: *[Signature]* DATE: 11/19/92
Director of Engineering

APPROVED: *[Signature]* DATE: 3-1-93
Chief of Right of Way

MONTPELIER
F EGC-F 028-2(8)
R.O.W. SHEET 1 OF 15 SHEETS

898018.TIT.PRF