


PARCEL	KIND OF DRIVE	DATE OF INSTRUMENT	GRANTEE	GRANTEE	RECORDED INSTRUMENT	DATE	REMARKS
A	Q.C.D.	12-19-36	MILEFRID DUBOIS	STAYYI	8	129	1-20-37
A'	Q.C.D.	10-9-36	ROY E. FARNSWORTH	"	8	125	10-17-36
A''	Q.C.D.	7-20-37	MILEFRID DUBOIS	"	8	134	7-27-37

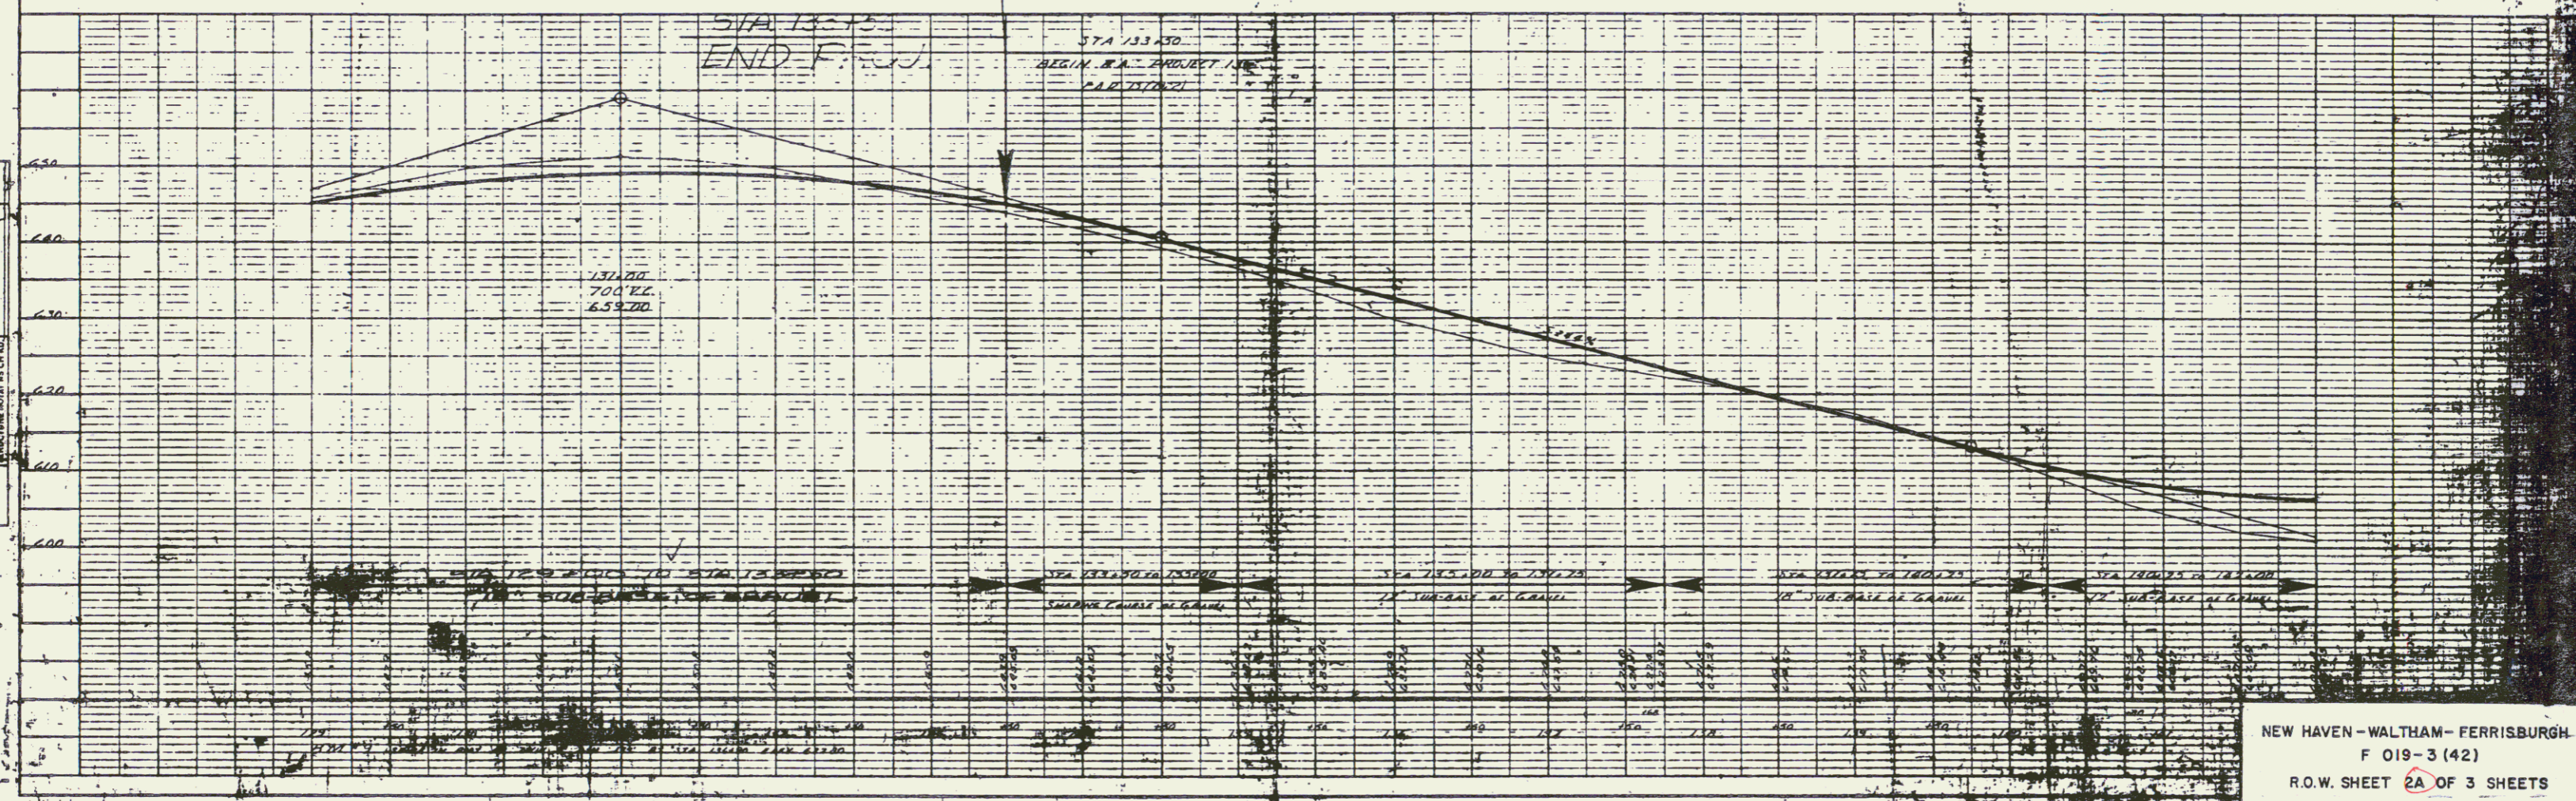

PLAN
 DRAWN BY: [Name]
 CHECKED BY: [Name]
 DATE: [Date]

PROFILE
 DRAWN BY: [Name]
 CHECKED BY: [Name]
 DATE: [Date]