


FARNSWORTH, WILLIS H. & MARGARET L.

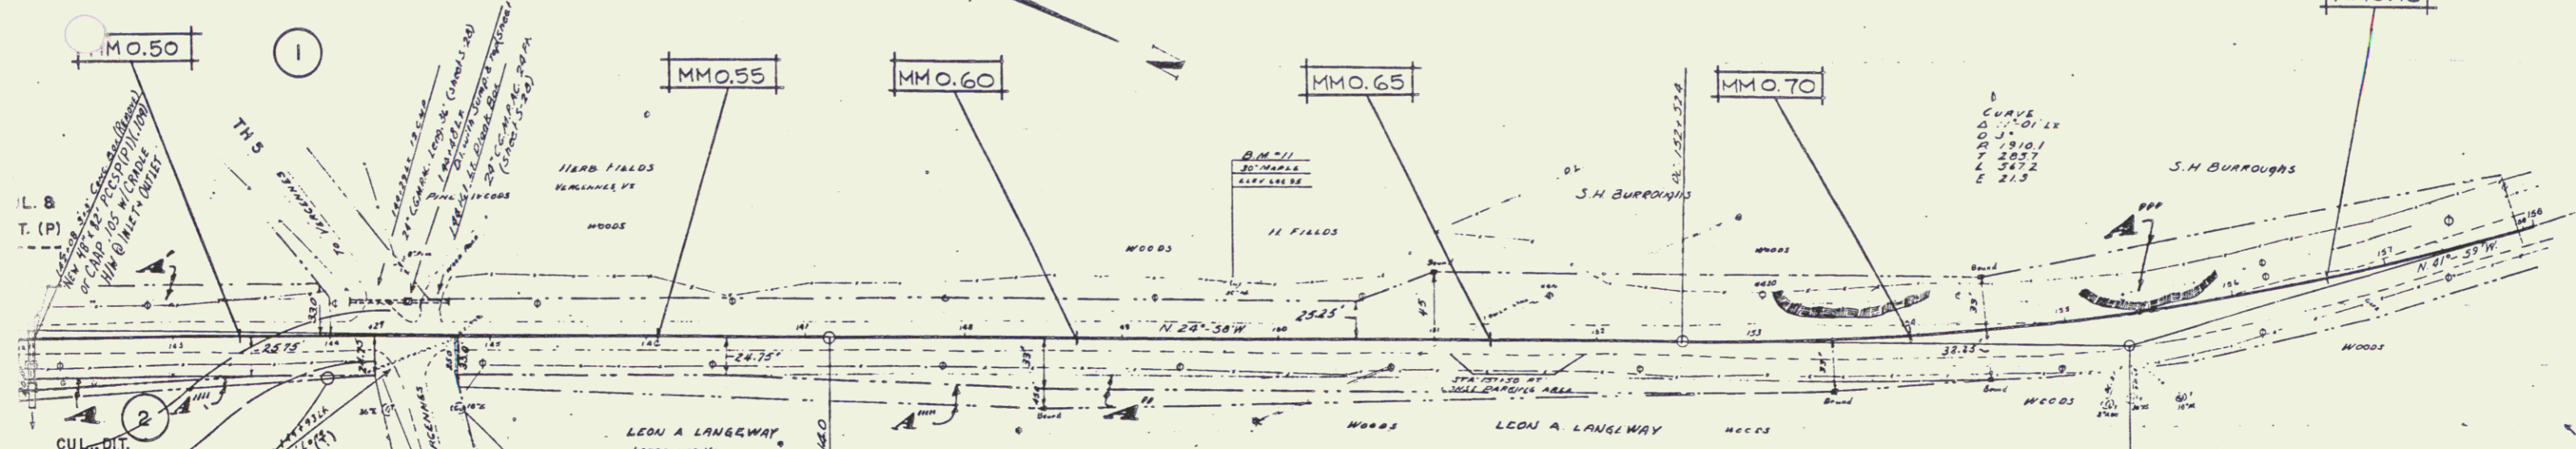

PARCEL	GRANTOR	STATION	RIGHTS	TITLE	DATE	TOWN RECORDED	BK	PG
1	FARNSWORTH, WILLIS H. & MARGARET L.	140+50 LT. 143+50 LT.	REMOVE & RESET FENCE (T)	WDOE	07-31-92	WALTHAM	16	9-10
2	deBOER, JOANNAS J. & TINI	141+88 LT. 142+28 LT. 142+08 RT.	CUL. & DIT. (P) 1000SF± CUL., DIT. & DR. (P)	WDOE		WALTHAM		
2A		140+25 RT. 144+00 RT.	EASE FOR DETOUR (T) 0.57 A±	AGREE				

PARCEL	GRANTOR	STATION	RIGHTS	TITLE	DATE	TOWN RECORDED	BK	PG
1	FARNSWORTH, WILLIS H. & MARGARET L.	140+50 LT. 143+50 LT.	REMOVE & RESET FENCE (T)	WDOE	07-31-92	WALTHAM	16	9-10
2	deBOER, JOANNAS J. & TINI	141+88 LT. 142+28 LT. 142+08 RT.	CUL. & DIT. (P) 1000SF± CUL., DIT. & DR. (P)	WDOE		WALTHAM		
2A		140+25 RT. 144+00 RT.	EASE FOR DETOUR (T) 0.57 A±	AGREE				

Myers to Design 526-92
Prints to FHWA 7-27-92
NEW MYLARS TO DESIGN 9-1-92
NEW PRINTS TO FHWA 9-1-92

