


FARNSWORTH, WILLIS H. & MARGARET L.

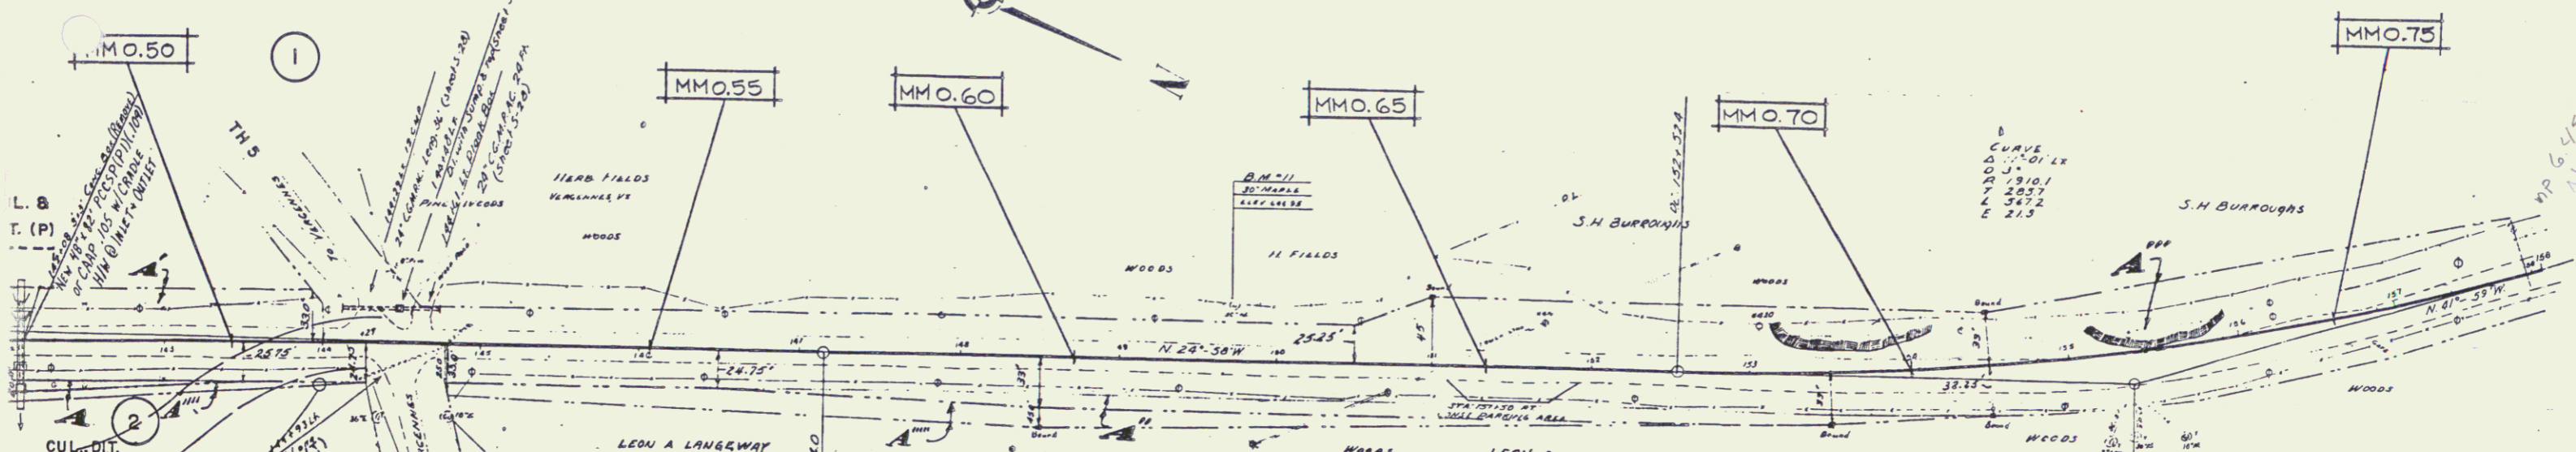


Parcel Kind & Date of Instrument

Parcel	Kind	Date of Instrument	Grantor	Grantee	Recorded	Remarks
A	O.C.D.	12-19-36	MILFRID DUBOIS	STOFF, B	129	120-37
A-1	O.C.D.	10-9-36	JOVE-EMM FARNSWORTH	"	125	10-17-36
A-2	O.C.D.	10-9-36	LEON A. LANGWAY	"	123	10-17-36
A-3	O.C.D.	10-9-36	J.H. BURROUGHS	"	123	10-17-36
A-4	O.C.D.	7-20-37	MILFRID DUBOIS	"	134	7-27-37
A-5	O.C.D.	6-17-37	LEON A. LANGWAY	"	134	7-27-37

PARCEL	GRANTOR	STATION	RIGHTS	TITLE	DATE	TOWN RECORDED	BK	PG
1	FARNSWORTH, WILLIS H. & MARGARET L.	140+50 LT.	REMOVE & RESET	WDOE	07-31-92	WALTHAM	16	9-10
		143+50 LT.	FENCE (T)					
		141+88 LT.	CUL. & DIT. (P) 1000 SF					
2	deBOER, JOANNAS J. & TINI	142+08 RT.	CUL., DIT. & DR. (P)	WDOE		WALTHAM		
		2A	140+25 RT.-144+00 RT.					

MyLars to Design 5-26-92
 Prints to FHWA 7-27-92
 NEW MYLARS TO DESIGN 9-1-92
 NEW PRINTS TO FHWA 9-1-92

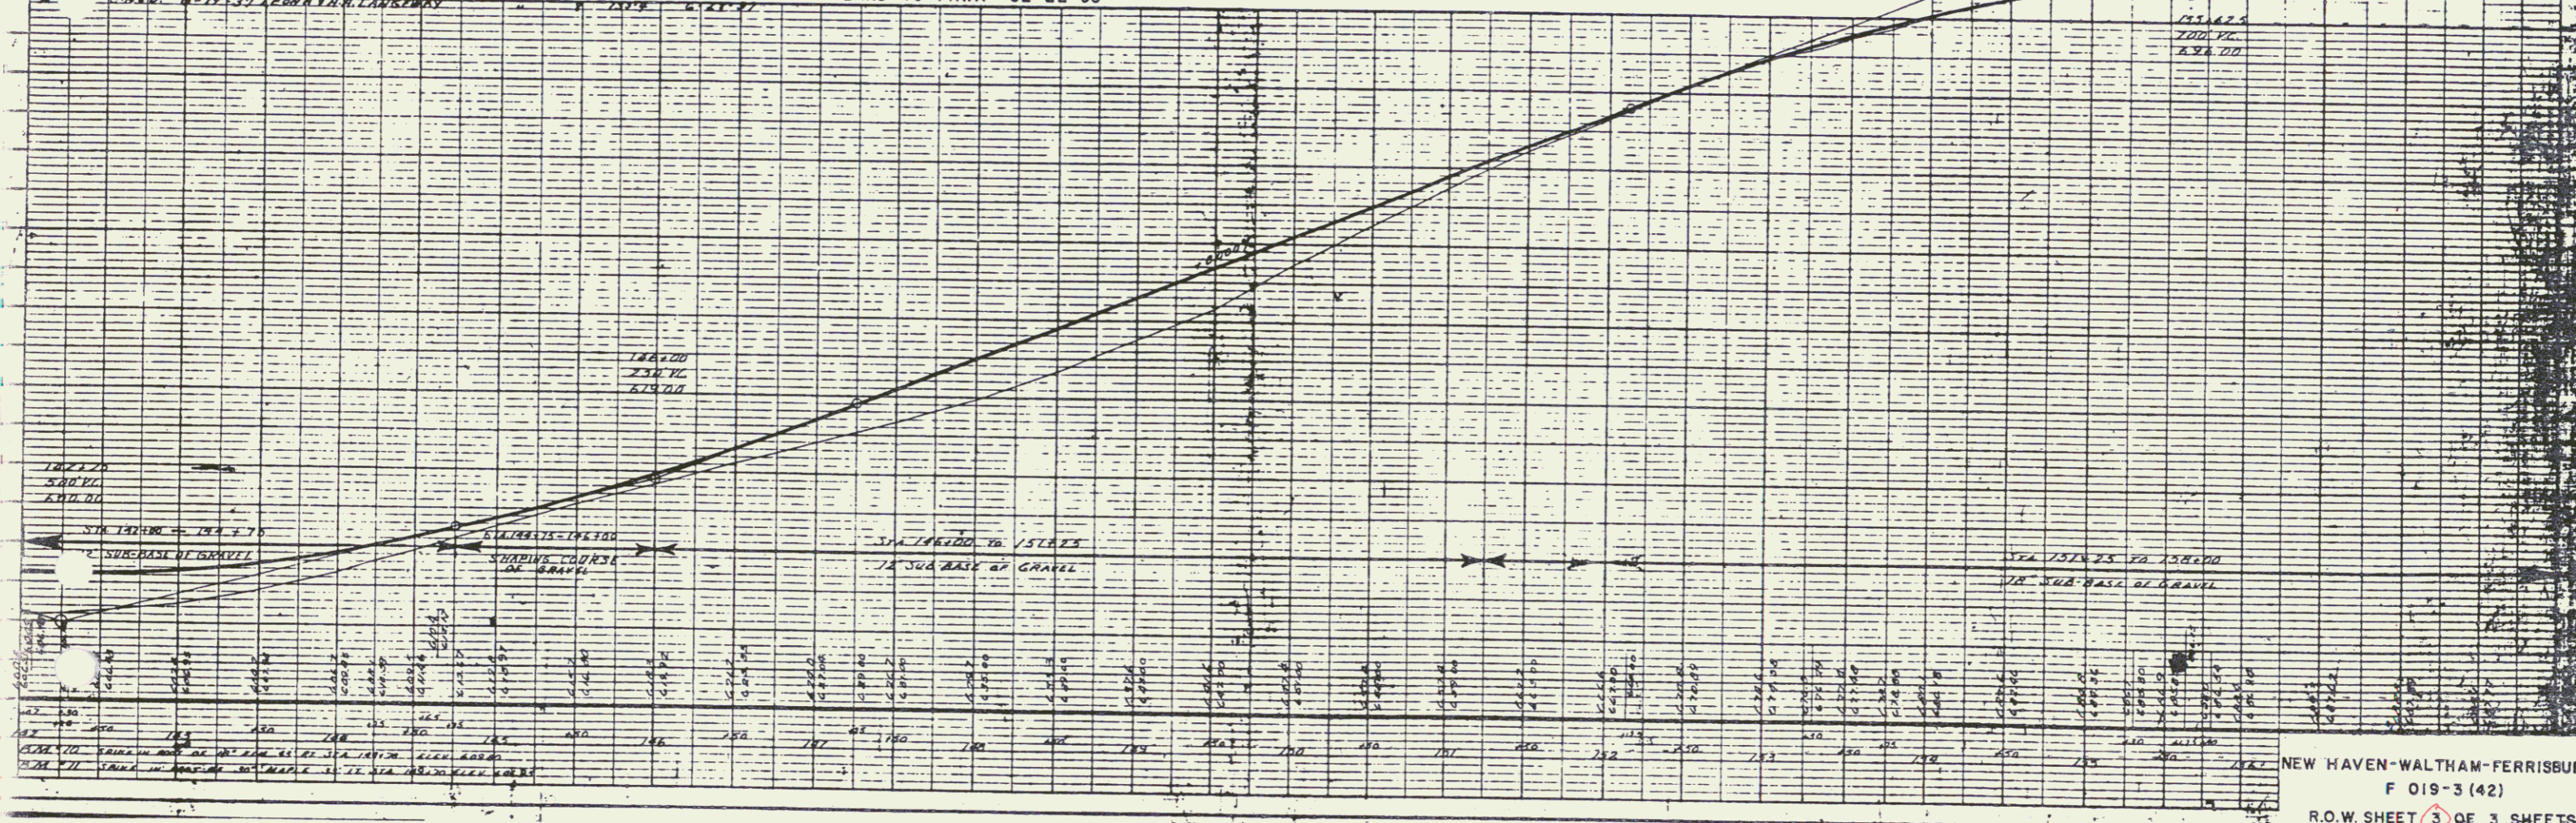

NEW HAVEN-WALTHAM-FERRISBURGH
 F 019-3 (42)
 R.O.W. SHEET 3 OF 3 SHEETS