


STATE OF VERMONT
AGENCY OF TRANSPORTATION



PROPOSED IMPROVEMENT
TOWN OF HANCOCK
COUNTY OF ADDISON
VERMONT ROUTE 100

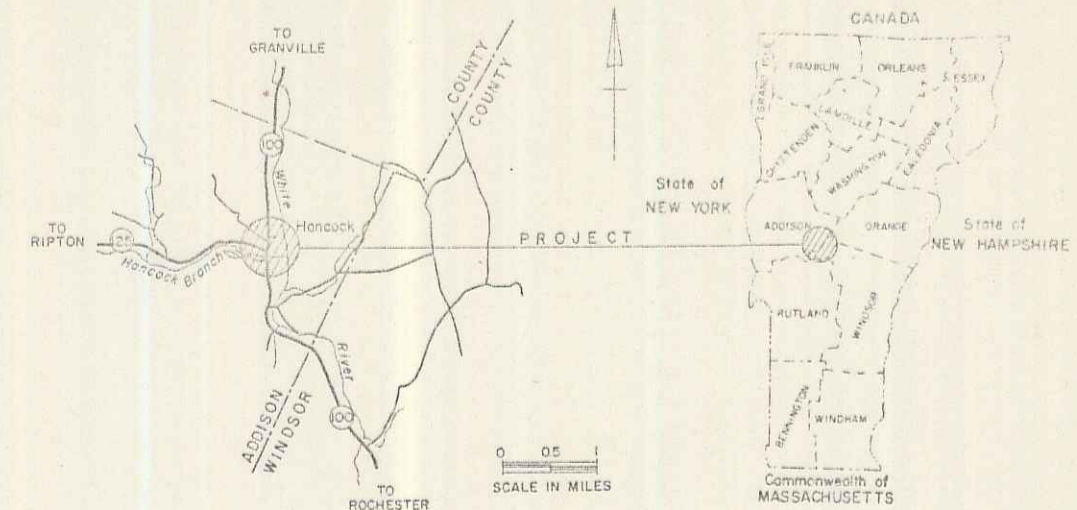


TRAFFIC DATA
1979 AADT = 2030
1979 ADHV = 2450
1989 ADHV = 370
D = 5%
T = 9.5%
V = 40 MPH

BHF 013-4(5)S
BEGINNING AT A POINT 0.049 MILES SOUTH OF THE INTERSECTION OF VT. RTE. 125 AND VT. RTE. 100 AND EXTENDING NORTHERLY 0.085 MILES.
LENGTH OF ROADWAY 450 FT. = 0.085 MI.
LENGTH OF BRIDGE 34.39 FT. = 0.065 MI.
LENGTH OF PROJ. 450 FT. = 0.085 MI.
LENGTH OF R.O.W. 550 FT. = 0.104 MI.

HES 013-4(2)S
BEGINNING AT A POINT 0.036 MILES NORTH OF THE INTERSECTION OF VT. RTE. 125 AND VT. RTE. 100 AND EXTENDING NORTHERLY 0.085 MILES.
LENGTH OF PROJ. 450 FT. = 0.085 MI.
LENGTH OF R.O.W. 575 FT. = 0.109 MI.

TRAFFIC DATA
1979 AADT = 1380
1989 AADT = 1660
1989 ADHV = 250
D = 5%
T = 9.5%
V = 40 MPH
5 Year Accidents = 4


R.O.W. PLANS

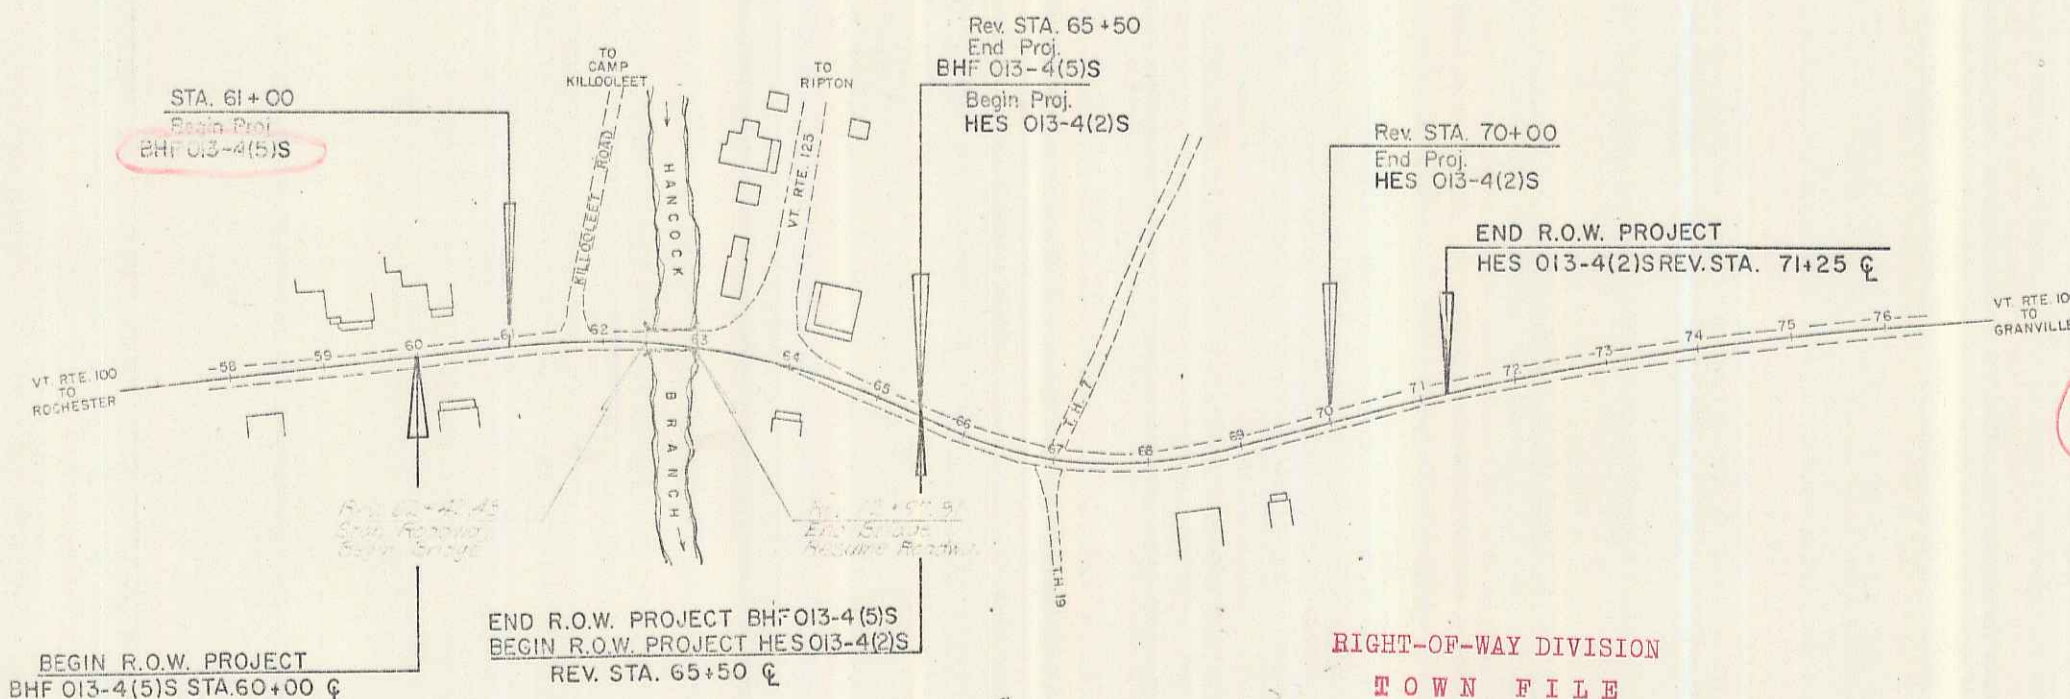

- CONVENTIONAL SIGNS**
- COUNTY LINE
 - TOWN LINE
 - LIMITS OF ACCESS
 - POINT OF ACCESS
 - FENCE LINE
 - STONE WALL
 - TRAVELED WAY
 - SHARD RAIL
 - RAILROAD
 - SURVEY LINE
 - CULVERT
 - POWER POLE
 - TELEPHONE POLE
 - TREES
 - CONTROL OF ACCESS
 - PROPERTY LINE
 - R.O.W. TAKING LINE
 - SLOPE RIGHTS
 - TOP OF CUT
 - TOE OF SLOPE

DATUM

VERTICAL	
HORIZONTAL	

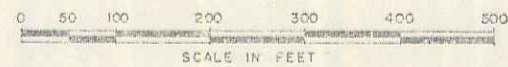

RIGHT-OF-WAY DIVISION
TOWN FILE
PERPETUAL
Town of VT 100
(To Be Returned To R.O.W. Division)

MP 1.15 to 1.32

DATE: 12/15/78
PROJECT BHF 013-4(5)S
Pin: 90A001

DEC 21 1981

PROJECT PROCESSED UNDER
SECONDARY ROAD PLAN

These plans are subject to such engineering changes as may be required by the Federal Highway Administration or the Director of Engineering and Const. Construction is to be carried on in accordance with these plans and the Standard Specifications for Highway and Bridges Construction dated March, 1976, as approved by the Federal Highway Administration on October 27, 1976, for use on this project, including all subsequent revisions and such revised specifications and special provisions as are incorporated in these plans.

APPROVED: *[Signature]*
CHIEF, PROPERTY ADMINISTRATION
DATE: 12-15-78

SUBMITTED BY ORDER OF THE STATE TRANSPORTATION BOARD	
APPROVED: <i>[Signature]</i>	DATE: 12-15-78
DIRECTOR OF ENGINEERING AND CONSTRUCTION	
DEPARTMENT OF TRANSPORTATION	
FEDERAL HIGHWAY ADMINISTRATION	
APPROVED: _____	DATE: _____
DIVISION ADMINISTRATOR	
PROJECT: HES 013-4(2)S	BHF 013-4(5)S
SHEET: 1	OF 6 SHEETS
DWG: _____	SRP: 12/17/73