
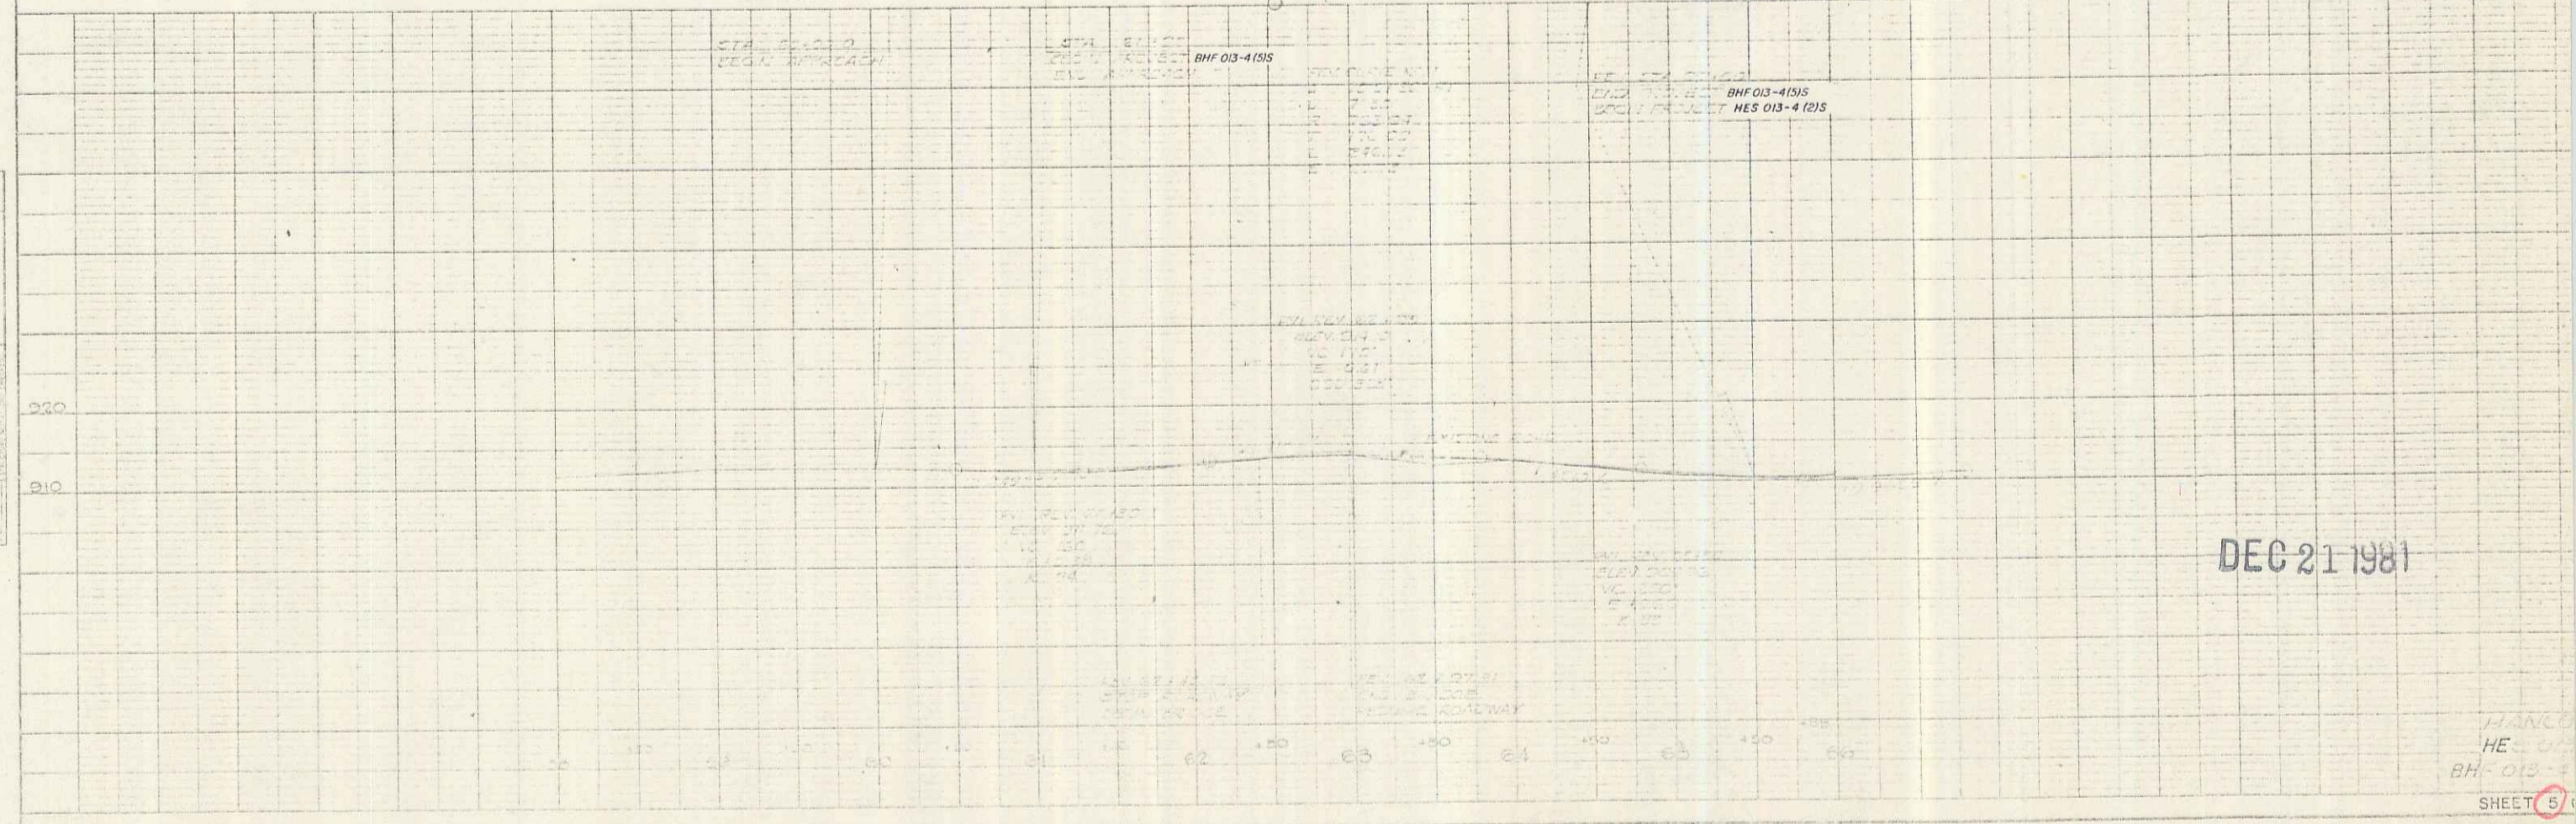


BEGIN R.O.W. PROJECT  
BHF 013-4(5)S STA.60+00 ☐

END R.O.W. PROJECT BHF 013-4(5)  
BEGIN R.O.W. PROJECT HES 013-4  
REV. STA. 65+50 ☐

PLAN	DATE	BY	CHKD

PROFILE	DATE	BY	CHKD

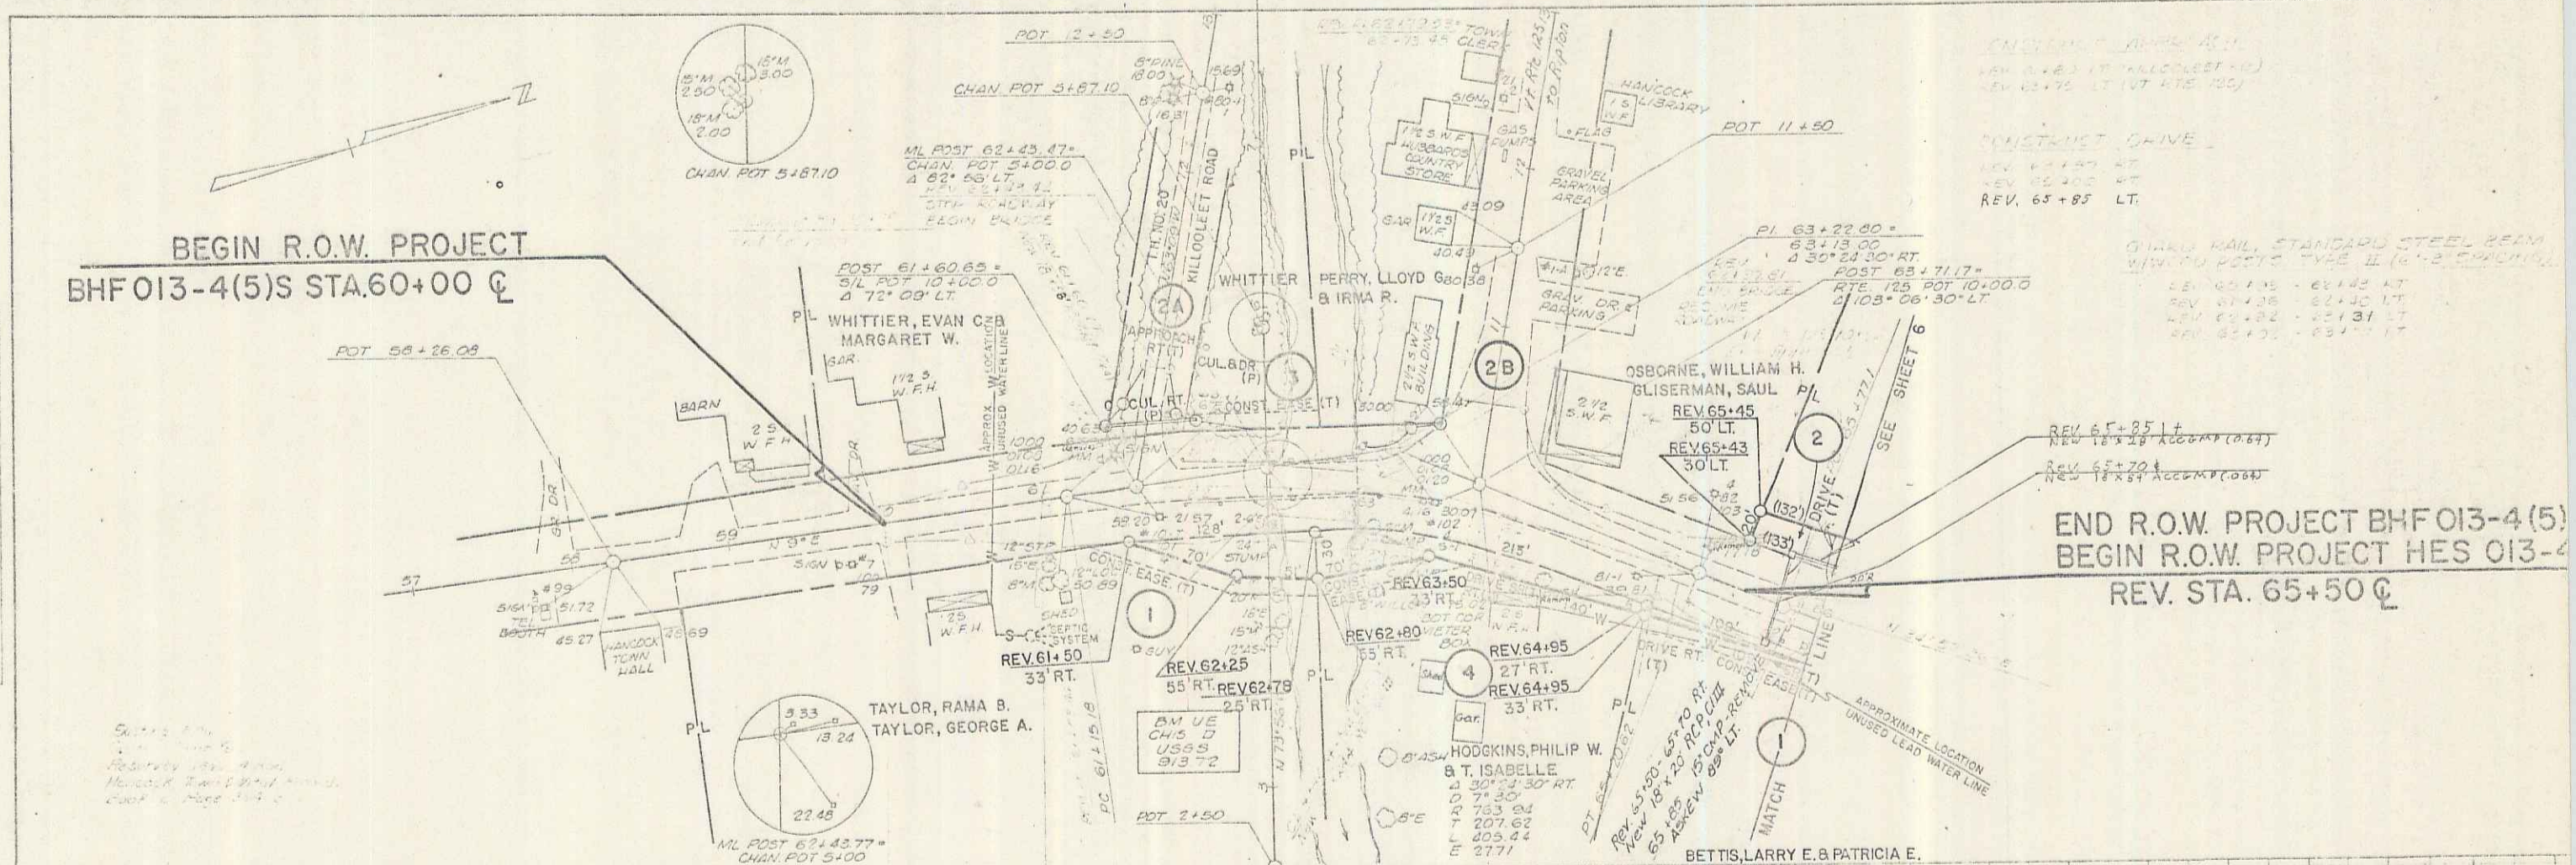

DEC 21 1981

FRANCIS  
HE  
BH-013-4  
SHEET 8

3