

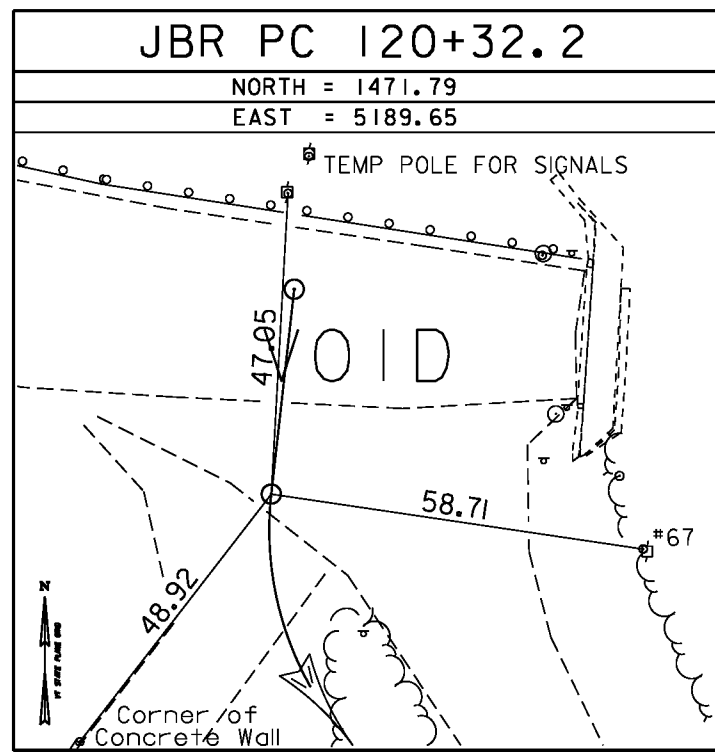
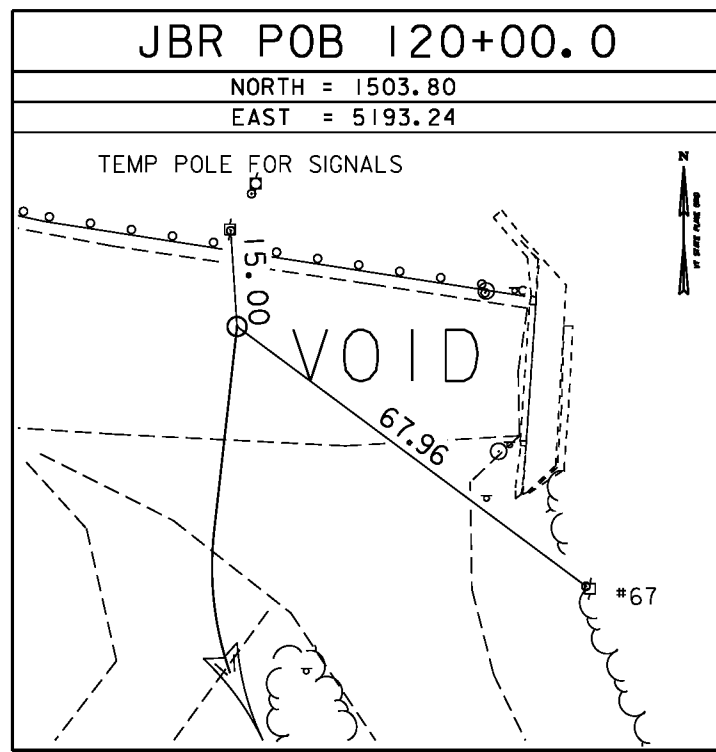
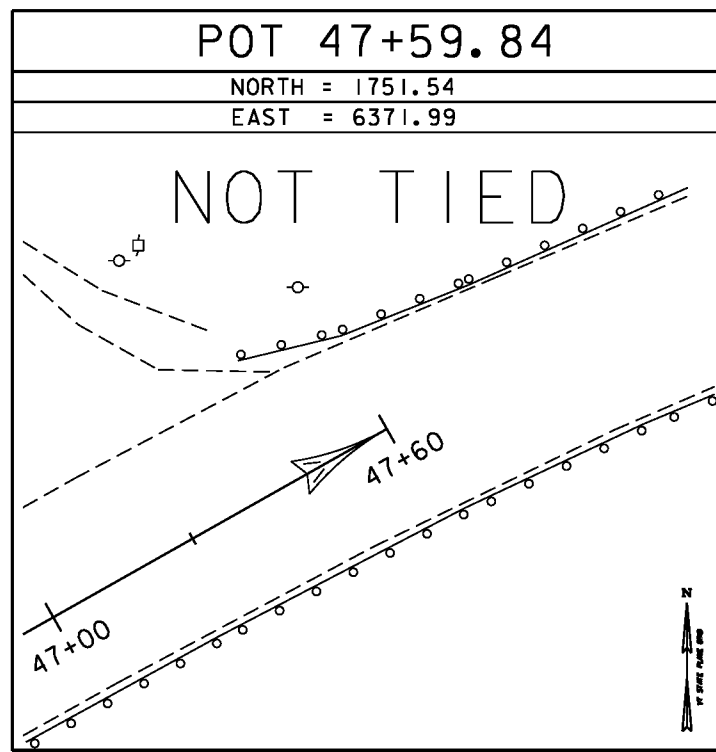
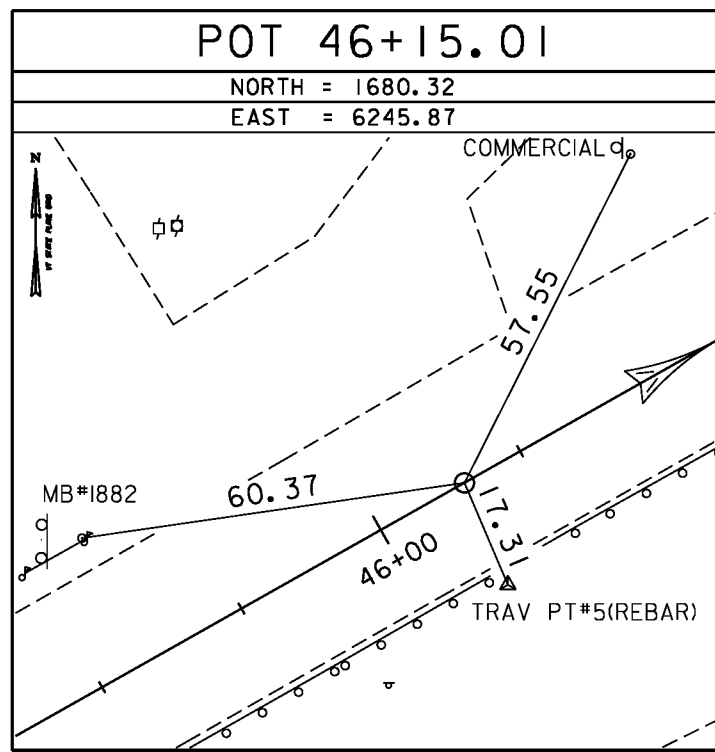
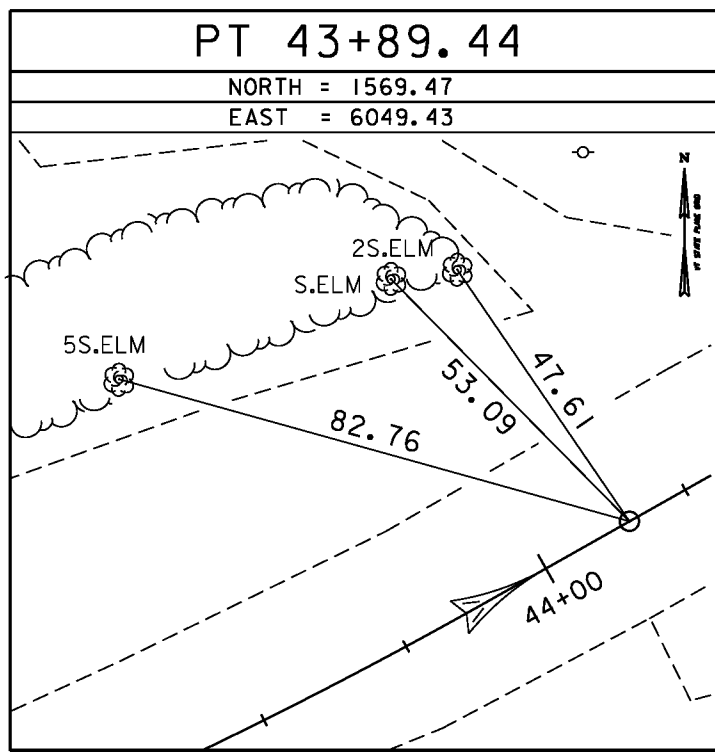
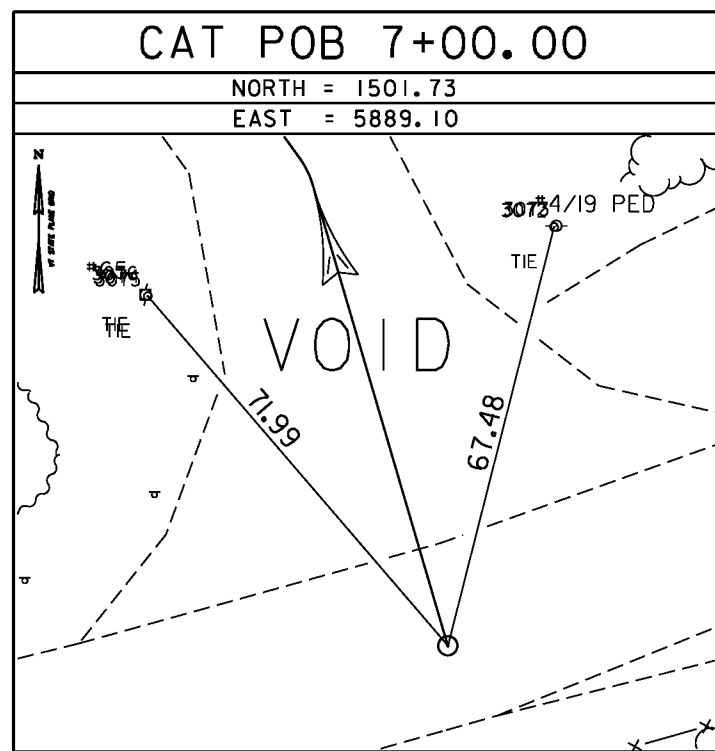
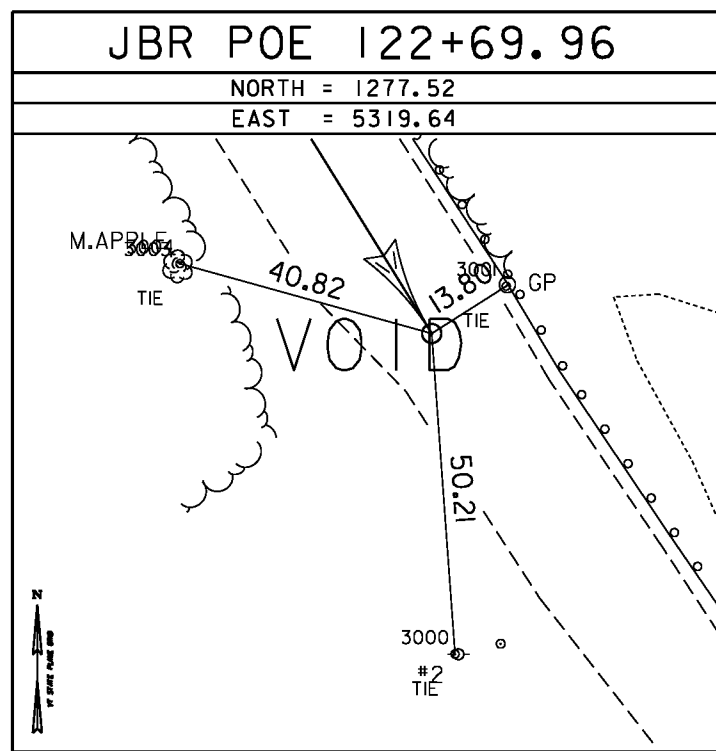
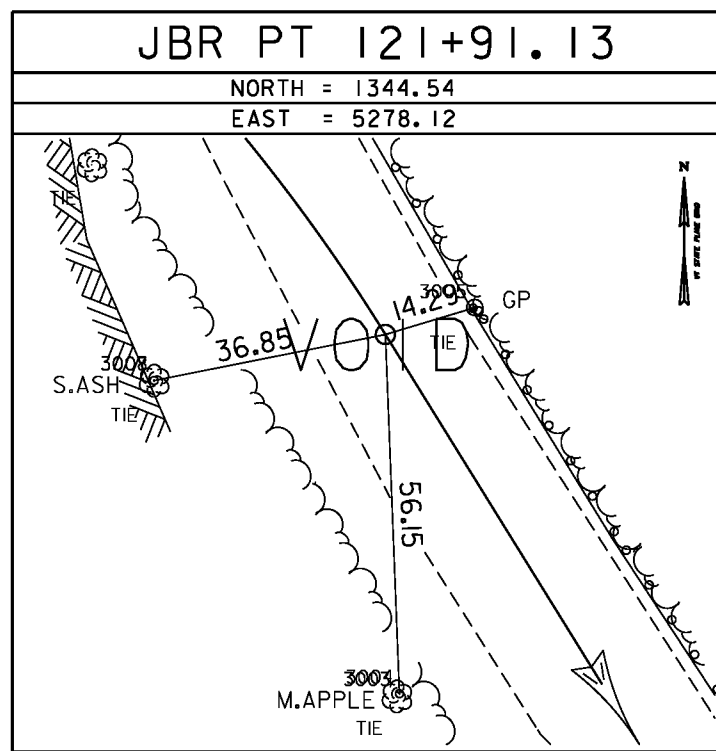


Original Drawing - Ink on polymer meeting the requirements of 27 V.S.A. § 1403




ALIGNMENT TIES

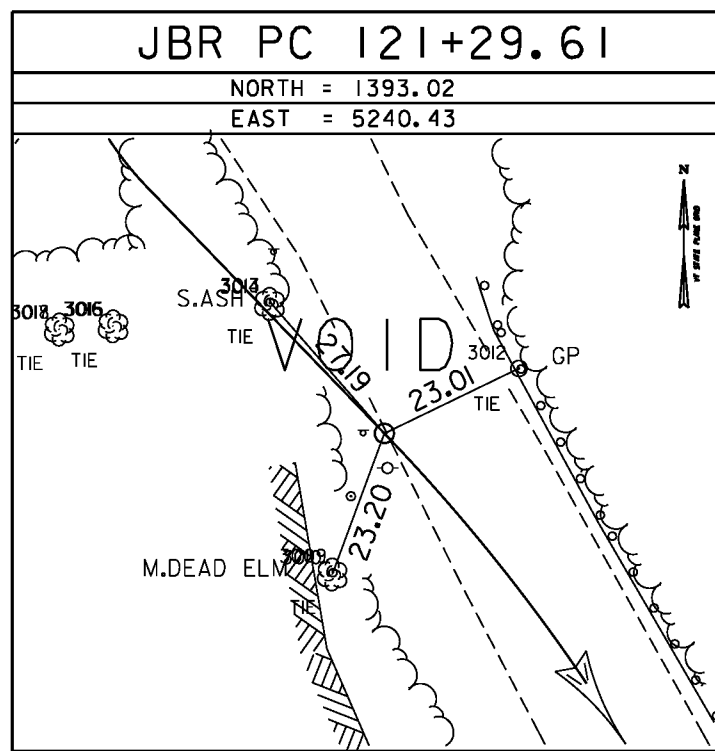

ALIGNMENT TIES

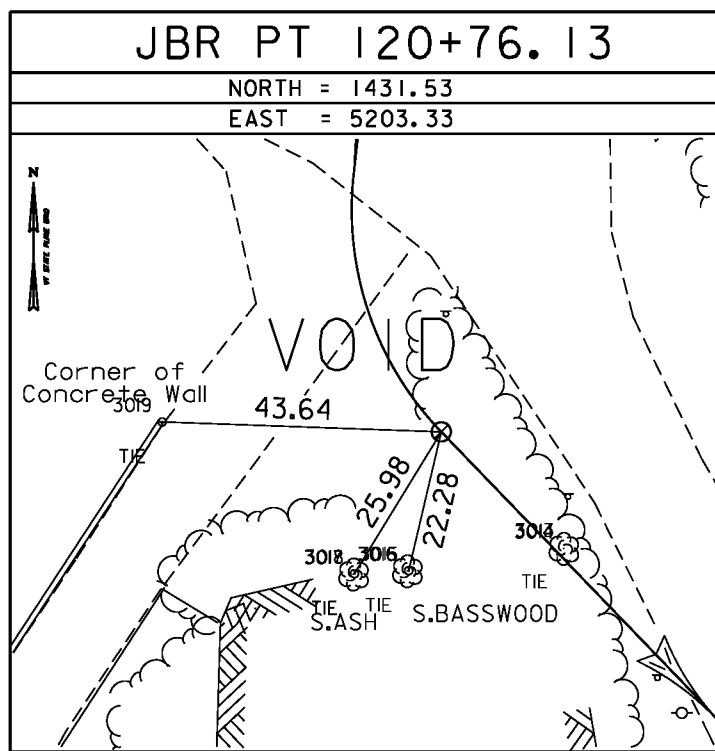

ALIGNMENT TIES

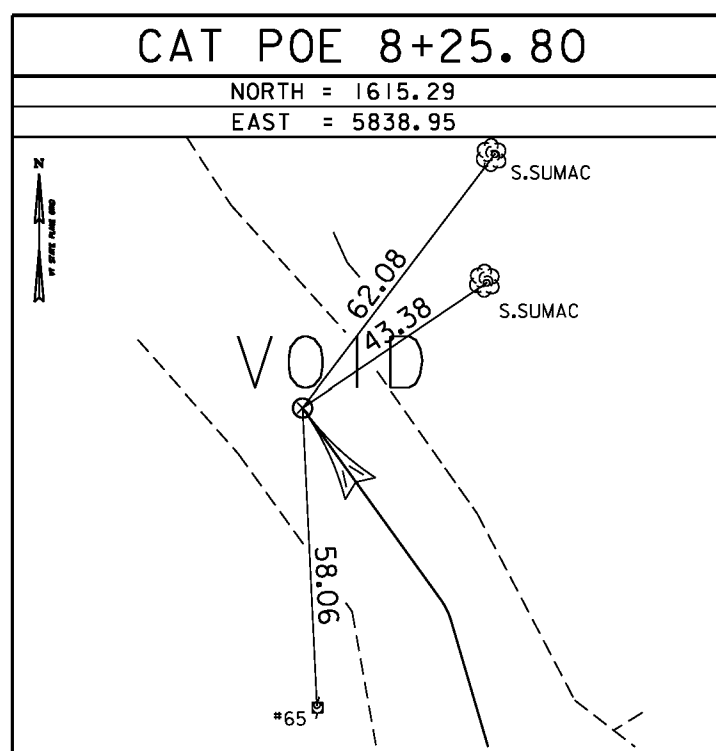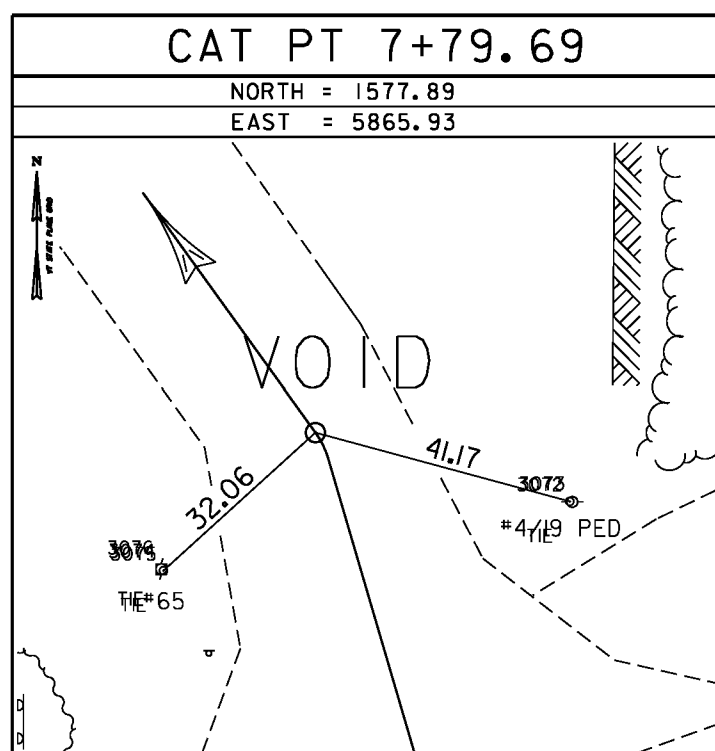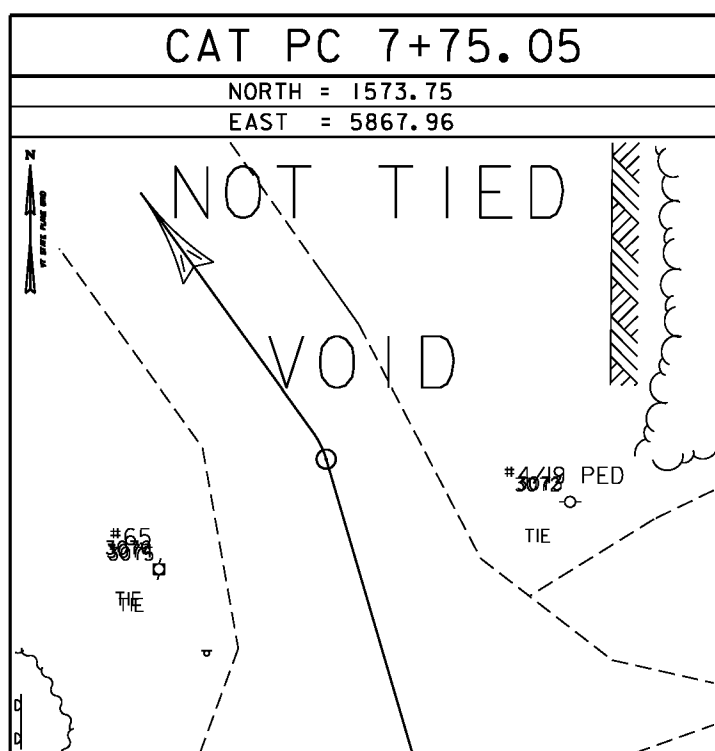

NORTH =  
EAST =

All Side Roads  
Tied, staked and located 01/23/06  
are void as of 02/28/06

NORTH =  
EAST =

DATUM	
VERTICAL	NAVD 88
HORIZONTAL	NAD 83
ADJUSTMENT	Least Squares

PROJECT NAME:	Richmond
PROJECT NUMBER:	BRF RS 0284 (II)
FILE NAME:	90c092/survey/x90c092t1.dgn
PROJECT LEADER:	PLOT DATE: 21-JUN-2010
DESIGNED BY:	DRAWN BY: R. Bullock
	CHECKED BY:
	ROW SHEET 14 OF 24