


# RIGHT - OF - WAY DETAIL SHEET

TABLE OF PROPERTY ACQUISITION

PARCEL NO.	PROPERTY OWNER	SHEET NO.	BEGINNING STATION	ENDING STATION	TAKE	REMAINDER	RIGHT			RECORDING DATA				REMARKS	
					AREA±	AREA±	TYPE	(T)/(P)	AREA ±	TITLE	DATE	TOWN / CITY	BOOK		PAGE
1	STATE OF VERMONT - A.O.T.	21								WD	08/29/08	RICHMOND	185	314	FORMERLY CASSETTA
2A	CONANT, DAVID L. & DEBORAH P., LESSORS; CONANT'S RIVERSIDE FARMS, LLC, LESSEE	21-22	32+10.00 RT. 28+50 RT. 29+19 RT. 29+86 RT. 30+29 RT. 30+36 RT.	32+94.94 RT. 31+58 RT. 29+86 RT. 30+29 RT. 31+58 RT. 31+86 LT.	710 SF		CONST. SLOPE CUL. & DITCH SLOPE INSTALL	(T) (T) (P) (T) (T)	4,100 SF 277 SF 1,607 SF 152 SF	WD	07/28/10	RICHMOND	198	384-388	INCLUDE EC & PDF (NOT SHOWN) INCLUDE STONE FILL & HEADWALL SEPTIC SYSTEM; INCLUDE CONNECTION INSIDE HOUSE SIDEWALK & DRIVE; INSTALL TOPSOIL & SEED; 6,737 SF± SIDEWALK; INCL. SLOPE GRADING 18" GRAVEL; INCL. TURNAROUND
2B		21-22	29+85.00 LT. 25+99 LT. 26+17 LT. 28+48 LT. 29+03 LT. 29+41 LT. 29+77 LT.	36+07.18 LT. 29+85 LT. 35+33 LT. 29+85 LT. 29+90 LT. 30+39 LT.	0.68 A		UTILITY INSTALL & MAINT. CONST. DETOUR DRIVE DIT. DR	(P) (P) (T) (T) (T) (P)	0.26 A 0.18 A 1,830 SF 1,615 SF 2,116 SF						29,460 SF± 11,185 SF± GUY WIRE & ANCHOR 7,770 SF; INCL. EC & PDF (NOT SHOWN) INCL. REMOVE FENCES 24" GRAVEL; MM 0057 INCLUDES STONE FILL; REMOVAL OF EXISTING 36" CULVERT AND DRIVE 12" GRAVEL, TOPSOIL, MM 0058 EXISTING SEPTIC SYSTEM INCLUDES STONE FILL
2C		21-22	28+50.00 LT. 30+97 RT.	36+20.23 RT. 31+42 LT.	0.70 A		ALL R.T.I.								30,430 SF; US RTE 2 & TH 8 HIGHWAY EASEMENT SLEEVE AGREEMENT

TABLE OF REVISIONS

REVISION NO.	SHEET NO.	DESCRIPTION	DATE
1	19,21,22	PARCEL NO. 2 KIM & JOANNE CONANT. REMOVE AS LAND OWNERS. PER C.O. 9600 MADE BY: MT APPROVED BY: HP	02/16/10
2	19,21,22	PARCEL NO. 2 KIM & JOANNE CONANT. REVISED SEPTIC DESIGN, DRIVE #2, CONSTRUCTION EASEMENTS. PER C.O. 9622 MADE BY: MT APPROVED BY: HP	06/21/10

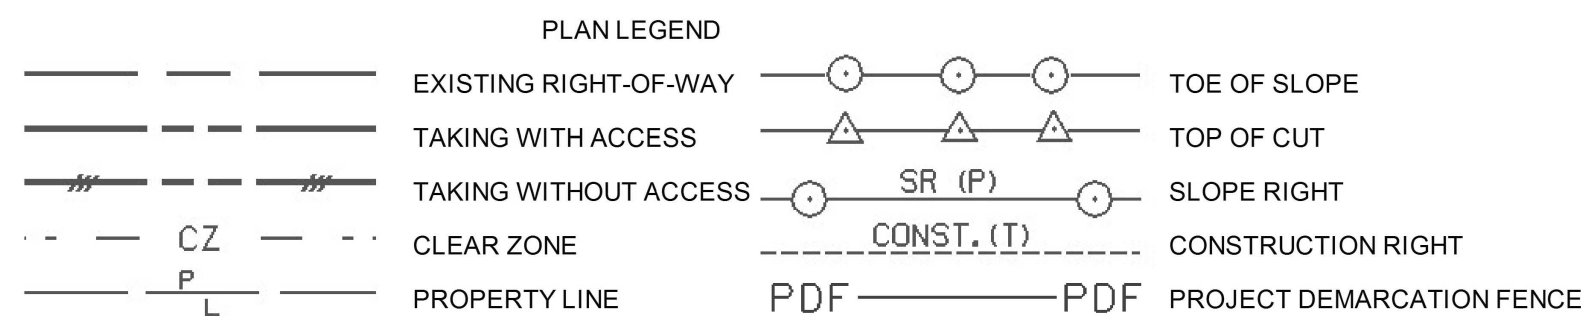

- EC -EROSION CONTROL
- (P) -PERMANENT
- (T) -TEMPORARY
- DR. -DRAINAGE RIGHT
- DIT. -DITCHING RIGHT
- CH. -CHANNEL RIGHT
- DRIVE -DRIVE RIGHT
- CUL. -CULVERT RIGHT
- C&T -CLEARING & TRIMMING RIGHT
- SR -SLOPE RIGHT
- UE -UTILITY EASEMENT

APPROVED: HARRY PETROVS DATE: 02-01-10  
CHIEF, PLANS & TITLES

PLOT DATE 08/03/10

PROJECT NAME:	<b>RICHMOND</b>	PLOT DATE:	Date
PROJECT NUMBER:	<b>STP-RS 0284(11)</b>	DRAWN BY:	MT
FILE NAME:	90c092 Detail.xls	CHECKED BY:	EP
PROJECT LEADER:	R. WHITCOMB	SHEET	19 OF 24
DESIGNED BY:	C. CARLSON		
R.O.W. DETAIL SHEET #1			