


Research Drawer Set

STATE OF VERMONT
AGENCY OF TRANSPORTATION



PROPOSED IMPROVEMENT
TOWN OF BRISTOL
COUNTY OF ADDISON
VERMONT ROUTE 116 (FAP)

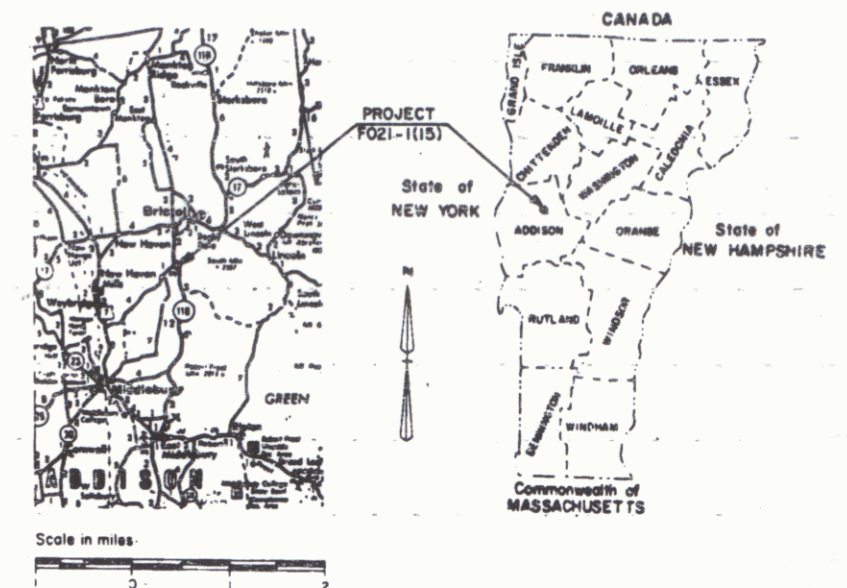

R.O.W. PLANS
(16)

These plans are for highway Project
Bristol FO21-1(16)S. Work performed
was Channel work only.

*not
conducted
channel work
only*


RIGHT-OF-WAY DIVISION
TOWN FILE

MM 0311-0327

PERPETUAL

Town of BRISTOL Vt. Route 116
(To Be Returned To R.O.W. Division)

Date: 01/01/1987
Pw: 91B098

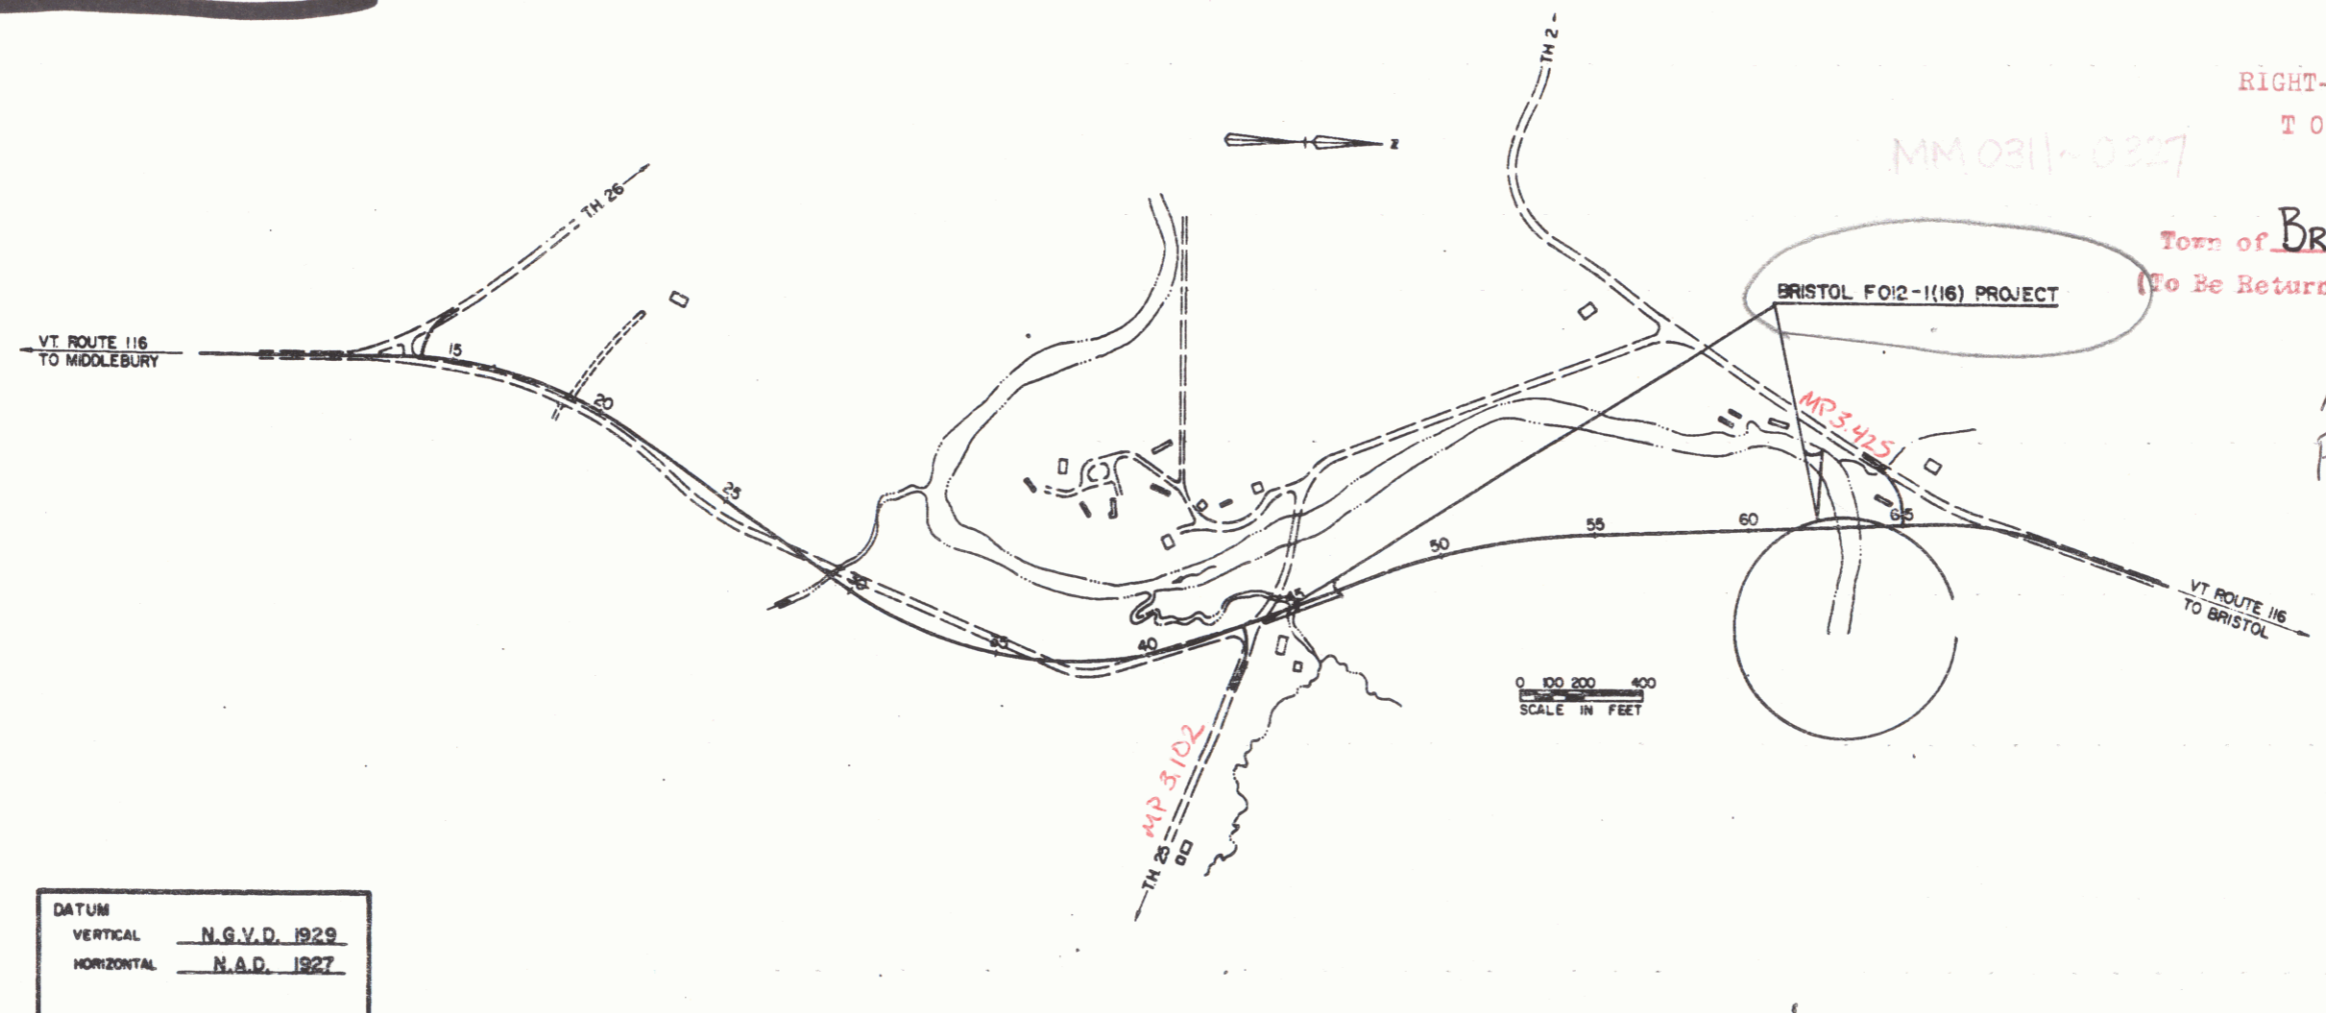

CONVENTIONAL SIGNS

COUNTY LINE	---
TOWN LINE	- - - -
LIMITS OF ACCESS	○ ○ ○ ○
POINT OF ACCESS	X
FENCE LINE	— · — ·
STONE WALL	— · — · — ·
TRAVELED WAY	· · · · ·
GUARD RAIL	— · — · — ·
RAILROAD	— · — · — ·
SURVEY LINE	— · — · — ·
CULVERT	— · — · — ·
POWER POLE	○
TELEPHONE POLE	○
TREES	○
CONTROL OF ACCESS	— · — ·
PROPERTY LINE	— · — ·
R.O.W. TAKING LINE	— · — ·
SLOPE RIGHTS	○ — · — · ○
TOP OF CUT	○ — · — · ○
TOE OF SLOPE	○ — · — · ○

DATUM
VERTICAL N.G.V.D. 1929
HORIZONTAL N.A.D. 1927

MAY 02 1994

PROJECT **BRISTOL FO21-1(16)**
SHEET **1** OF 5 SHEETS

D-10 SAS 12/17/70