


HIGHWAY LIMIT / LOCATION

RELOCATE MAILBOX, SINGLE SUPPORT
MM 2.024, RT. (2)

*Not to be used
for R.O.W. Plans*

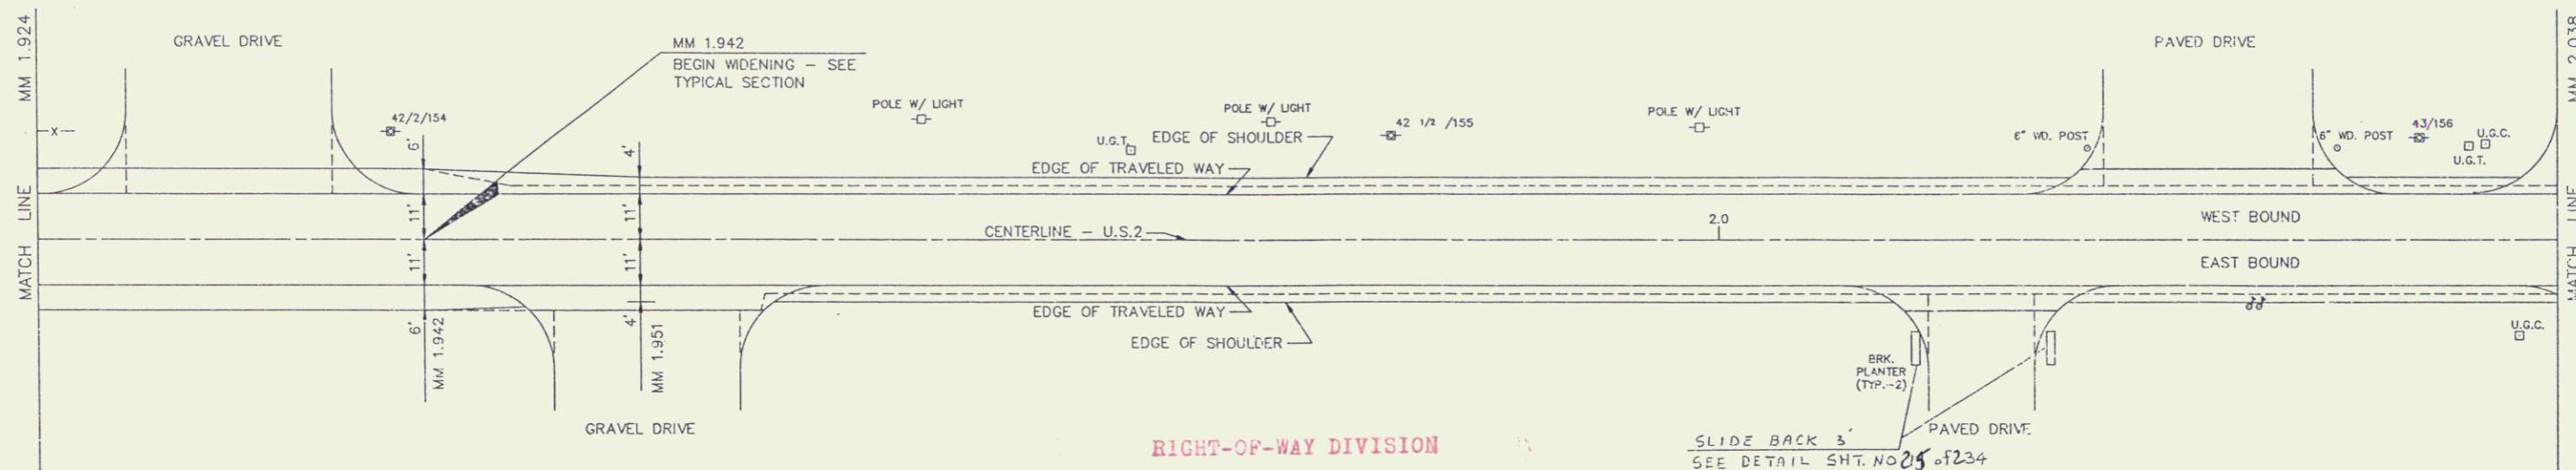

RIGHT-OF-WAY DIVISION
TOWN FILE

PERPETUAL
Town of Bolton U.S. Rte 2
(To Be Returned To R.O.W. Division)

LEBEAU, DON & SANDRA

Pin # 916249
MP 1.924 - 2.379
2.606 - 2.688

NOTE: ALL LOCATIONS ARE REFERENCED TO MILE MARKER 0.800.


REMOVING LARGE STUMPS
MM 2.143, RT.

RELOCATE MAILBOX, SINGLE SUPPORT

MM 2.076, RT.
MM 2.100, RT.

RELOCATE MAILBOX, MULTIPLE SUPPORT

MM 2.060, RT.
MM 2.133, RT.

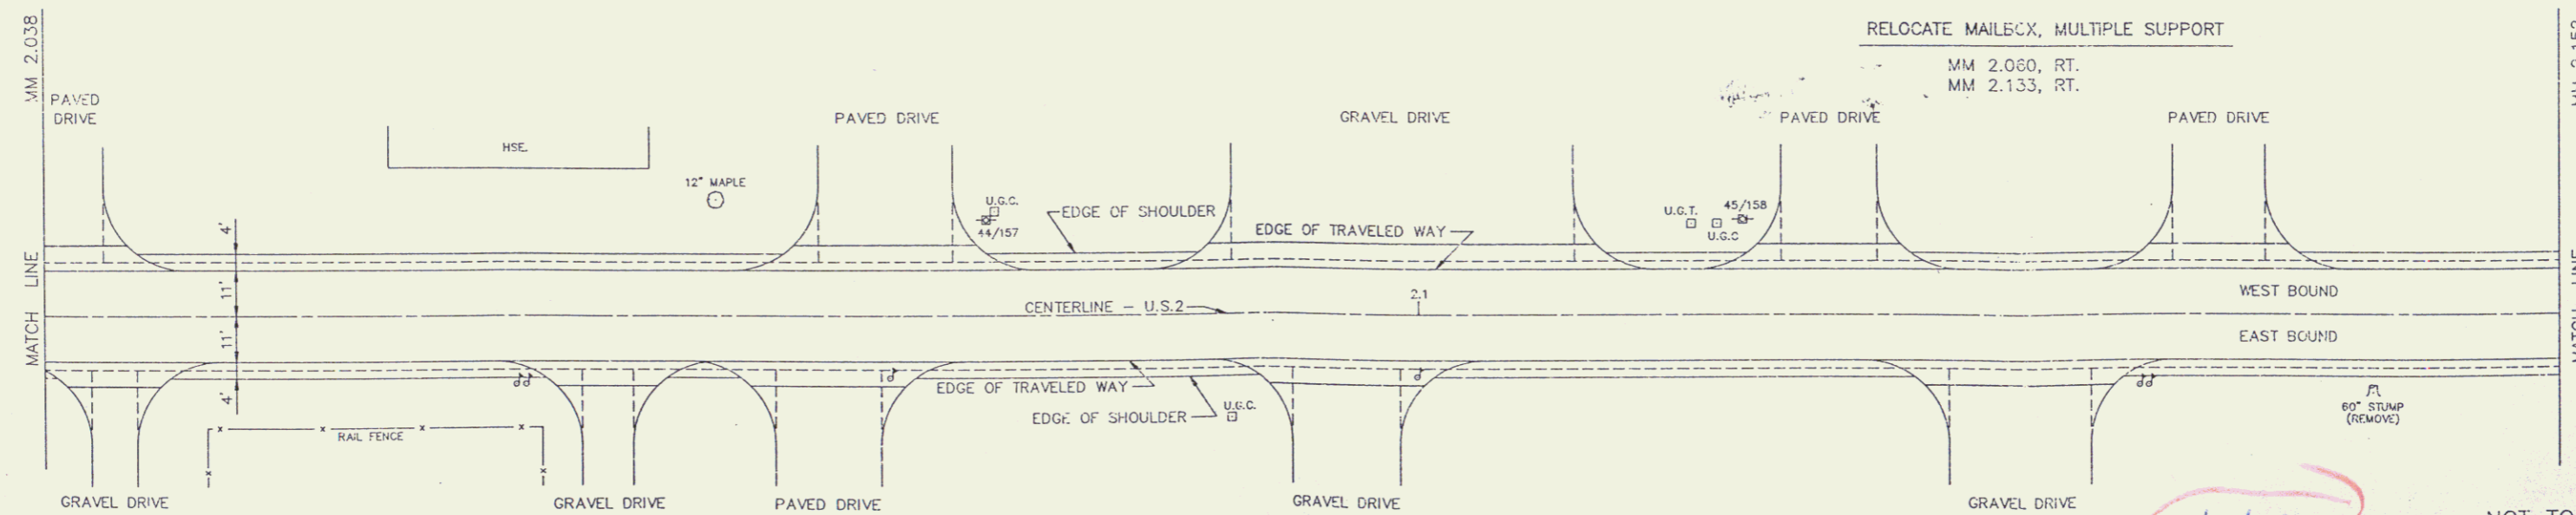

DATUM	
VERTICAL	N/A
HORIZONTAL	N/A

FOR REFERENCE ONLY
FOR

02/01/92
JAN 27 1993

NOT TO SCALE

NOTE: ALL LOCATIONS ARE REFERENCED TO MILE MARKER 0.800.

DRAWN BY DMC DATE 02/92
PROJ. NAME BOLTON - U.S. 2
PROJ. NO. **CHRS 0234(15)**
SHEET **212** OF 234 SHEETS