

PULL BOXES
 STA. 4+70 35' RT.

**WIRED CONDUIT (1 1/2\"/>
 LOOP #2 TO PULL BOX
 LOOP #8 TO PULL BOX
 LOOP #4 TO SIGNAL POLE #1
 LOOP #6 TO SIGNAL POLE #1**

**WIRED CONDUIT (2\"/>
 PULL BOX TO SIGNAL POLE #2**

**WIRED CONDUIT (2 1/2\"/>
 GMP 29/NET 170 UTILITY POLE (KT. NT. TO GRND.)
 GMP 29/NET 170 UTILITY POLE TO STRAIN POLE
 OUTSIDE OF STRAIN POLE TO METER & DISCONNECT**

DATUM
 VERTICAL _____
 HORIZONTAL _____


03-29-93 REVISION NO. 3
 01-18-93 REVISION NO. 2
 09-05-92 REVISION NO. 1
 03-8079 1805 858021 REW

PROPOSED TRAFFIC SIGNAL PLAN

SURVEYED _____ DATE _____
 DRAWN BY _____ DATE _____
 TRACED BY _____ DATE _____

WILLISTON
 MG SGNL(3)S
 R.O.W. SHEET 3 OF 3 SHEETS

AUG 2 1994

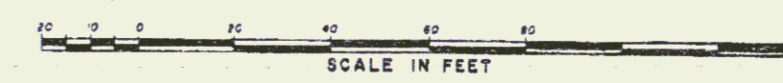

3