

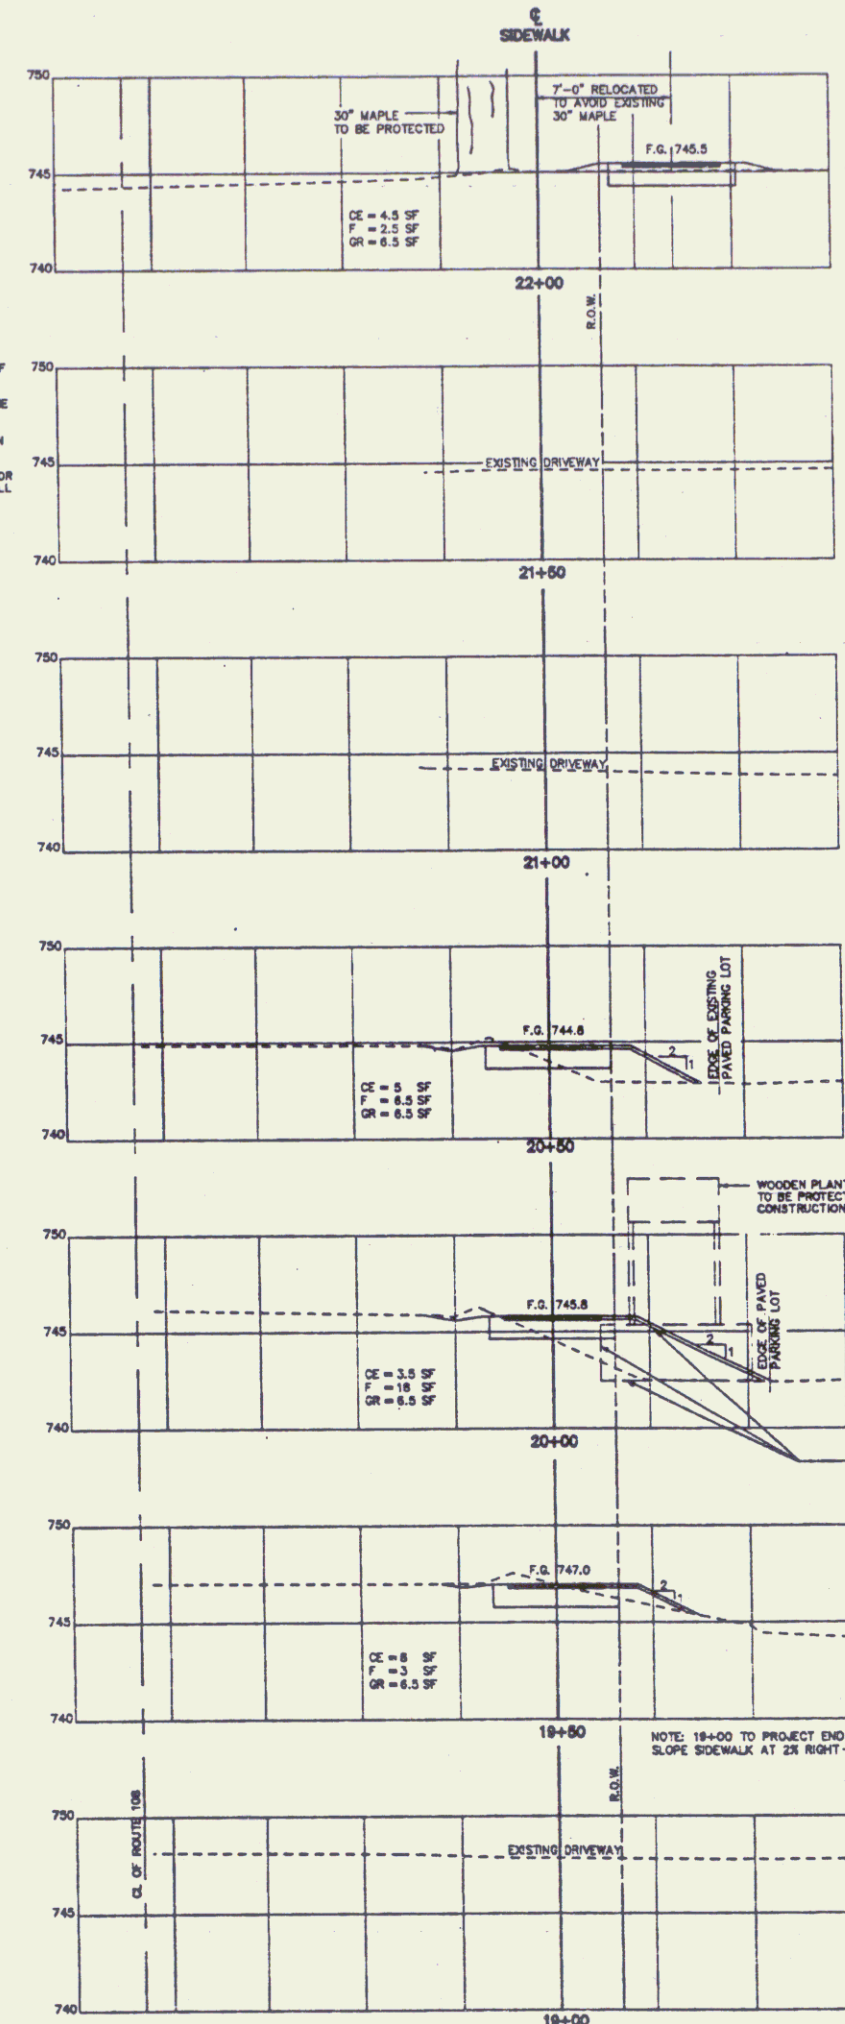


THE CONTRACTOR SHALL EXCAVATE A BENCH ALONG THE EDGE OF THE RIGHT OF WAY TO ALLOW OWNERS OF FRONT FOUR SPORTS TO CONSTRUCT A SMALL STONE RETURNING WALL. THE OWNERS AGREE TO COORDINATE CONSTRUCTION OF THE WALL WITH THE SIDEWALK CONSTRUCTION SCHEDULE. THE CONTRACTOR SHALL REED AND MOUND ALL DISTURBED GROUND AFTER THE WALL IS FINISHED.

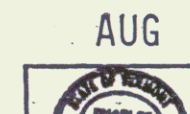

THE CONTRACTOR SHALL PLACE FILL AROUND THE SMALL WOODEN PLANTER. THE CONTRACTOR SHALL USE PRESSURE TREATED LAMBER AS REQUIRED TO REINFORCE THE PLANTER AND TO ADD A TOP BEAM IF NECESSARY BECAUSE OF GRADE CONSIDERATIONS. THE WORK SHALL BE COORDINATED WITH THE OWNER AND THE VILLAGE.

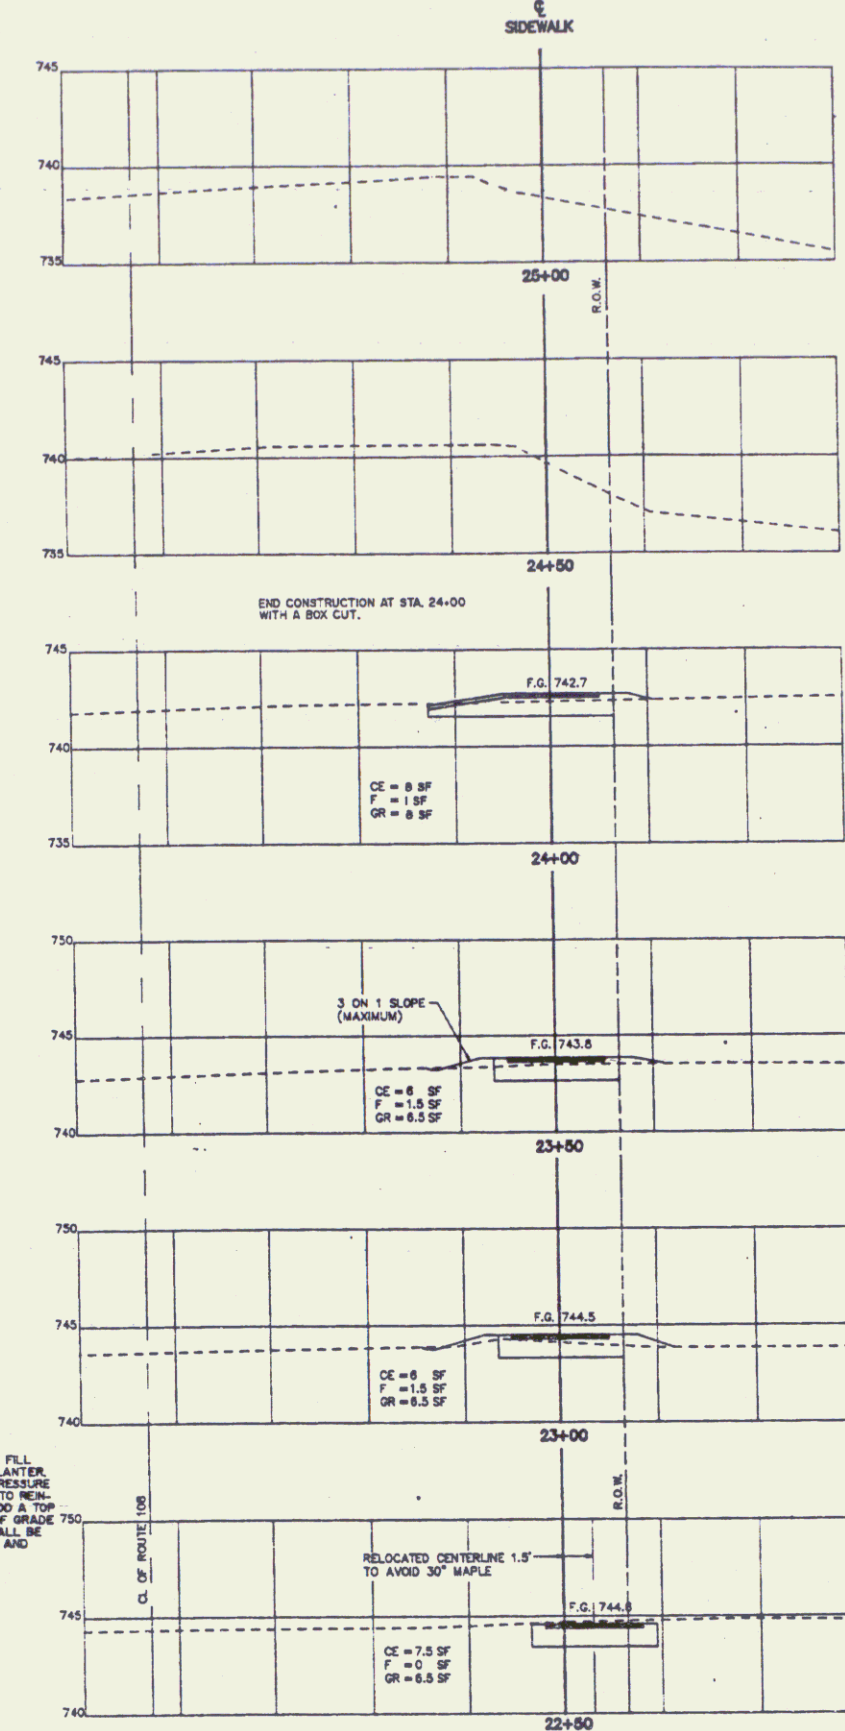

AUG 9 1994

"SECTIONS 15+00 TO 25+00" STOWE MOUNTAIN ROAD WALK

SHEET 8

10

JUN 30 1992

PROJECT BW-RS-BIKE