

TIE DISTANCE TABLE


STATION	DESC.	TIE #	DISTANCE	DESCRIPTION	HEIGHT ABOVE GRND.	REMARKS
0+00	A CONC. NAIL	A1 A2 A3	84.4' 18.8' 22.0'	NAIL CL. END WOOD BRIDGE SW CORNER BUILDING TRIM SW CORNER TRIM STAIR RAIL POST	1' 1.2' 0.5'	ABOVE RET. WALL
1+12.83	B SPIKE	B1 B2 B3	25.71' 21.12' 37.81'	NW CORNER GARAGE TRIM NAIL IN 4"x4" LIGHT POST SW CORNER BUILDING TRIM	3.5' 1.3' 1'	EDGE W/ TRIM CLAPBOARD OR FRONT ABOVE TOP CONC. FOUNDATION
2+00.48	C SPIKE	C1 C2 C3	27.71' 22.12' 56.02'	NW CORNER PORCH TRIM NW CORNER BUILDING TRIM NW CORNER BUILDING TRIM	1.5' 1.5' 2.7'	
2+42.06	D CONC. NAIL	D1 D2 D3	57.73' 52.92' 45.27'	CORNER BUILDING TRIM CORNER BUILDING TRIM NAIL IN 1ST LIGHT POST	3.5' 4.7' 3.5'	
3+33.09	E NAIL IN HUB	E1 E2 E3	8.53' 4.46' 8.48'	CL. END BOTTOM BOLT G.R. POST 5 CL. END BOTTOM BOLT G.R. POST 6 CL. END BOTTOM BOLT G.R. POST 7	1.5' 1.5' 1.5'	PAINTED RED PAINTED RED PAINTED RED
6+82.37	F SPIKE	F1 F2 F3	55.34' 11.18' 40.05'	CL. END BOTTOM BOLT LAST G.R. POST NAIL IN 30" WHITE PINE CORNER BUILDING WALL TRIM	1.5' 2.2' 0.5'	PAINTED RED ABOVE PORCH
8+44.01	G SPIKE	G1 G2 G3	22.53' 11.22' 56.28'	TOP CORNER CONCRETE FOUNDATION NAIL IN SIGN POST NAIL IN SIGN POST	1.5' 1.5' 1.5'	
11+51.14	H SPIKE	H1 H2 H3	31.84' 23.00' 27.28'	CORNER CONCRETE FOUNDATION CORNER CONCRETE FOUNDATION CORNER CONCRETE FOUNDATION	0.5' 0.5' 0.5'	
11+88.78	I NAIL IN HUB	I1 I2 I3	88.71' 29.90' 52.53'	CORNER CONCRETE FOUNDATION NAIL IN 11" MAPLE CORNER BOTTOM OF 2ND ROW OF BRICK	0.5' 2.5' 2.5'	
12+37.32	J NAIL IN HUB	J1 J2 J3	51.56' 53.73' 34.77'	NAIL IN 11" MAPLE CORNER OF MIDDLE OF 8TH ROW OF BRICK NAIL IN 8" MAPLE	2.5' 2.5' 2.5'	BASE AS IS
13+32.23 13+31.89	K CONC. NAIL	K1 K2 K3	57.35' 48.30' 38.43'	CORNER BUILDING TRIM CORNER BUILDING TRIM CORNER CONCRETE RAMP WALL	1.5' 1.5' 1.5'	

TANGENT LINE BEARINGS

STATION	TIE #	BEARING	DISTANCE
0+00 TO 1+12.83	A TO B	N 17°25'28" W	112.83'
1+12.83 TO 1+88.88	B TO 1+88.88	N 17°25'28" W	47.02'
1+88.88 TO 2+00.48	1+88.88 TO C	N 34°17'57" E	47.02'
2+00.48 TO 2+42.06	C TO D	N 34°17'57" E	41.57'
2+42.06 TO 3+33.09	D TO E	N 42°40'11" E	91.03'
3+33.09 TO 6+82.37	E TO F	N 48°54'43" E	348.28'
6+82.37 TO 8+44.01	F TO G	N 44°08'40" E	181.84'
8+44.01 TO 11+51.14	G TO H	N 41°28'43" E	307.13'
11+51.14 TO 11+88.78	H TO I	N 38°14'48" E	47.82'
11+88.78 TO 12+37.32	I TO J	N 35°10'08" E	38.57'
12+37.32 TO 13+32.23	J TO K	N 18°10'08" E	100.81'

SITE PLAN

GRAPHIC SCALE

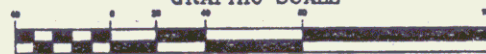

AUG 9 1994

SHEET 9



"TIE DETAIL SHEET 0+00 TO 13+00"
STOWE MOUNTAIN ROAD WALK