


NOTE: SEE SHEET 13 AND 14 FOR DETAILS OF EACH SIGN.

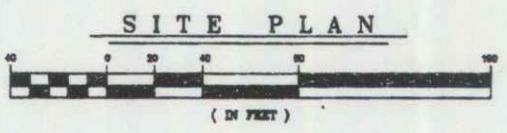

AUG 9 1994

JUN 30 1992
PROJECT
BW-RS-BIKE (25)

	TOWN OF STOWE - RIVER WALK "SIGN LOCATION PLAN"		DATE 8-9-94 DRN BY T.J.M. SCALE A=1"=40' SHT 13 OF 30
	CHARLES GRENIER CONSULTING ENGINEER, P.C. BOX 445, WATERBURY, VERMONT 244-8413		