


# RIGHT - OF - WAY DETAIL SHEET

TABLE OF PROPERTY ACQUISITION

PARCEL NO.	PROPERTY OWNER	SHEET NO.	BEGINNING STATION	ENDING STATION	TAKE	REMAINDER	RIGHT			RECORDING DATA				REMARKS		
					AREA±	AREA±	TYPE	(T)(P)	AREA ±	TITLE	DATE	TOWN / CITY	BOOK		PAGE	
1	NOT USED															
2	MASON, PETER M. & TONYA M.	25,26	102+46 LT 102+51 LT 102+75 LT 102+74 LT 102+98 LT 103+38 LT 104+31.22 LT 104+48 LT	104+07 LT 103+46 LT 103+31 LT 103+13 LT 102+98 LT 104+50 LT 104+50 LT			CONST. SLOPE INSTALL & MAINTAIN REMOVE DRAINAGE UTILITY DRIVE INSTALL	(T) (T) (P) (T) (P) (P) (T) (T)	1,644 SF 1,676 SF 463 SF 237 SF 10 SF	WD	11/02/10	MILTON	397 175	175	INCLUDES PDF / BF CULVERTS, HEADWALLS & STONE DITCH HEADWALL MUNICIPAL WATER SYSTEM 15.9' GRAVEL MM 5887 PDF	
3A	RITCHIE, LAURIE J. & JOHN L.	26	104+49 LT 104+49 LT 104+83.50 LT 105+01 LT 105+87.17 LT 106+30 LT 106+51 LT 106+52 LT 107+00 LT TH 3 300+86 LT TH 3 301+10 LT TH 3 300+86 LT TH 3 301+40 LT TH 3 301+76.70 LT	106+18 LT 104+62 LT 106+65 LT 106+60 LT 106+52 LT 107+09 LT TH 3 301+90 LT TH 3 301+77 LT TH 3 301+77 LT TH 3 301+77 LT TH 3 301+77 LT TH 3 301+77 LT			UTILITY INSTALL DRIVE INSTALL DRIVE REMOVE & RESET D & C SLOPE INSTALL CONST INSTALL & MAINTAIN SLOPE REMOVE REMOVE & REPLACE	(P) (T) (T) (T) (T) (T) (T) (T) (T) (T) (P) (P) (T) (T) (T)	921 SF 92 SF 536 SF 48 SF 44 SF 118 SF	OPTION	02/28/11	MILTON	402 169	169	MUNICIPAL WATER SYSTEM PDF 16.7' GRAVEL MM 5897 PDF 23.7' GRAVEL MM 5916 FENCE WATER SERVICE PDF INCLUDES PDF RETAINING WALL INCLUDES PDF FENCE IRON PIPE	
3B		26	106+45.05 LT	107+32.18 LT	2,533 SF			ALL R.T. & I.								U.S. RTE. 7 & TH 3 HWY. EASE
4	GARROW, PAUL G. & TINA M.	26,28	TH 3 301+76.70 LT TH 3 301+77 LT TH 3 301+77 LT TH 3 301+77 LT TH 3 302+54 LT TH 3 303+00 LT TH 3 303+15 LT TH 3 303+37.16 LT TH 3 303+60 LT TH 3 303+80 LT TH 3 303+89.57 LT	TH 3 303+08 LT TH 3 302+60 LT TH 3 302+52 LT TH 3 303+21 LT TH 3 303+18 LT TH 3 303+90 LT TH 3 303+90 LT TH 3 303+89.90 LT			REMOVE & REPLACE SLOPE INSTALL & MAINTAIN REMOVE REMOVE INSTALL D & C DRIVE INSTALL SLOPE REMOVE & REPLACE	(T) (T) (P) (T) (T) (T) (T) (T) (T) (T) (T)	250 SF 160 SF 9 SF 110 SF 14 SF	WD	10/12/10	MILTON	396 239	239	IRON PIPE INCLUDES PDF RETAINING WALL HEDGE LLAC PDF WATER SERVICE 16.0' GRAVEL PDF IRON PIPE	
5	NADEAU, CHRISTOPHER A. & ALLYSON B.	28	TH 3 303+89 LT TH 3 303+89 LT TH 3 303+89.57 LT	TH 3 304+68 LT TH 3 304+61 LT TH 3 303+89.90 LT			INSTALL SLOPE REMOVE & REPLACE	(T) (T) (T)	378 SF 278 SF	GTR	08/30/10	MILTON	394 233	233	PDF & TPZ INCLUDES TPZ IRON PIPE	
6	JOHNSON, EBENEZER W. JR. & CAROL J.	28	TH 3 303+85.78 RT				DRIVE	(T)		GTR	08/30/10	MILTON	394 231	231	22.7' GRAVEL	

TABLE OF REVISIONS

REVISION NO.	SHEET NO.	DESCRIPTION	DATE
1	23, 25	PARCEL NO. 11 HEIRS OF MURETTA KILBURN. REVISED END STATION OF TAKE AREA. PER C.O. 9601 MADE BY: MT APPROVED BY: HP	02/16/10
2	24	PARCEL NO. 13 CENTRAL VERMONT PUBLIC SERVICE CORPORATION. REVISED AREA OF DITCH & DRAINAGE EASEMENT ON DETAIL SHEET. PER C.O. 9602 MADE BY: MT APPROVED BY: HP	02/16/10
3	25	PARCEL NO. 11 HEIRS OF MURETTA KILBURN. REVISED FOOTAGE BETWEEN STATION 99+29.46 AND 102+93.02. PER C.O. 9605 MADE BY: MT APPROVED BY: HP	02/26/10

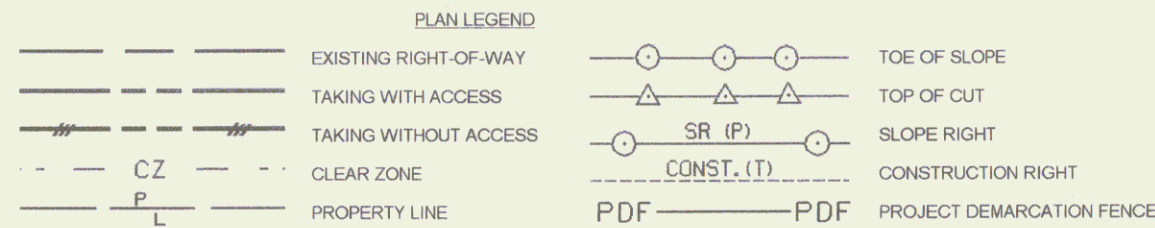

- BF - BARRIER FENCE
- D & C - DISCONNECT & CONNECT
- EC - EROSION CONTROL
- (P) - PERMANENT
- (T) - TEMPORARY
- DR - DRAINAGE RIGHT
- DIT - DITCHING RIGHT
- CH - CHANNEL RIGHT
- DRIVE - DRIVE RIGHT
- CUL - CULVERT RIGHT
- C&T - CLEARING & TRIMMING RIGHT
- SR - SLOPE RIGHT
- UE - UTILITY EASEMENT

APPROVED: HARRY PETROVS DATE: 01/29/10  
CHIEF, PLANS & TITLES

PLOT DATE 03/23/11

PROJECT NAME: MILTON  
PROJECT NUMBER: STP 5800 (2)  
FILE NAME: r 92d289 detail sheet.xls  
PROJECT LEADER: J. SHULTZ  
DESIGNED BY: D. LYMAN  
R.O.W. DETAIL SHEET #1

PLOT DATE:  
DRAWN BY: M.R.  
CHECKED BY: E.P.  
ROW SHEET 22 OF 28