



STATE OF VERMONT  
AGENCY OF TRANSPORTATION

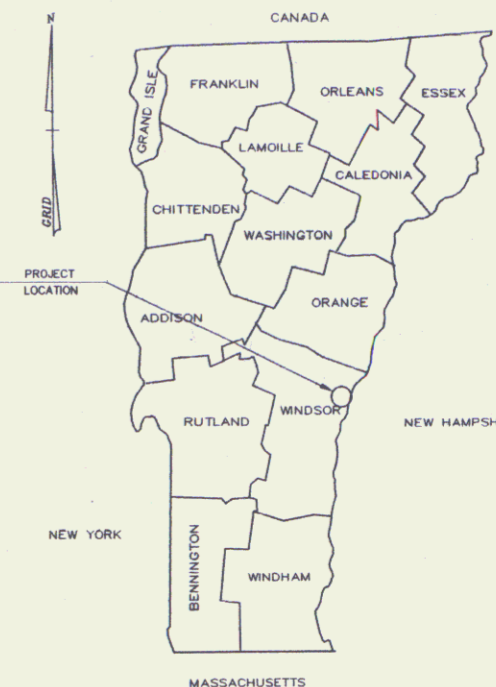

PROPOSED IMPROVEMENT  
**TOWN OF HARTFORD**  
COUNTY OF WINDSOR  
HARTFORD TRANSPORTATION PATH

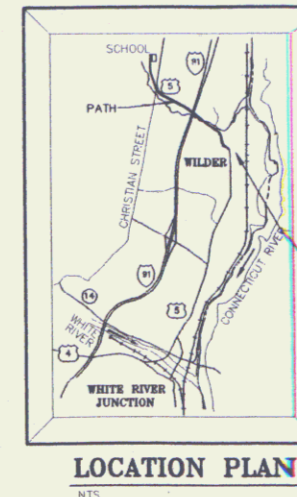

**INDEX OF SHEETS**


- 1. TITLE SHEET
- 2. TYPICALS
- 3-4. DETAIL SHEETS
- 5-11. PLAN SHEETS

WILDER: BEGINNING NEAR THE INTERSECTION OF GILLETTE STREET AND U.S. ROUTE 5 AND EXTENDING WESTERLY ALONG U.S. ROUTE 5 APPROXIMATELY 1.75 km TO THE PLAY AREA OF THE SCHOOL ON CHRISTIAN STREET. INCLUDED IN THE WILDER SECTION IS APPROXIMATELY 0.26 km OF ROAD IMPROVEMENTS AT THE INTERSECTION OF CHRISTIAN STREET AND HARTFORD AVENUE.

WORK TO BE PERFORMED UNDER THIS PROJECT INCLUDES GRADING, DRAINAGE, SUBBASE, PAVEMENT, FENCING, SIGNING, MARKINGS, LIGHTING, BRIDGE, CONCRETE RETAINING WALLS AND RELATED ITEMS FOR AN URBAN TRANSPORTATION PATH.

TOTAL LENGTH OF PROJECT IS 2.01 km  
TOTAL LENGTH OF BRIDGE IS 0.0152 km  
TOTAL LENGTH OF PATH IS 1.74 km  
TOTAL LENGTH OF CHRISTIAN ST IMPROVEMENTS IS 0.26 km  
TOTAL LENGTH OF R-O-W PROJECT IS 1.74 km  
DESIGN SPEED IS 30 km/h.

END R-O-W PROJECT  
STP BIKE (8) STA 1+757.7 LT

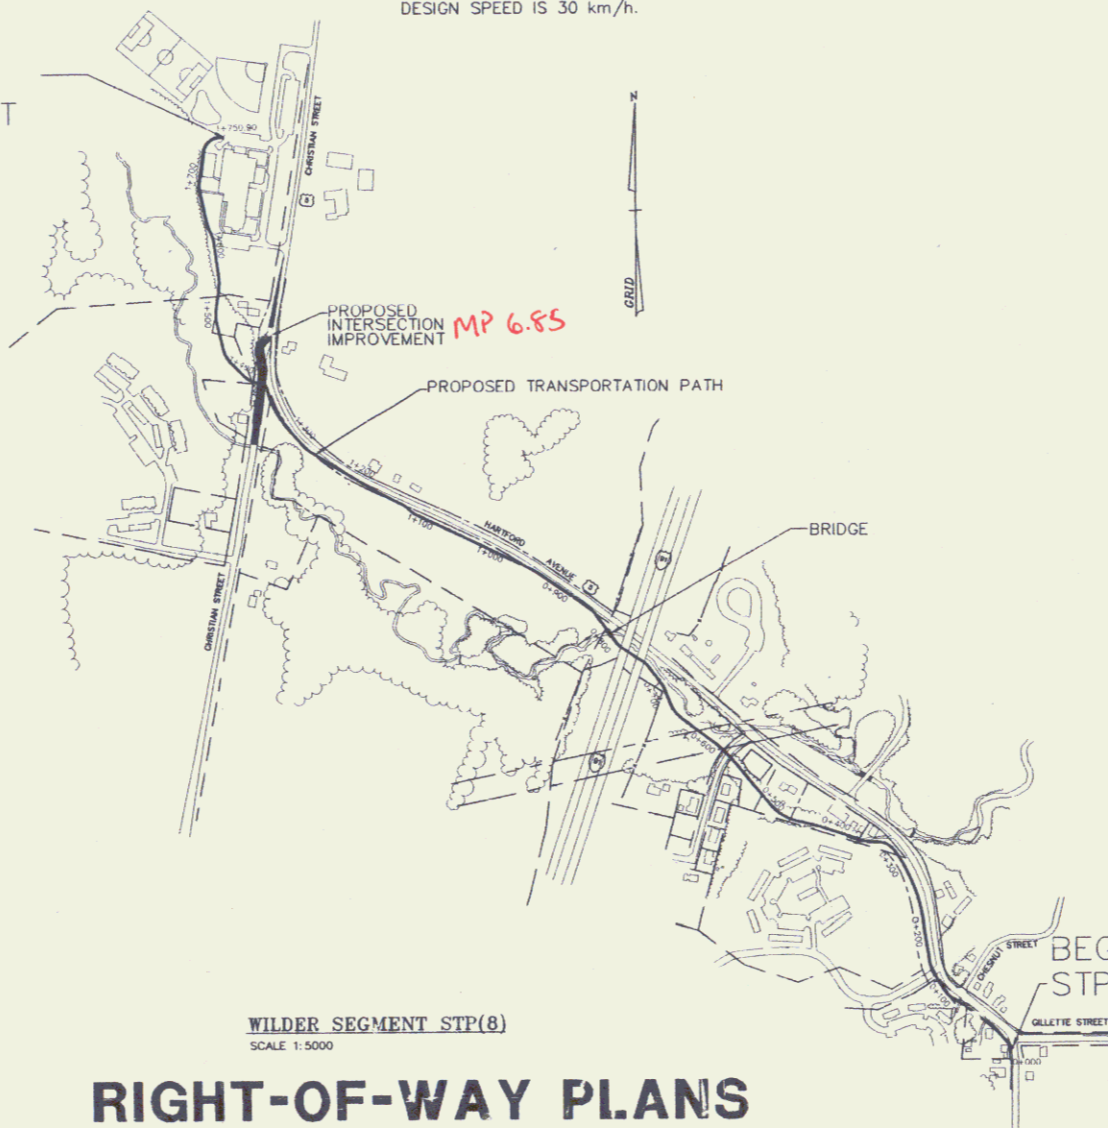

LINES SHOWN ON THIS PLAN AS EXISTING PROPERTY LINES (P/L) ARE BELIEVED TO BE ACCURATE BUT SHOULD NOT BE RELIED UPON FOR PURPOSES UNRELATED TO THE STATE OF VERMONT'S ACQUISITION OF LAND AND RIGHTS FOR THIS PROJECT.

WILDER SEGMENT STP(8)  
SCALE 1:5000

**RIGHT-OF-WAY PLANS**

BEGIN R-O-W PROJECT  
STP BIKE (8) STA 0+019.0 LT  
MP 5.96

DATUM  
VERTICAL NAVD 1927  
HORIZONTAL N/A

**Metric**

THESE PLANS ARE SUBJECT TO SUCH ENGINEERING CHANGES AS MAY BE REQUIRED BY THE FEDERAL HIGHWAY ADMINISTRATION OR THE CHIEF ENGINEER. CONSTRUCTION IS TO BE CARRIED ON IN ACCORDANCE WITH THESE PLANS AND THE STANDARD SPECIFICATIONS FOR CONSTRUCTION DATED 1995, AS APPROVED BY THE FEDERAL HIGHWAY ADMINISTRATION ON AUGUST 21, 1995 FOR USE ON THIS PROJECT, INCLUDING ALL SUBSEQUENT REVISIONS AND SUCH REVISED SPECIFICATIONS AND SPECIAL PROVISIONS AS ARE INCORPORATED IN THESE PLANS.

P.O.# 92K296  
Proj # STP BIKE(8)

NOV 02 2001



LAMOUREUX, STONE & O'LEARY  
Consulting Engineers Inc.  
14 Morse Drive  
Essex Junction, VT 05452  
(802) 878-4450  
Engineers-Planners-Surveyors

SUBMITTED BY ORDER OF THE STATE TRANSPORTATION BOARD  
APPROVED: [Signature] DATE 12/19/96  
DIRECTOR OF ENGINEERING

APPROVED: [Signature] DATE 12/17/96  
CHIEF OF RIGHT-OF-WAY

PROJECT: HARTFORD STP BIKE (8) N# 93070  
R.O.W. SHEET 1 OF 10