

TABLE OF PROJECT PROPERTY ACQUISITION


PARCEL NO.	GRANTOR	SHEET NO.	BEGINNING STATION	ENDING STATION	TAKING	RIGHTS	TITLE TAKEN	DATE	TOWN OR CITY RECORDED	BOOK	PAGE	REMARKS
6A	UVM	10, 11	3+328.5 LT	3+332.5 LT		CUL.DIT.& DR.(3 SM)(32 SF) (P)			SO. BURLINGTON			
			3+305 RT	3+324 RT		CUL.& DIT.(31 SM)(334 SF) (P)						
			3+380 LT	3+390 LT		CUL.DIT.& DR.(34SM)(366SF) (P)						
			3+380 RT	3+412 RT		CUL.& DIT.(44 SM)(474 SF) (P)						
			3+307 RT	3+417 RT		SLOPE (19 SM) (205 SF) (T)						
			3+300 LT	3+314 LT		LANDSCAPING (T)						
			3+298.5 RT	3+455 RT		CONST.(352 SM)(3789 SF) (T)						

REVISION NO.	SHEET NO.	DESCRIPTION OF REVISION	DATE	BY
3		UPDATED PER CONSTRUCTION PLAN INFORMATION	9/1/99	
2		REVISED NOTE TO CITY OF SOUTH BURLINGTON	4/9/99	
1		REVISED RIGHT-OF-WAY DIMENSIONAL INFORMATION	4/1/98	

DR. (P) - DRAINAGE RIGHT
DIT.(P) - DITCHING RIGHT
CH.(P) - CHANNEL RIGHT
DRIVE (T) - DRIVE RIGHT
CUL.(P) - CULVERT RIGHT
LR.(T) - LANDSCAPING RIGHT

--- EXISTING R.O.W.
--- TAKING WITHOUT ACCESS
--- TAKING WITHOUT ACCESS ALONG PROPERTY LINE
--- TAKING WITH ACCESS
(P) PERMANENT EASEMENT
(T) TEMPORARY EASEMENT

--- CZ (P) --- CLEAR ZONE
--- CONST. (T) --- CONSTRUCTION EASEMENT
--- SR --- SLOPE RIGHTS
--- P --- PROPERTY LINE
--- TOP OF CUT
--- TOE OF SLOPE

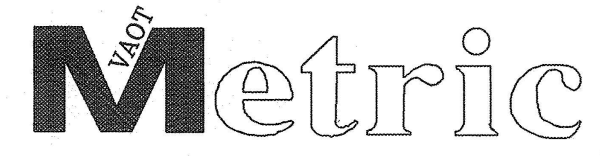

<p>DESIGNED: DFH DRAWN: DFH CHECKED: LDY SCALE: 1:500 HORIZ.</p>	<p>PEA PINKHAM ENGINEERING ASSOCIATES, INC. 50 Joy Drive • P.O. Box 2225 South Burlington, VT 05407-2225</p>	<p>R.O.W. PLANS SOUTH BURLINGTON TRANSPORTATION PATH STP BIKE (6) SOUTH BURLINGTON, VERMONT</p>	<p>DATE: 8/18/97 DRAWING NO.: SHEET 10 OF 15 PROJECT NO.: 7091</p>
--	--	---	--